


- LEGEND:**
- ① LANE LINE
 - ② 8" SOLID WHITE


- LEGEND**
- ≡ PORTABLE PRECAST CONCRETE BARRIER RAIL
 - ⊗ TEMPORARY IMPACT ATTENUATOR (70 KMH)
 - ▶ TEMPORARY CONSTRUCTION SIGN
 - ▶ TRAFFIC DRUM AT 9.0m SPACING W/TYPE B FLASHERS
- TEMPORARY PAVEMENT DELINEATION LEGEND**
- ① 200mm SOLID WHITE LINE
 - ② 200mm WHITE LANE LINE

SECTION A-A

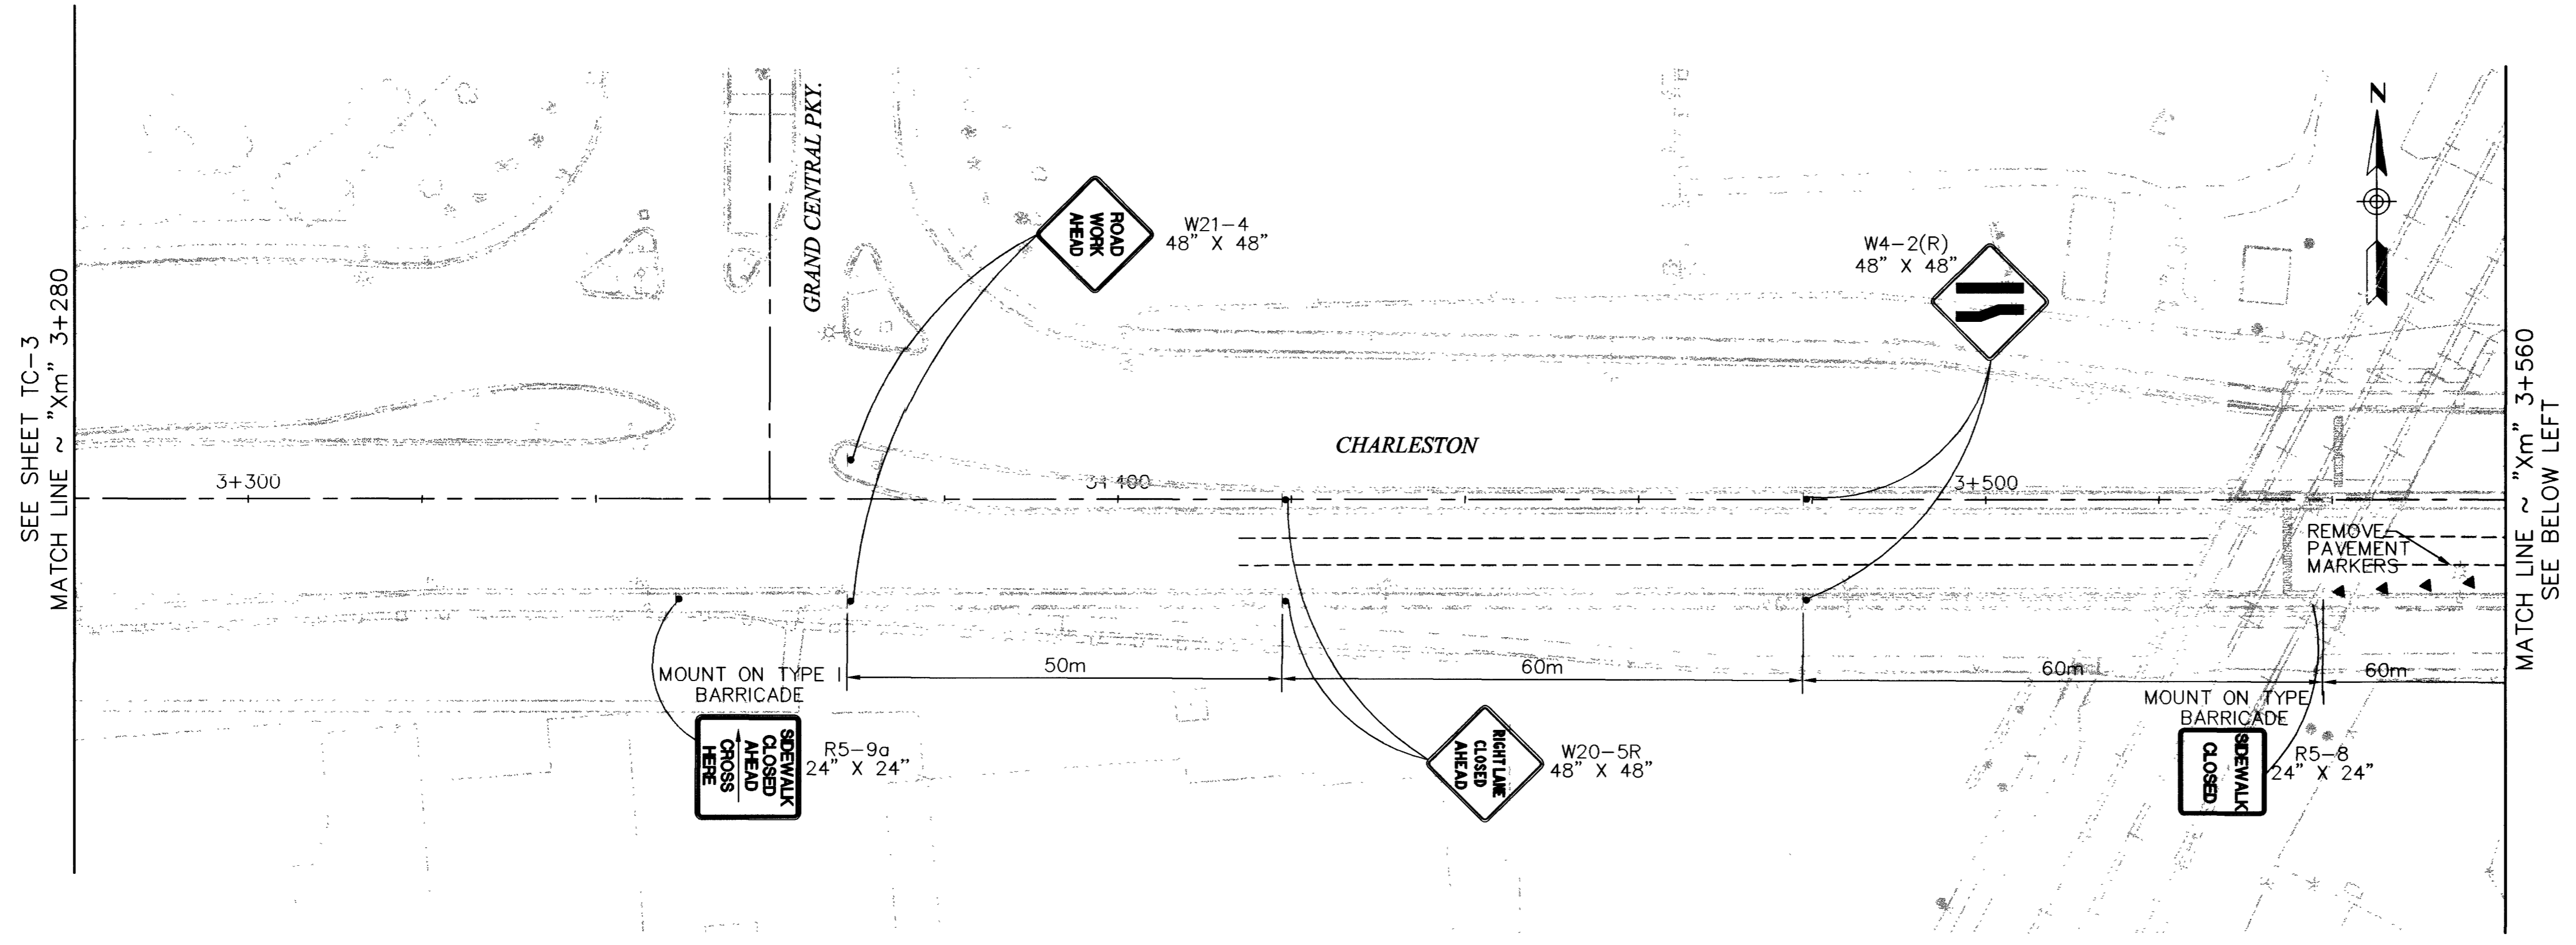

NOTE:
 THE FOLLOWING CROSS STREETS:
 COMMERCE ST, MAIN ST, AND CASINO
 CTR SHALL NOT BE CLOSED AT THE
 SAME TIME.
 ONLY ONE CROSS STREET CLOSURE AT
 A TIME WILL BE ALLOWED AND ONLY
 DURING WORK HOURS.

<p>Call before you Dig. 1-800-277-2600</p> <p><small>UNDERGROUND SERVICE (USA)</small></p>	<p>Call before you Overhead 563-6111</p> <p><small>OVERHEAD SERVICE (USA)</small></p>
--	---

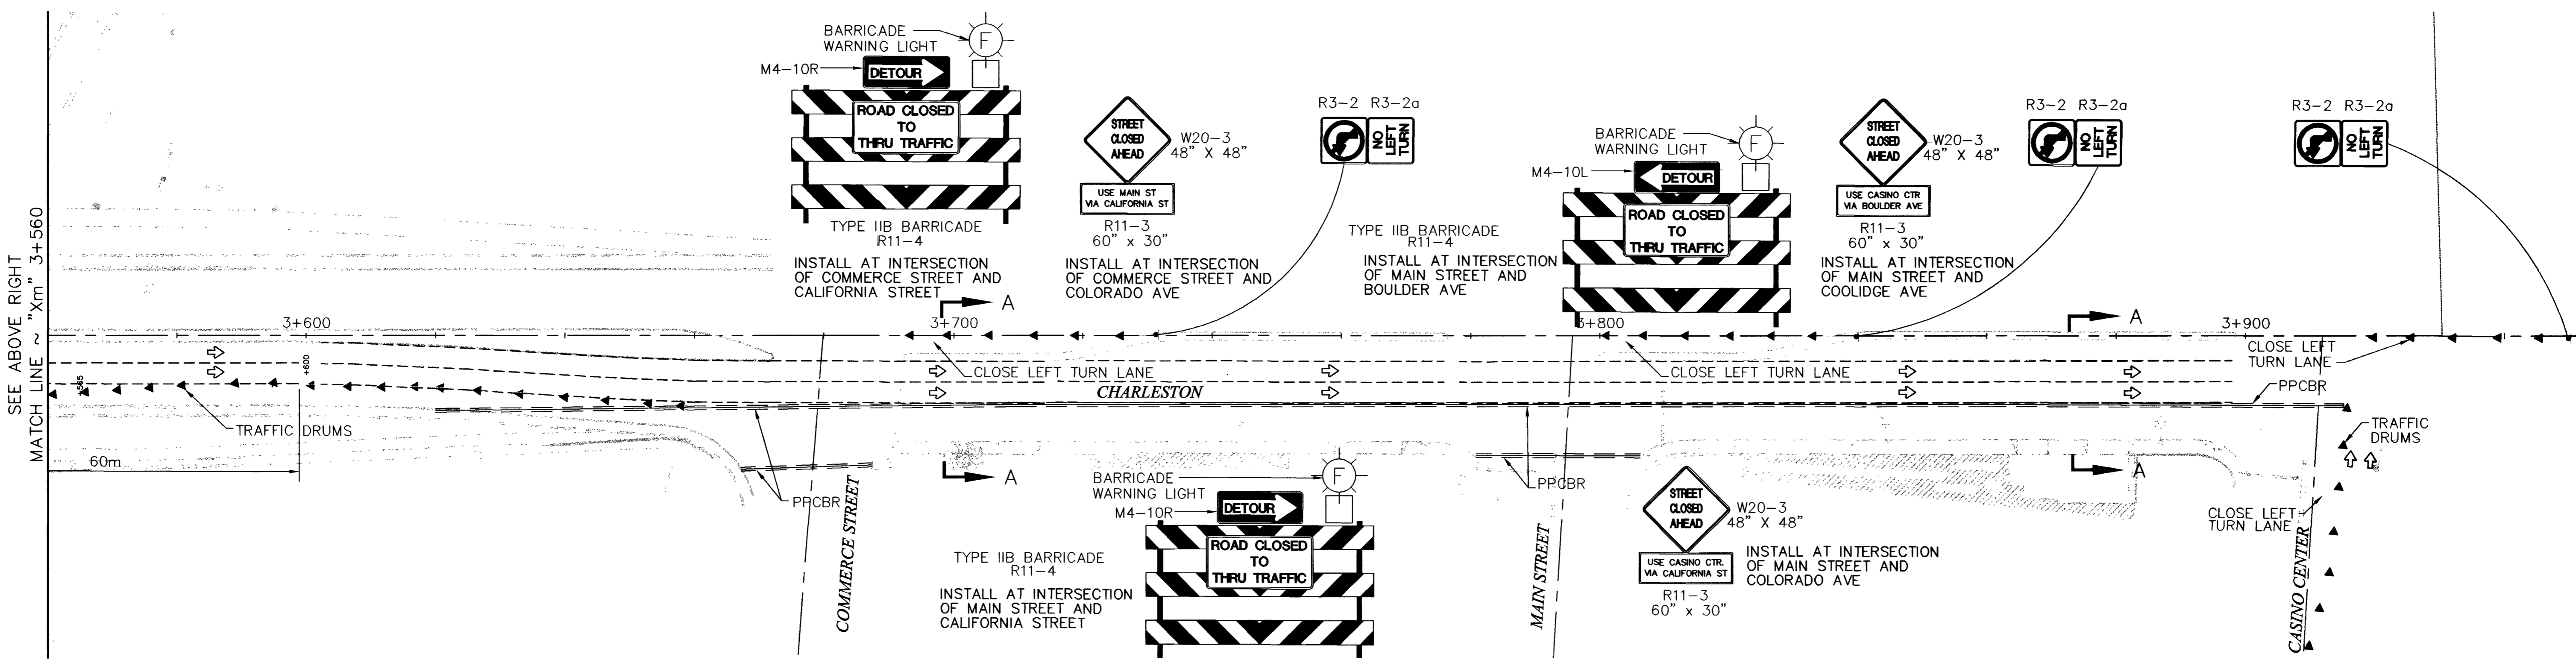

DATE	4/20/03
REVISIONS	
RECORD DRAWING	


PROJECT # 31604
 SCALE (V) N/A
 SCALE (H) 1:500
 FLD. Bk. # N/A

DESIGN BY DWR
 DATE DEC 17, 1999

PARSONS BRINCKERHOFF
 Las Vegas, Nevada



DEPARTMENT OF PUBLIC WORKS
 I-15 FREEWAY CHANNEL
 CHARLESTON BLVD SANITARY SEWER WORK
 NIGHTTIME TRAFFIC CONTROL

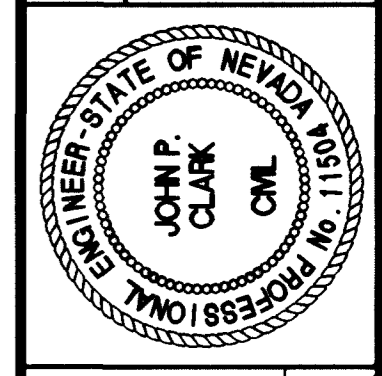

DRAWING No. 211
 TC-4

RECORD DRAWING METRIC