

- LEGEND**
- PORTABLE PRECAST CONCRETE BARRIER RAIL
 - ⊗ TEMPORARY IMPACT ATTENUATOR (70 KMH)
 - TEMPORARY CONSTRUCTION SIGN
 - ▶ TRAFFIC DRUM AT 9.0m SPACING
- TEMPORARY PAVEMENT DELINEATION LEGEND**
- ① 200mm SOLID WHITE LINE




MATCH LINE ~ "Xm" 2+960

MATCH LINE ~ "Xm" 3+280
SEE SHEET TC-6


<p>Call before you Dig.</p> <p>1-800-277-2600</p> <p><small>UNDERGROUND SERVICE (USA)</small></p>	<p>Call before you Overhead</p> <p>563-6111</p> <p><small>OVERHEAD SERVICE (USA)</small></p>
---	--

DATE	REVISIONS
4/20/03	RECORD DRAWING

SCALE (H) N/A	SCALE (V) N/A	PROJECT # 31604
F.L.D. # N/A	DATE DEC 17, 1999	DESIGN BY DWR

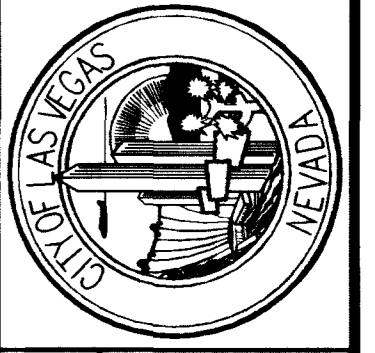

DEPARTMENT OF PUBLIC WORKS
 I-15 FREEWAY CHANNEL
 CHARLESTON BLVD RCB WORK
 TRAFFIC CONTROL

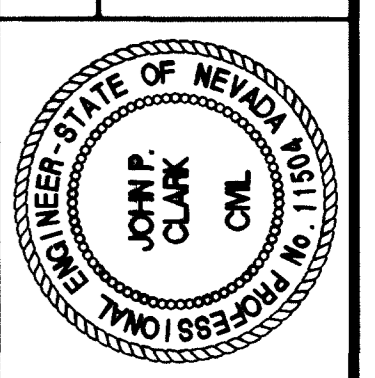

DRAWING No.	212
	TC-5
	241

RECORD DRAWING METRIC

327-V254