



SEE SHEET TC-9, TC-11  
MATCH LINE ~ "MLK" 1+980

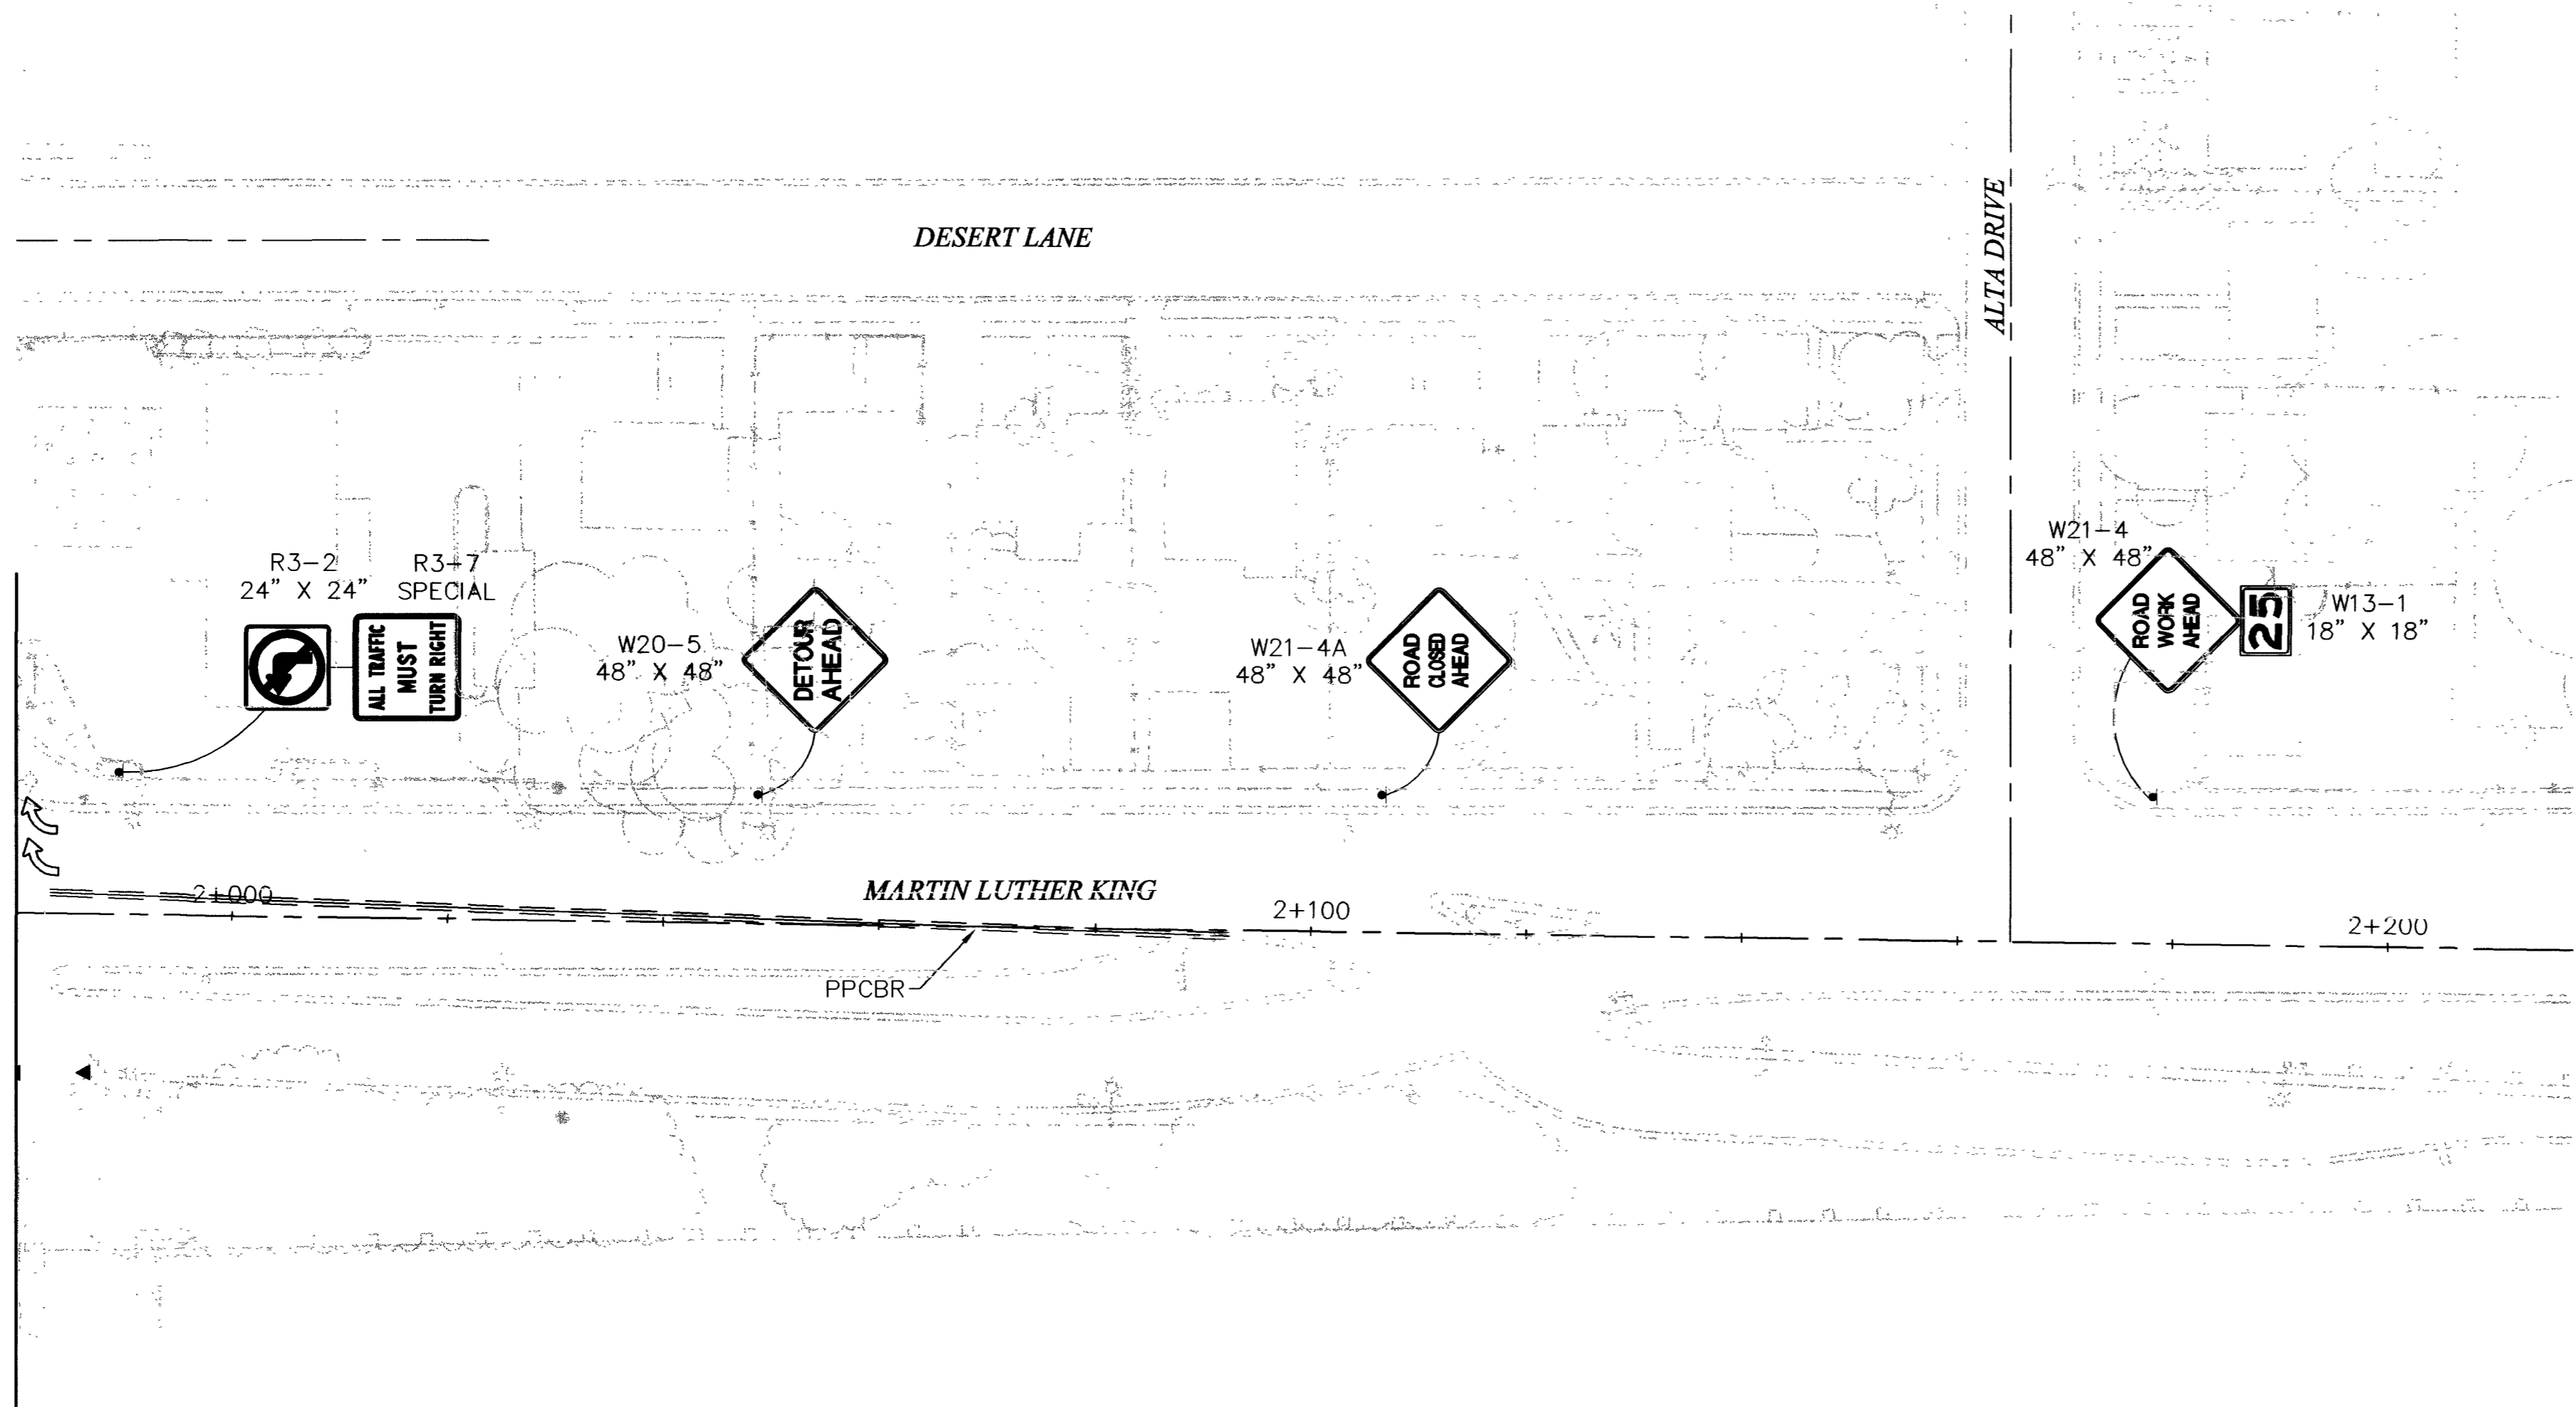

- LEGEND**
- ▬ PORTABLE PRECAST CONCRETE BARRIER RAIL
  - TEMPORARY CONSTRUCTION SIGN
- TEMPORARY PAVEMENT DELINEATION LEGEND**
- ① 200mm SOLID WHITE LINE

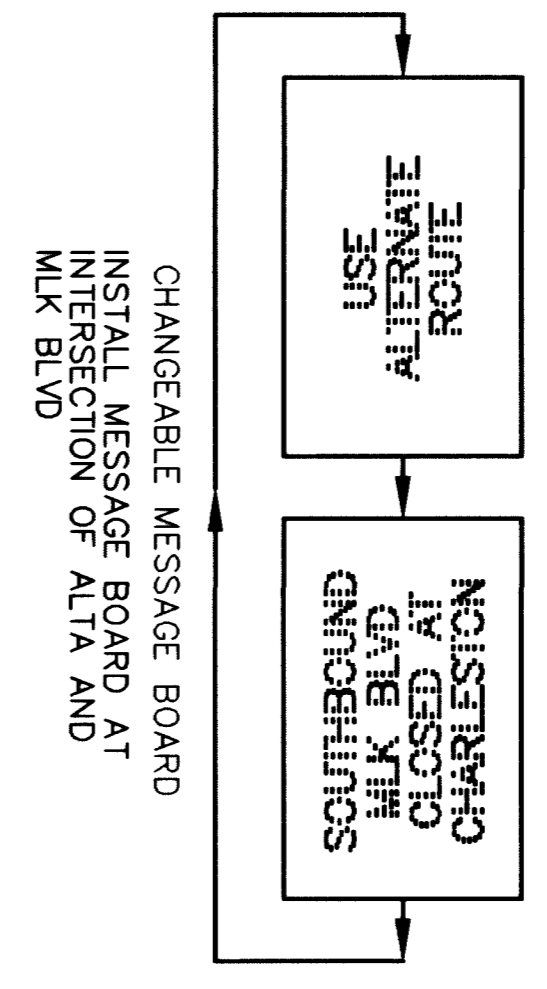

<p>Call before you Dig. 1-800-277-2600 <small>UNDERGROUND SERVICE (USA)</small></p>	<p>Call before you Overhead 563-6111 <small>OVERHEAD SERVICE (USA)</small></p>
---	--

	<p><b>DEPARTMENT OF PUBLIC WORKS</b></p> <p>I-15 FREEWAY CHANNEL MARTIN LUTHER KING TRAFFIC CONTROL</p>		<p>PROJECT # 31604 DESIGN BY DWR DATE DEC 17, 1999</p>	<p>REVISIONS</p> <table border="1" style="width: 100%; border-collapse: collapse;"> <tr> <th>NO.</th> <th>DESCRIPTION</th> <th>DATE</th> </tr> <tr> <td> </td> <td> </td> <td> </td> </tr> </table>	NO.	DESCRIPTION	DATE				<p>DATE 4/30/03</p>
NO.	DESCRIPTION	DATE									
<p>DRAWING No. 214 <b>TC-7</b></p>		<p>RECORD DRAWING METRIC</p>		<p>327-V254</p>							