



- LEGEND**
- PORTABLE PRECAST CONCRETE BARRIER RAIL
 - TEMPORARY IMPACT ATTENUATOR (70 KMH)
 - TEMPORARY CONSTRUCTION SIGN
 - TRAFFIC DRUM AT 9.0m SPACING
- TEMPORARY PAVEMENT DELINEATION LEGEND**
- 200mm SOLID WHITE LINE
 - 200mm SOLID YELLOW LINE

DATE	REVISIONS
4/20/03	RECORD DRAWING

SCALE (H)	N/A	SCALE (V)	N/A	PROJECT #	31604
F.L.D. Bk. #	N/A	DATE	DEC 17, 1999	DESIGN BY	DNR

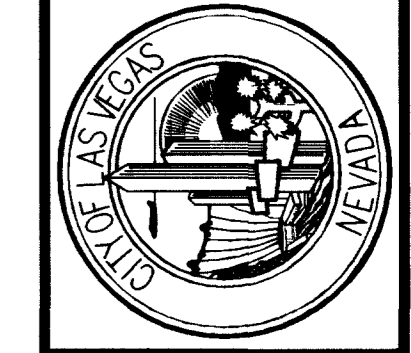


DEPARTMENT OF PUBLIC WORKS
I-15 FREEWAY CHANNEL
CHARLESTON BLVD
TRAFFIC CONTROL

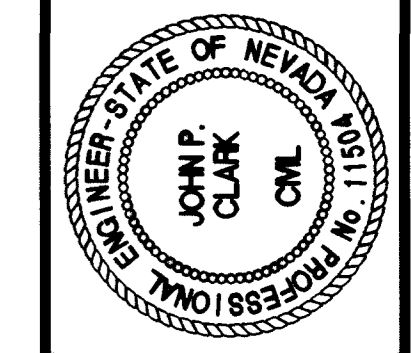

DRAWING No.	216
	TC-9
	241

RECORD DRAWING METRIC

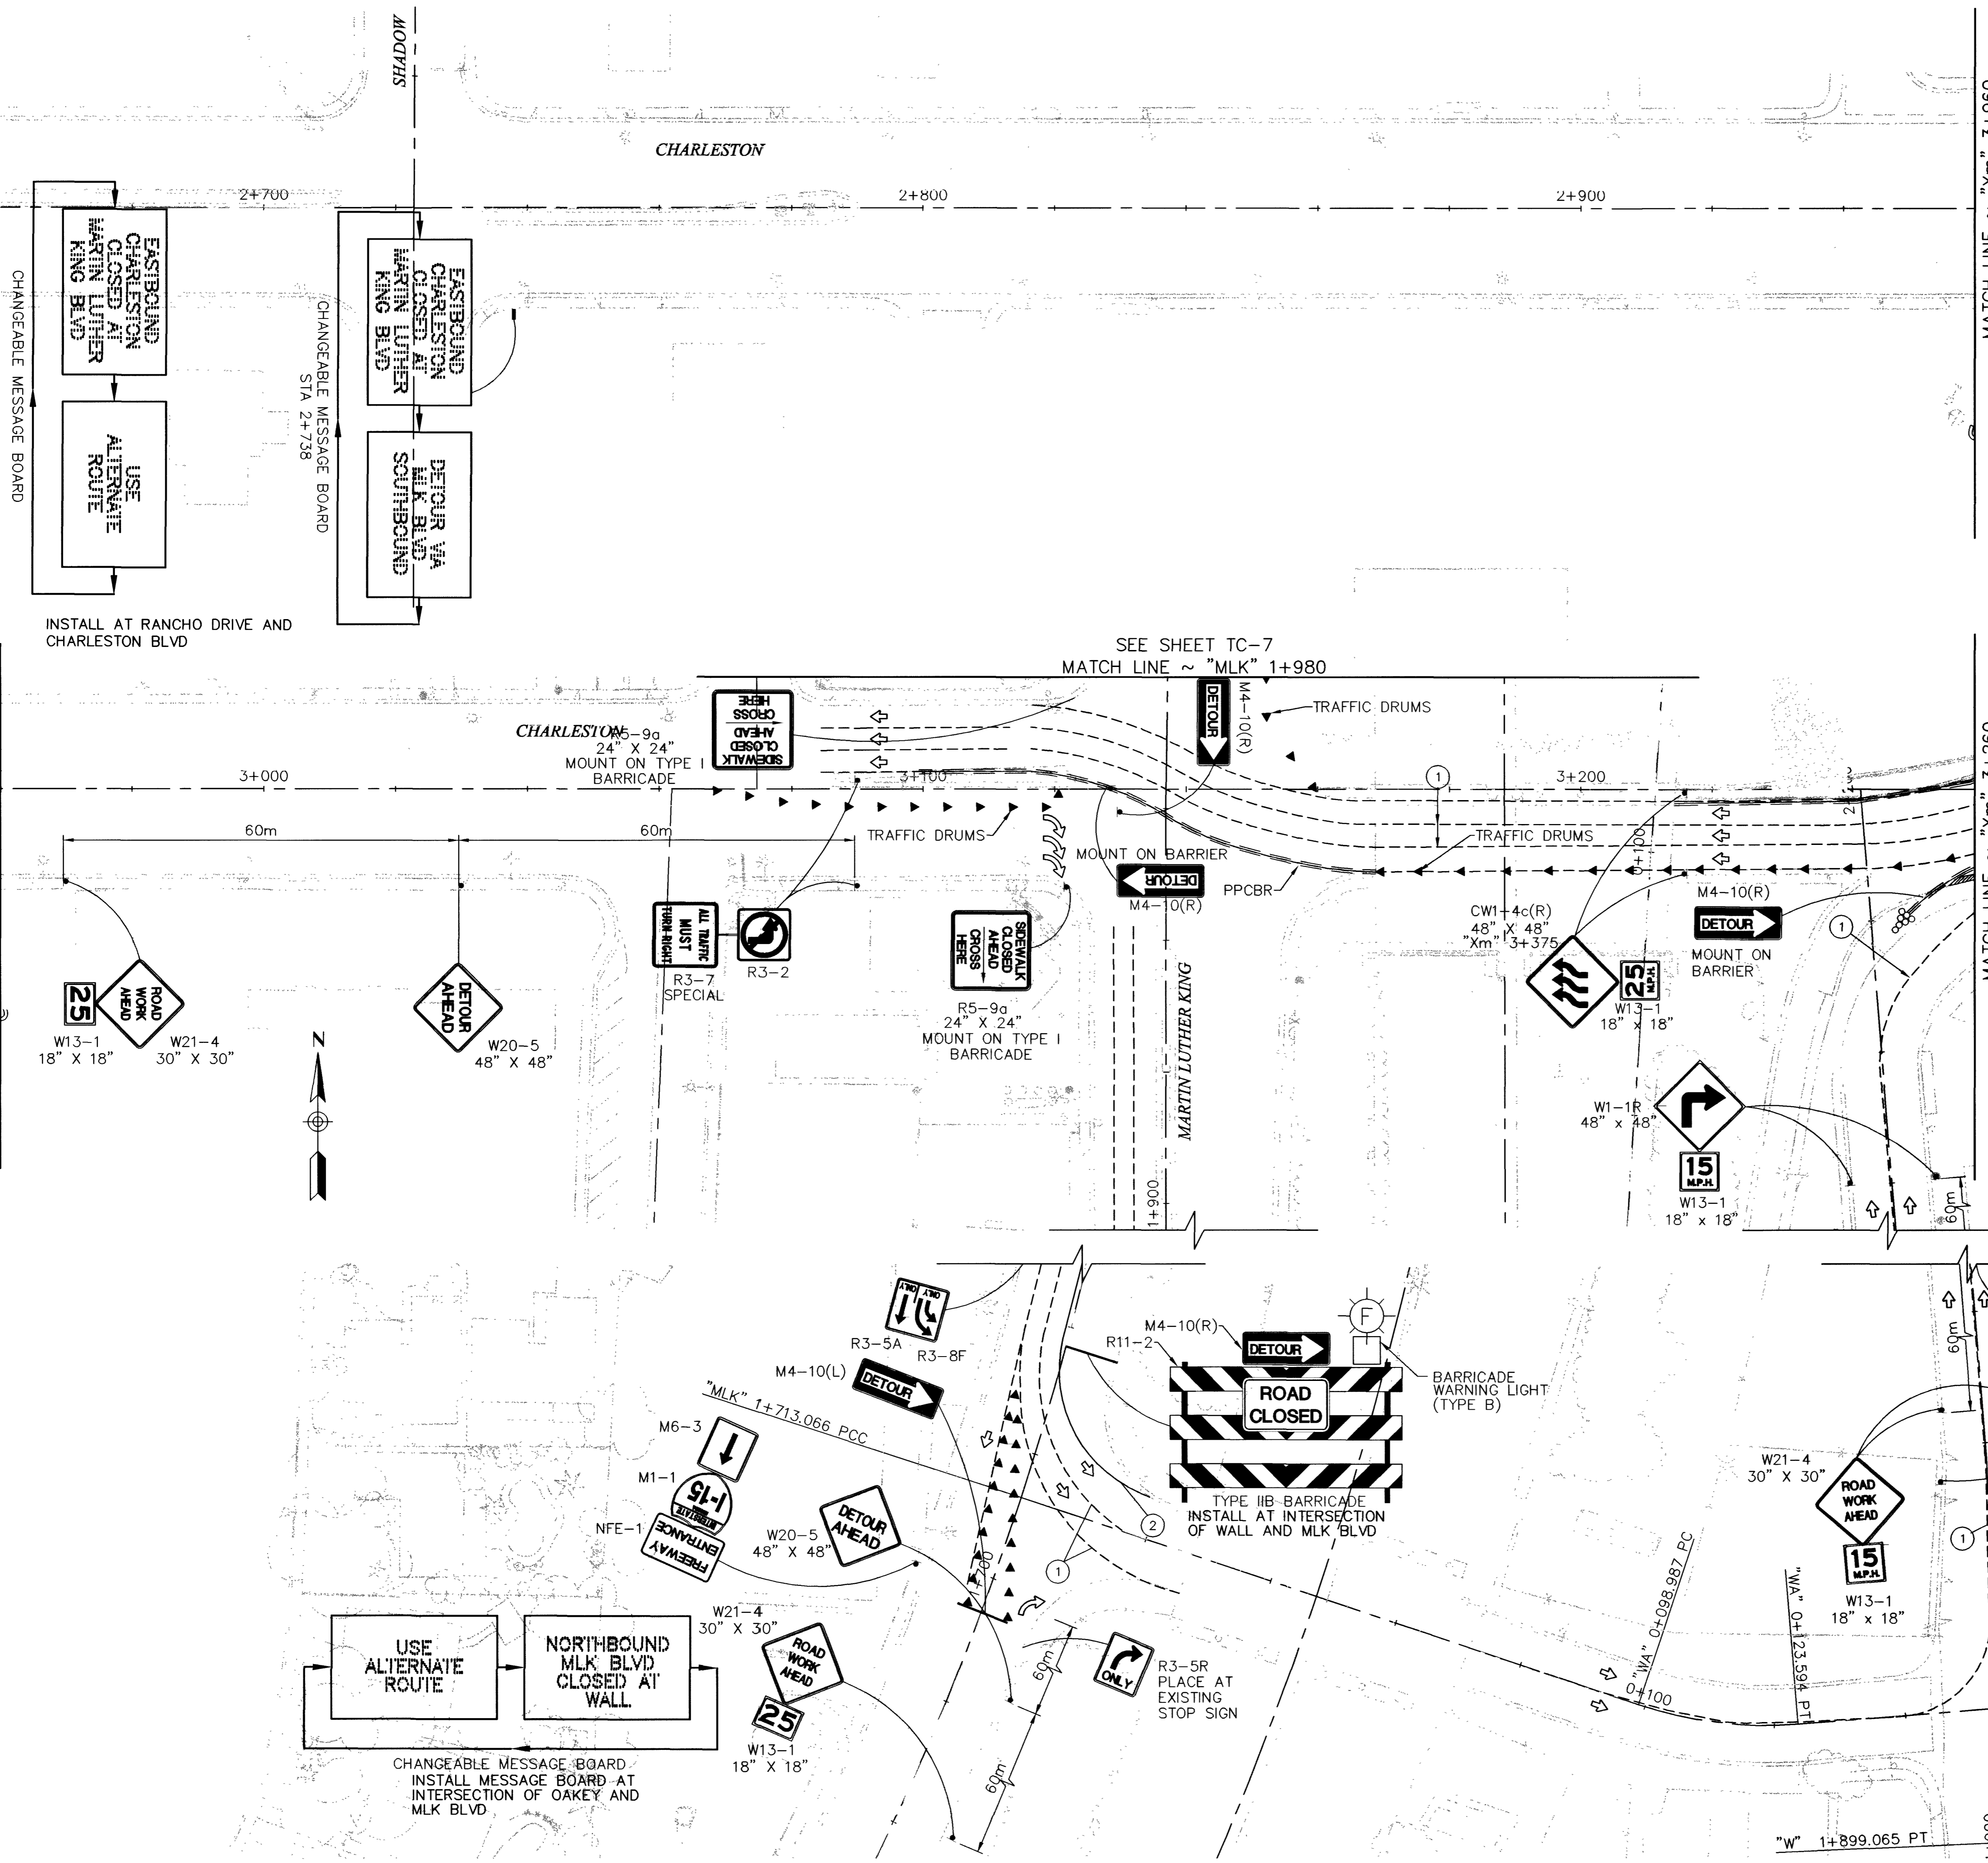

Call before you Dig.
 1-800-277-2600
UNDERGROUND SERVICE (USA)

Call before you Overhead
 563-6111
OVERHEAD SERVICE (USA)