


- LEGEND**
- ▬ PORTABLE PRECAST CONCRETE BARRIER RAIL W/LIGHTS
  - ⊗ TEMPORARY IMPACT ATTENUATOR (70 KMH)
  - TEMPORARY CONSTRUCTION SIGN
  - ▶ TRAFFIC DRUM AT 9.0m SPACING
- TEMPORARY PAVEMENT DELINEATION LEGEND**
- ① 200mm SOLID WHITE LINE
  - ② 200mm SOLID YELLOW LINE

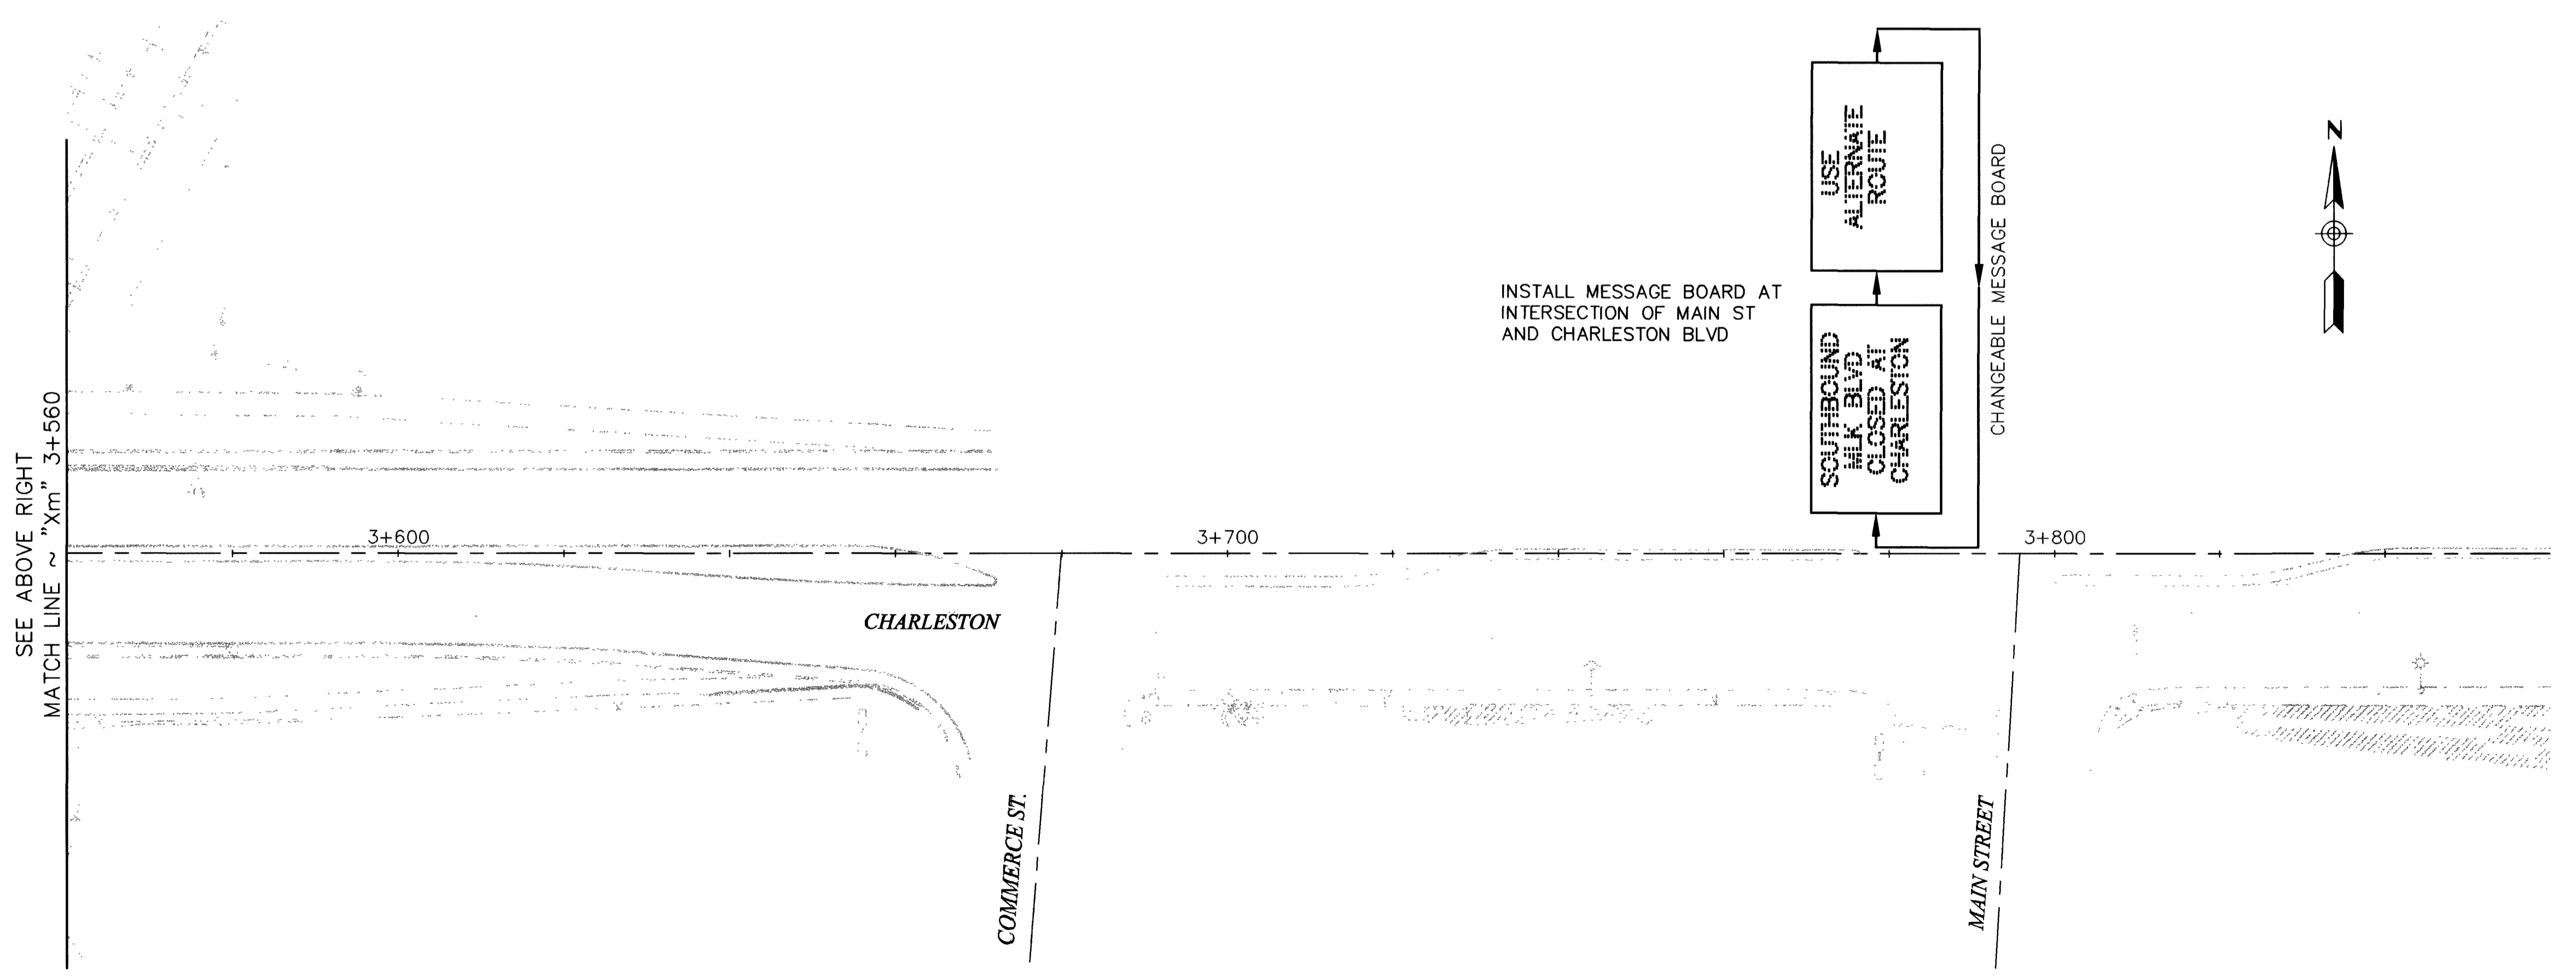

<p>Call before you Dig. 1-800-277-2600 <small>UNDERGROUND SERVICE (USA)</small></p>	<p>Call before you Overhead 563-6111 <small>OVERHEAD SERVICE (USA)</small></p>
---	--


DATE	REVISIONS
4/20/03	RECORD DRAWING

SCALE (H)	SCALE (V)	DATE	DESIGN BY
1:500	N/A	DEC 17, 1998	DWR

PROJECT # 31604  
FLD. BK. # N/A



**DEPARTMENT OF PUBLIC WORKS**  
I-15 FREEWAY CHANNEL  
CHARLESTON BLVD  
TRAFFIC CONTROL

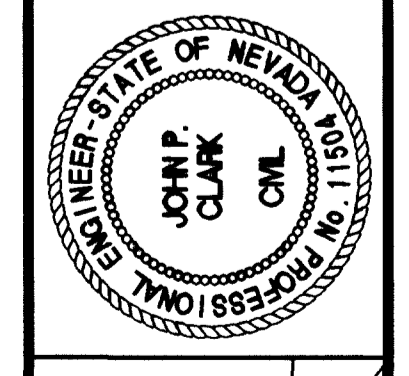

DRAWING No.	217
	241

K:\31604\Record-dwgs\TC-10.dwg, 05/16/2003 02:41:26 PM, crottr  
c2614