


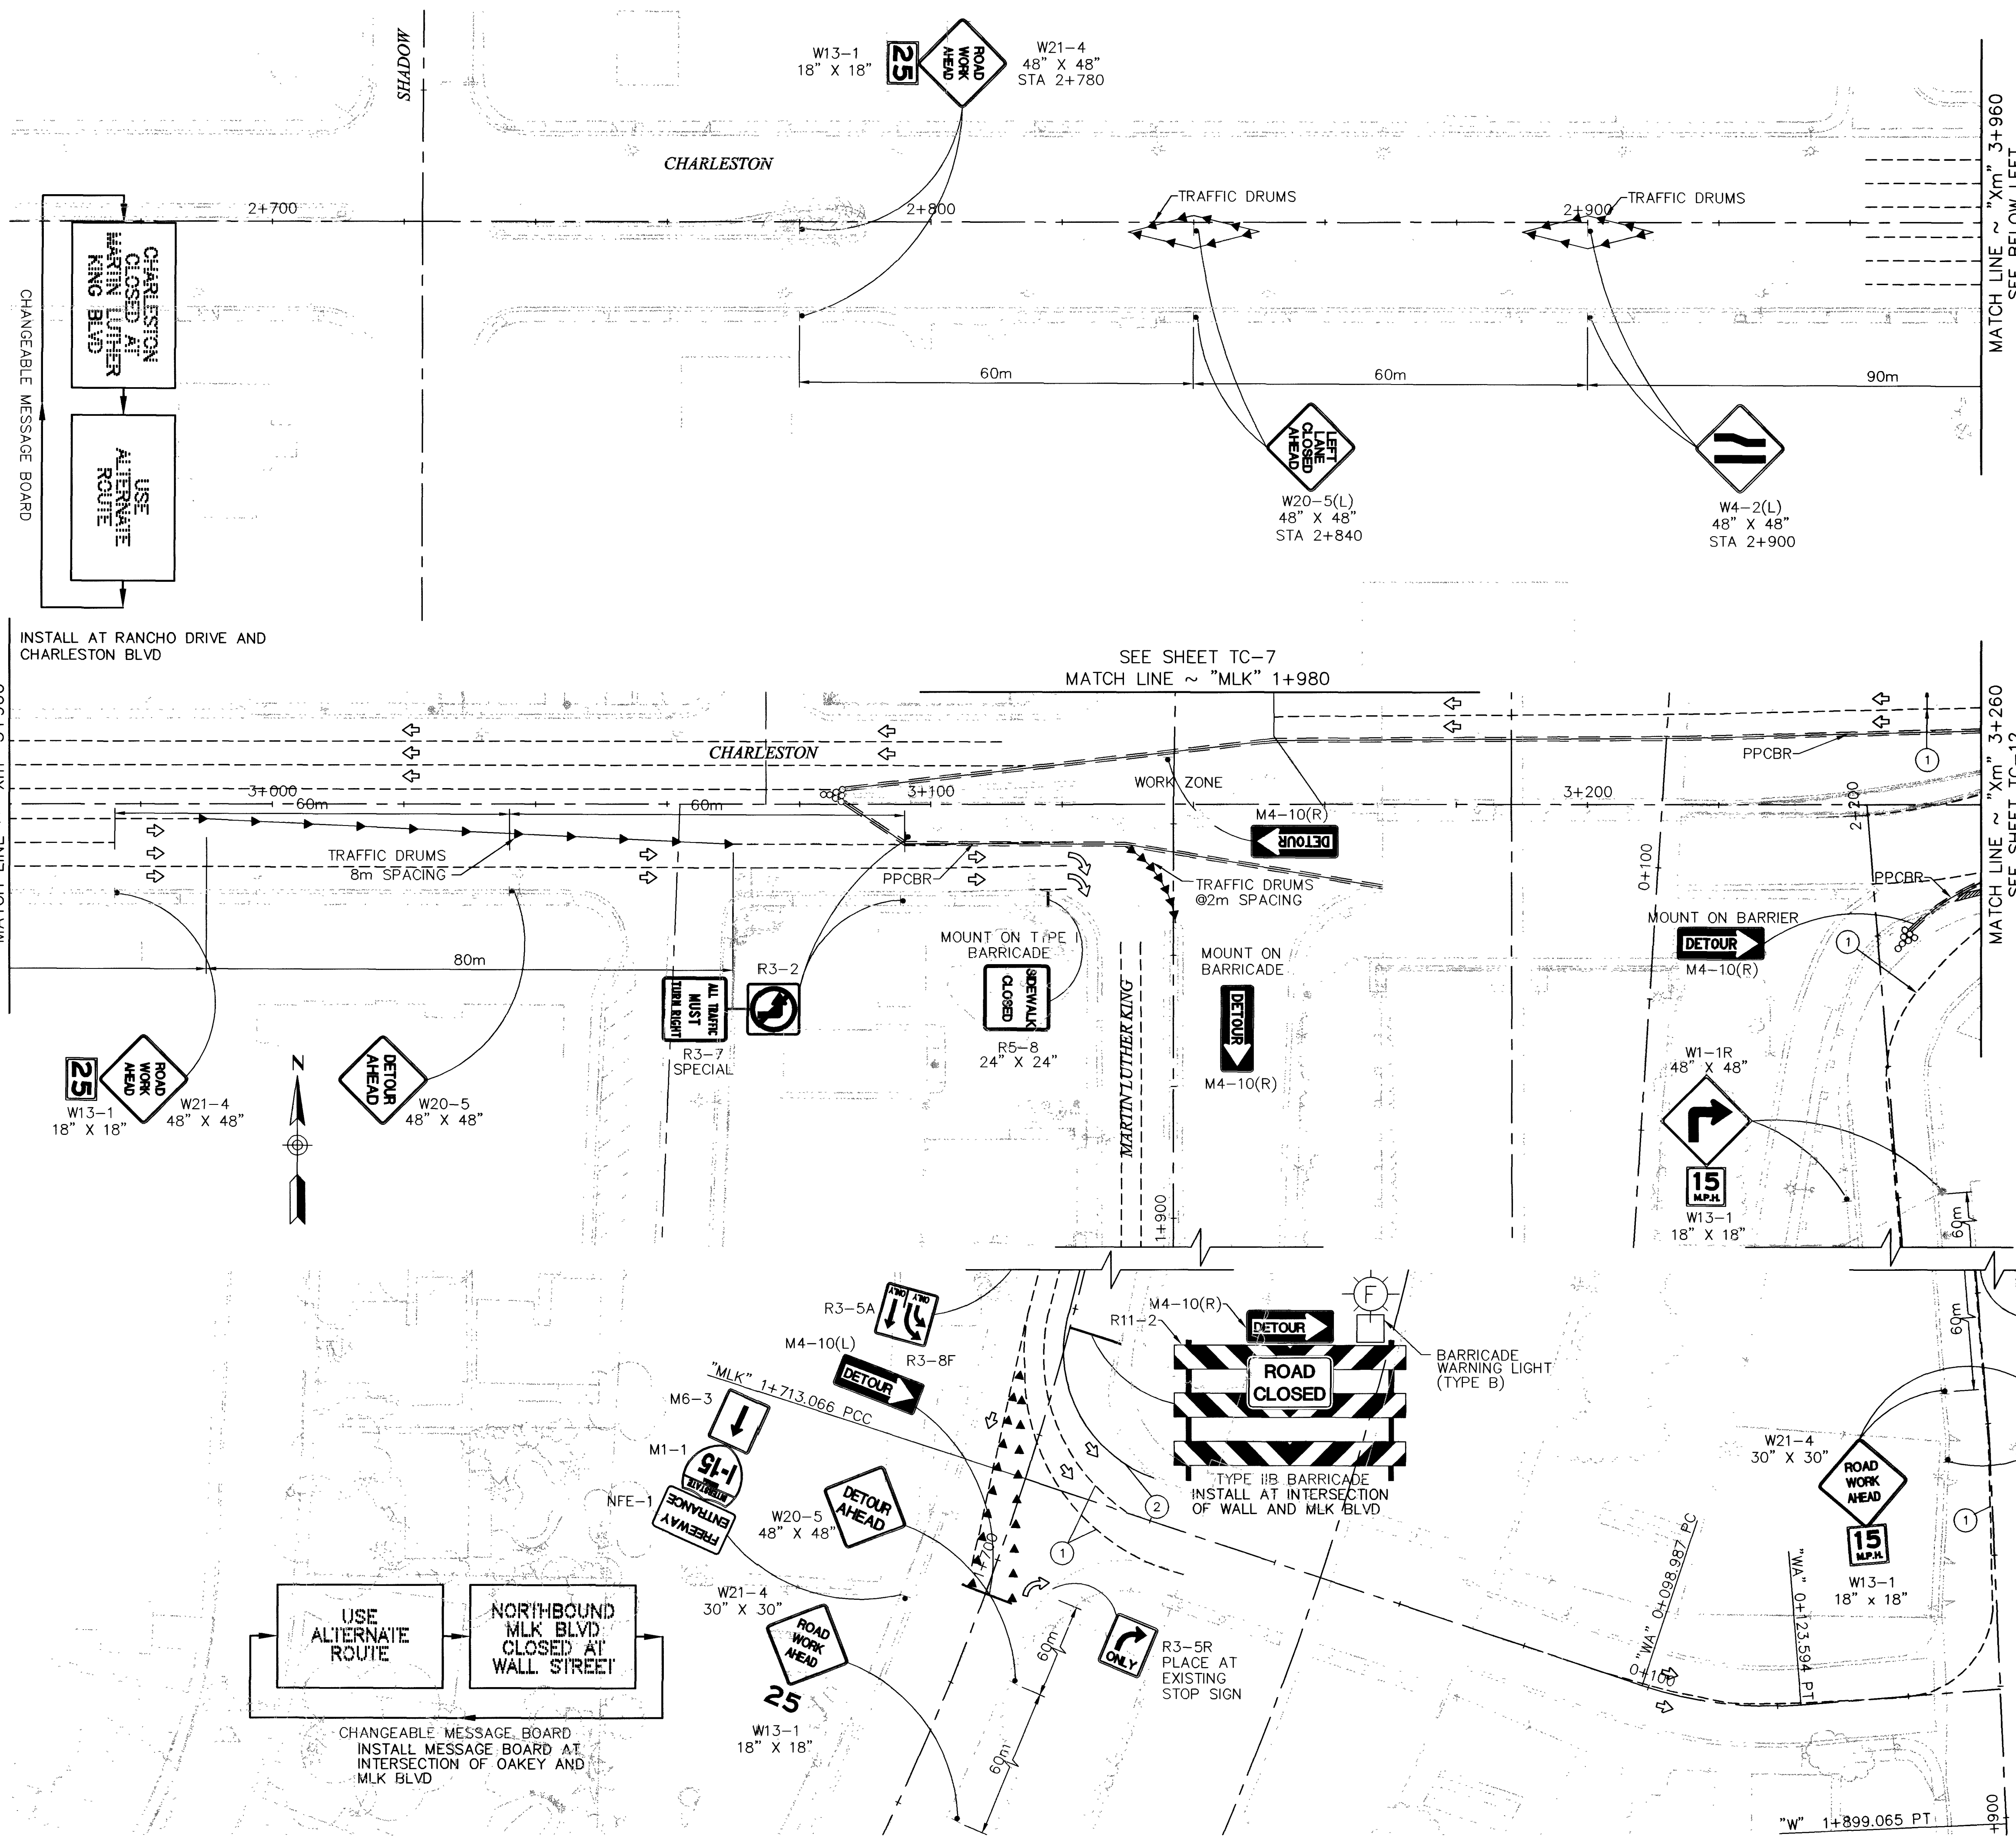

- LEGEND
- PORTABLE PRECAST CONCRETE BARRIER RAIL
 - TEMPORARY IMPACT ATTENUATOR (70 KMH)
 - TEMPORARY CONSTRUCTION SIGN
 - TRAFFIC DRUM AT 9.0m SPACING
- TEMPORARY PAVEMENT DELINEATION LEGEND
- 200mm SOLID WHITE LINE
 - 200mm SOLID YELLOW LINE

Call before you Dig.
1-800-277-2600
UNDERGROUND SERVICE (USA)

Call before you Overhead
563-6111
OVERHEAD SERVICE (USA)

DATE	4/20/03	REVISIONS	PROJECT #	31604	SCALE (H)	N/A	SCALE (V)	N/A	DATE	DEC 17, 1999	DESIGN BY	DWR
RECORD DRAWING												
PARSONS BRINCKERHOFF Las Vegas, Nevada												
DEPARTMENT OF PUBLIC WORKS I-15 FREEWAY CHANNEL CHARLESTON BLVD TRAFFIC CONTROL												
DRAWING No. 218 TC-11												