



PERMANENT PAVEMENT DELINEATION LEGEND

- ① TYPE 1 CENTERLINE PER CCPW USD DWG 244
- ② TRANSITION SECTION PER CCPW USD DWG 245
- ③ STORAGE LANE LINE PER CCPW USD DWG 246A
- ④ TYPE 4 LANE LINE PER CCPW USD DWG 244A
- ⑤ 150mm SOLID WHITE PAINT OR TAPE PARKING LINE
- ⑥ DROP LANE LINE PER CCPW USD DWG 246A
- A INSTALL "ARROWS", "ONLY", & "STOP" USING TYPE 2 MARKING FILM

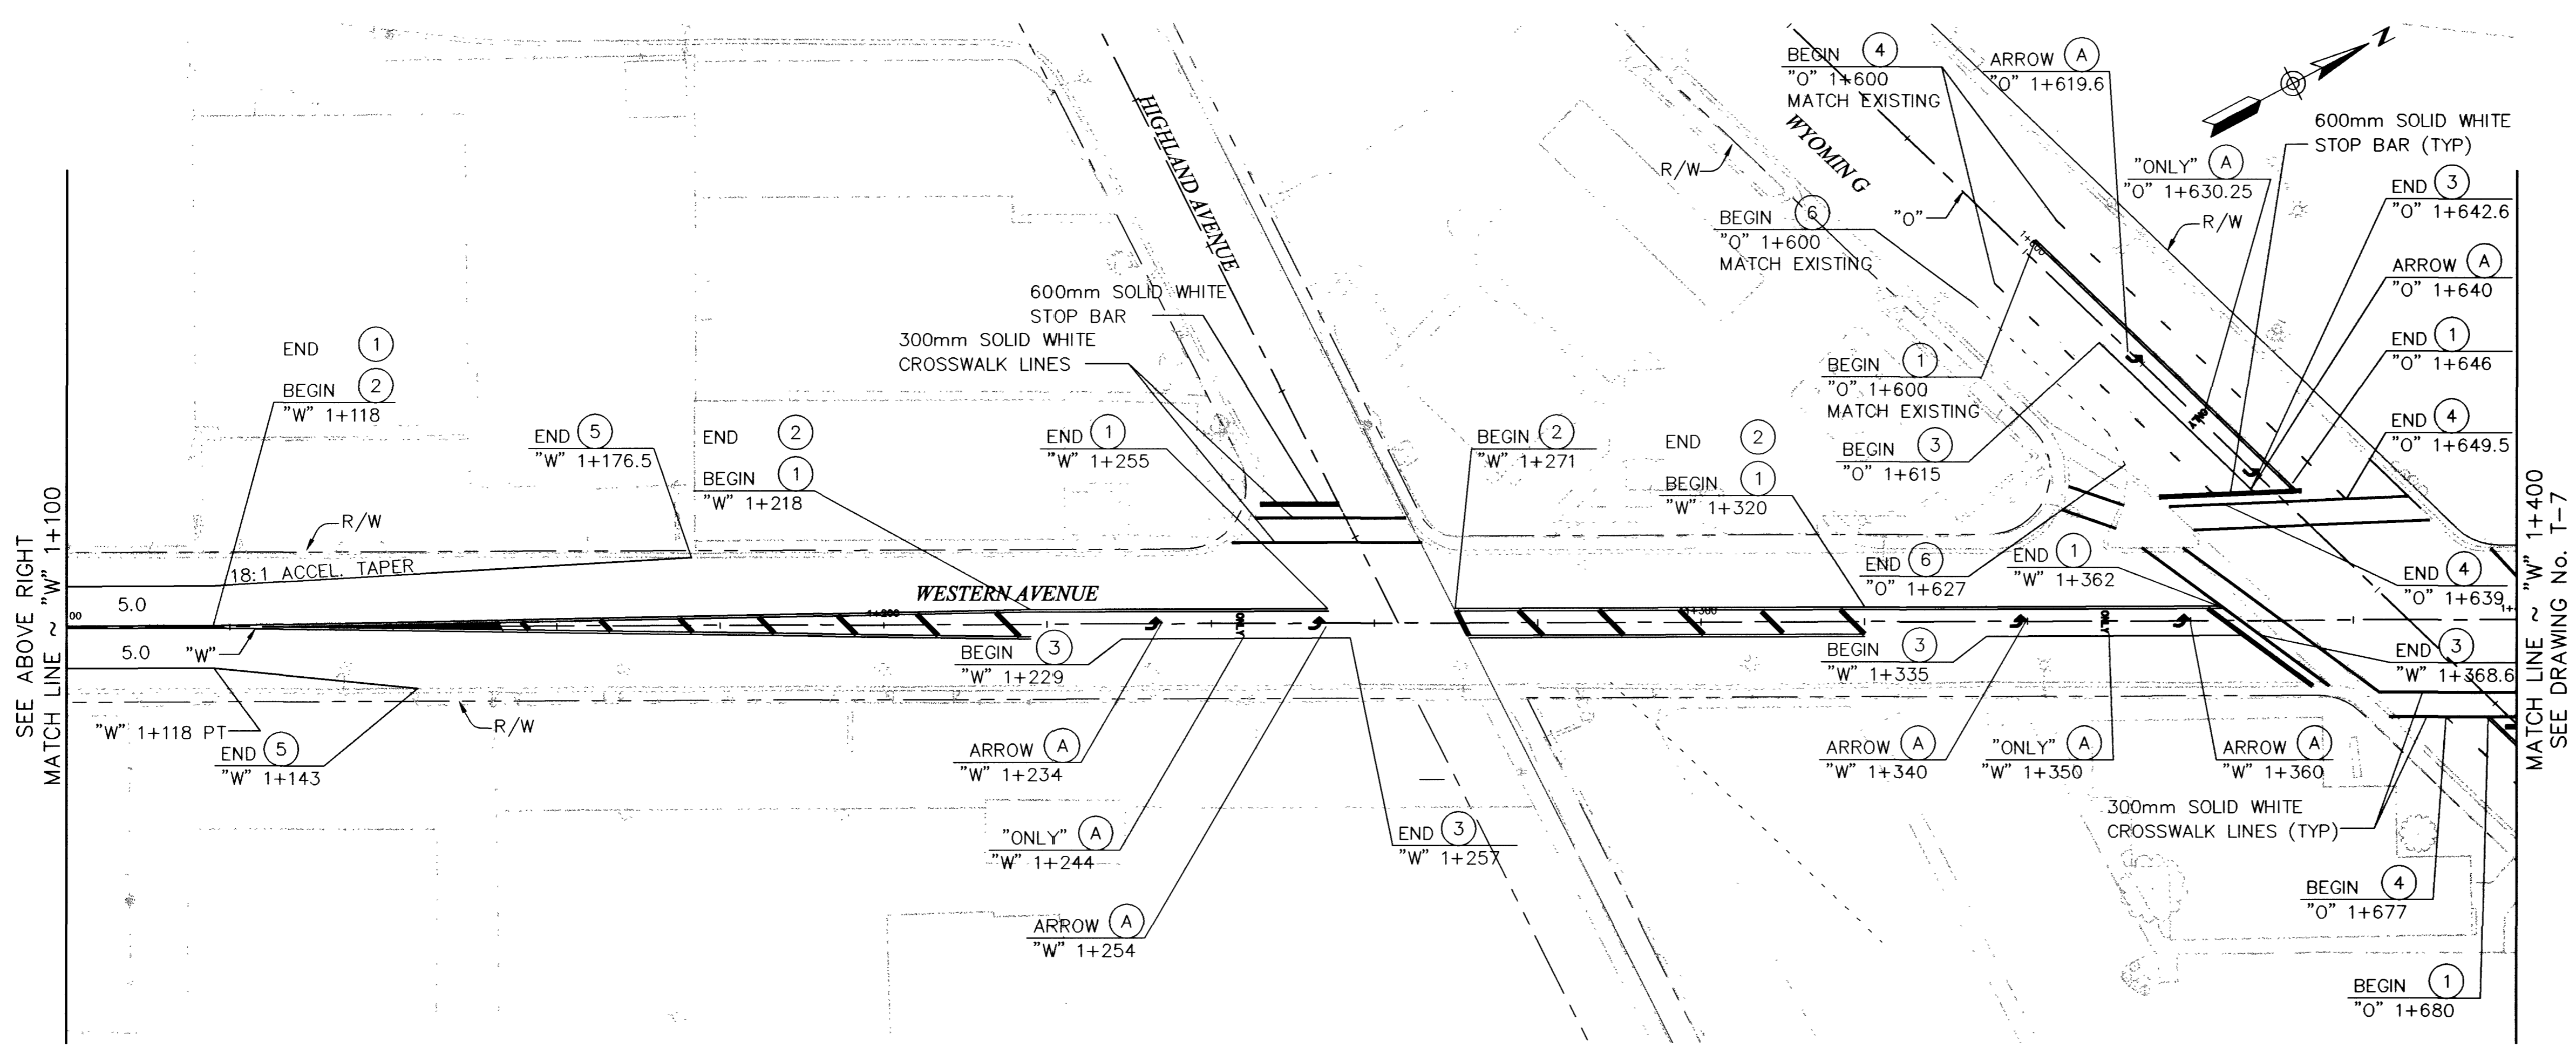

Call before you Dig.  
1-800-277-2600  
UNDERGROUND SERVICE (USA)

Call before you Overhead  
563-6111  
OVERHEAD SERVICE (USA)

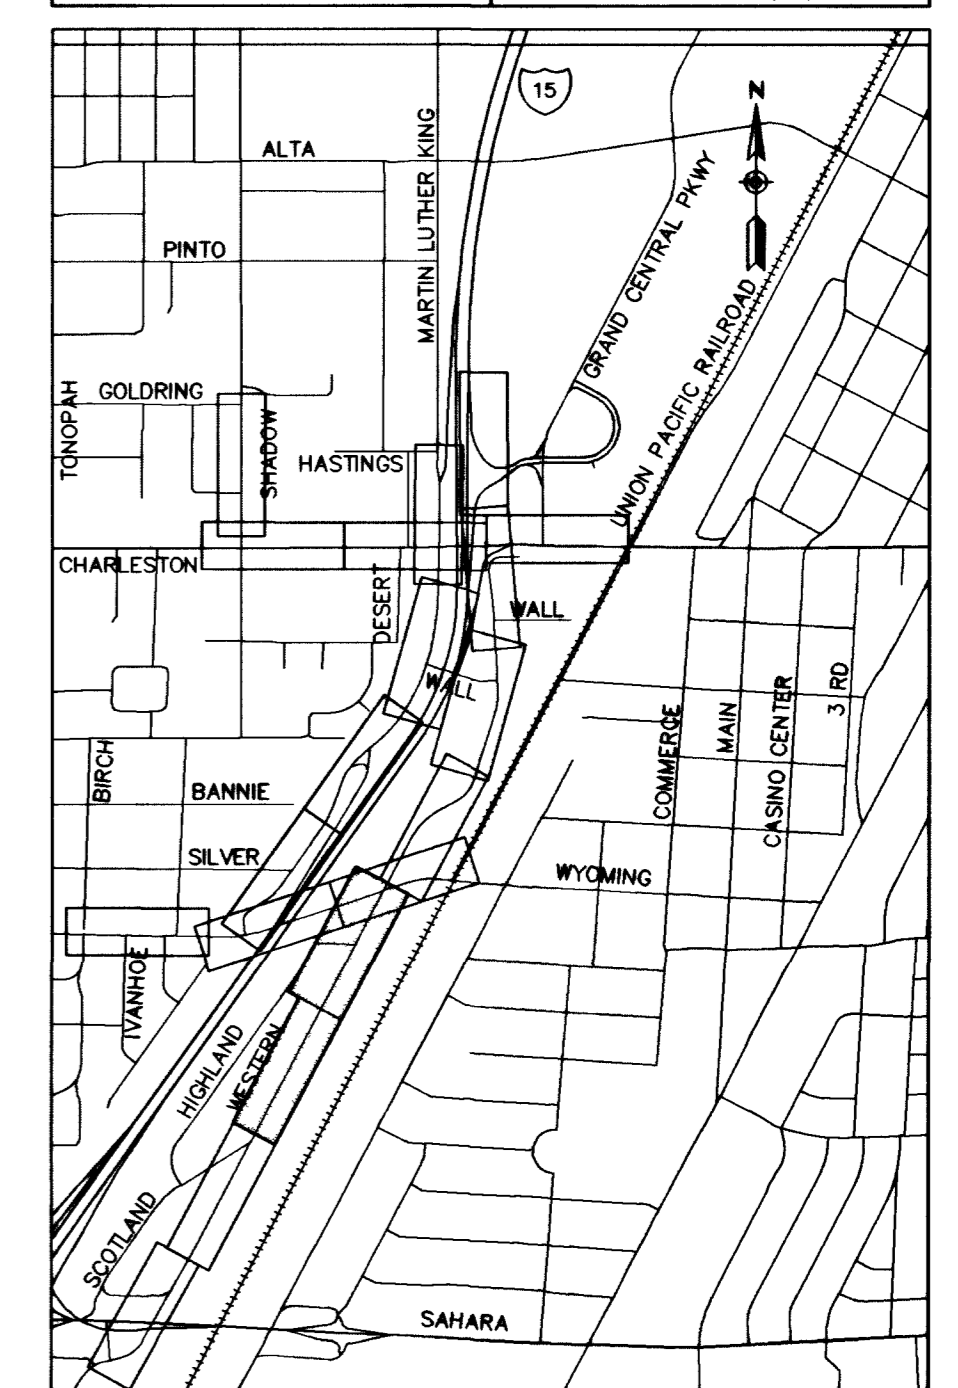

DATE	7/30/03
REVISIONS	
RECORD DRAWING	
PROJECT #	31804
SCALE (V)	N/A
SCALE (H)	1:500
DATE	DEC 17, 1999
DESIGN BY	KFN
F.L.D. BK. #	N/A

**PARSONS BRINCKERHOFF**  
Las Vegas, Nevada

**DEPARTMENT OF PUBLIC WORKS**  
I-15 FREEWAY CHANNEL  
SIGNING AND STRIPING PLAN  
"W" 0+800 TO "W" 1+400

**RECORD DRAWING METRIC**

DRAWING No. 230  
T-6  
241

327-V254

2687