
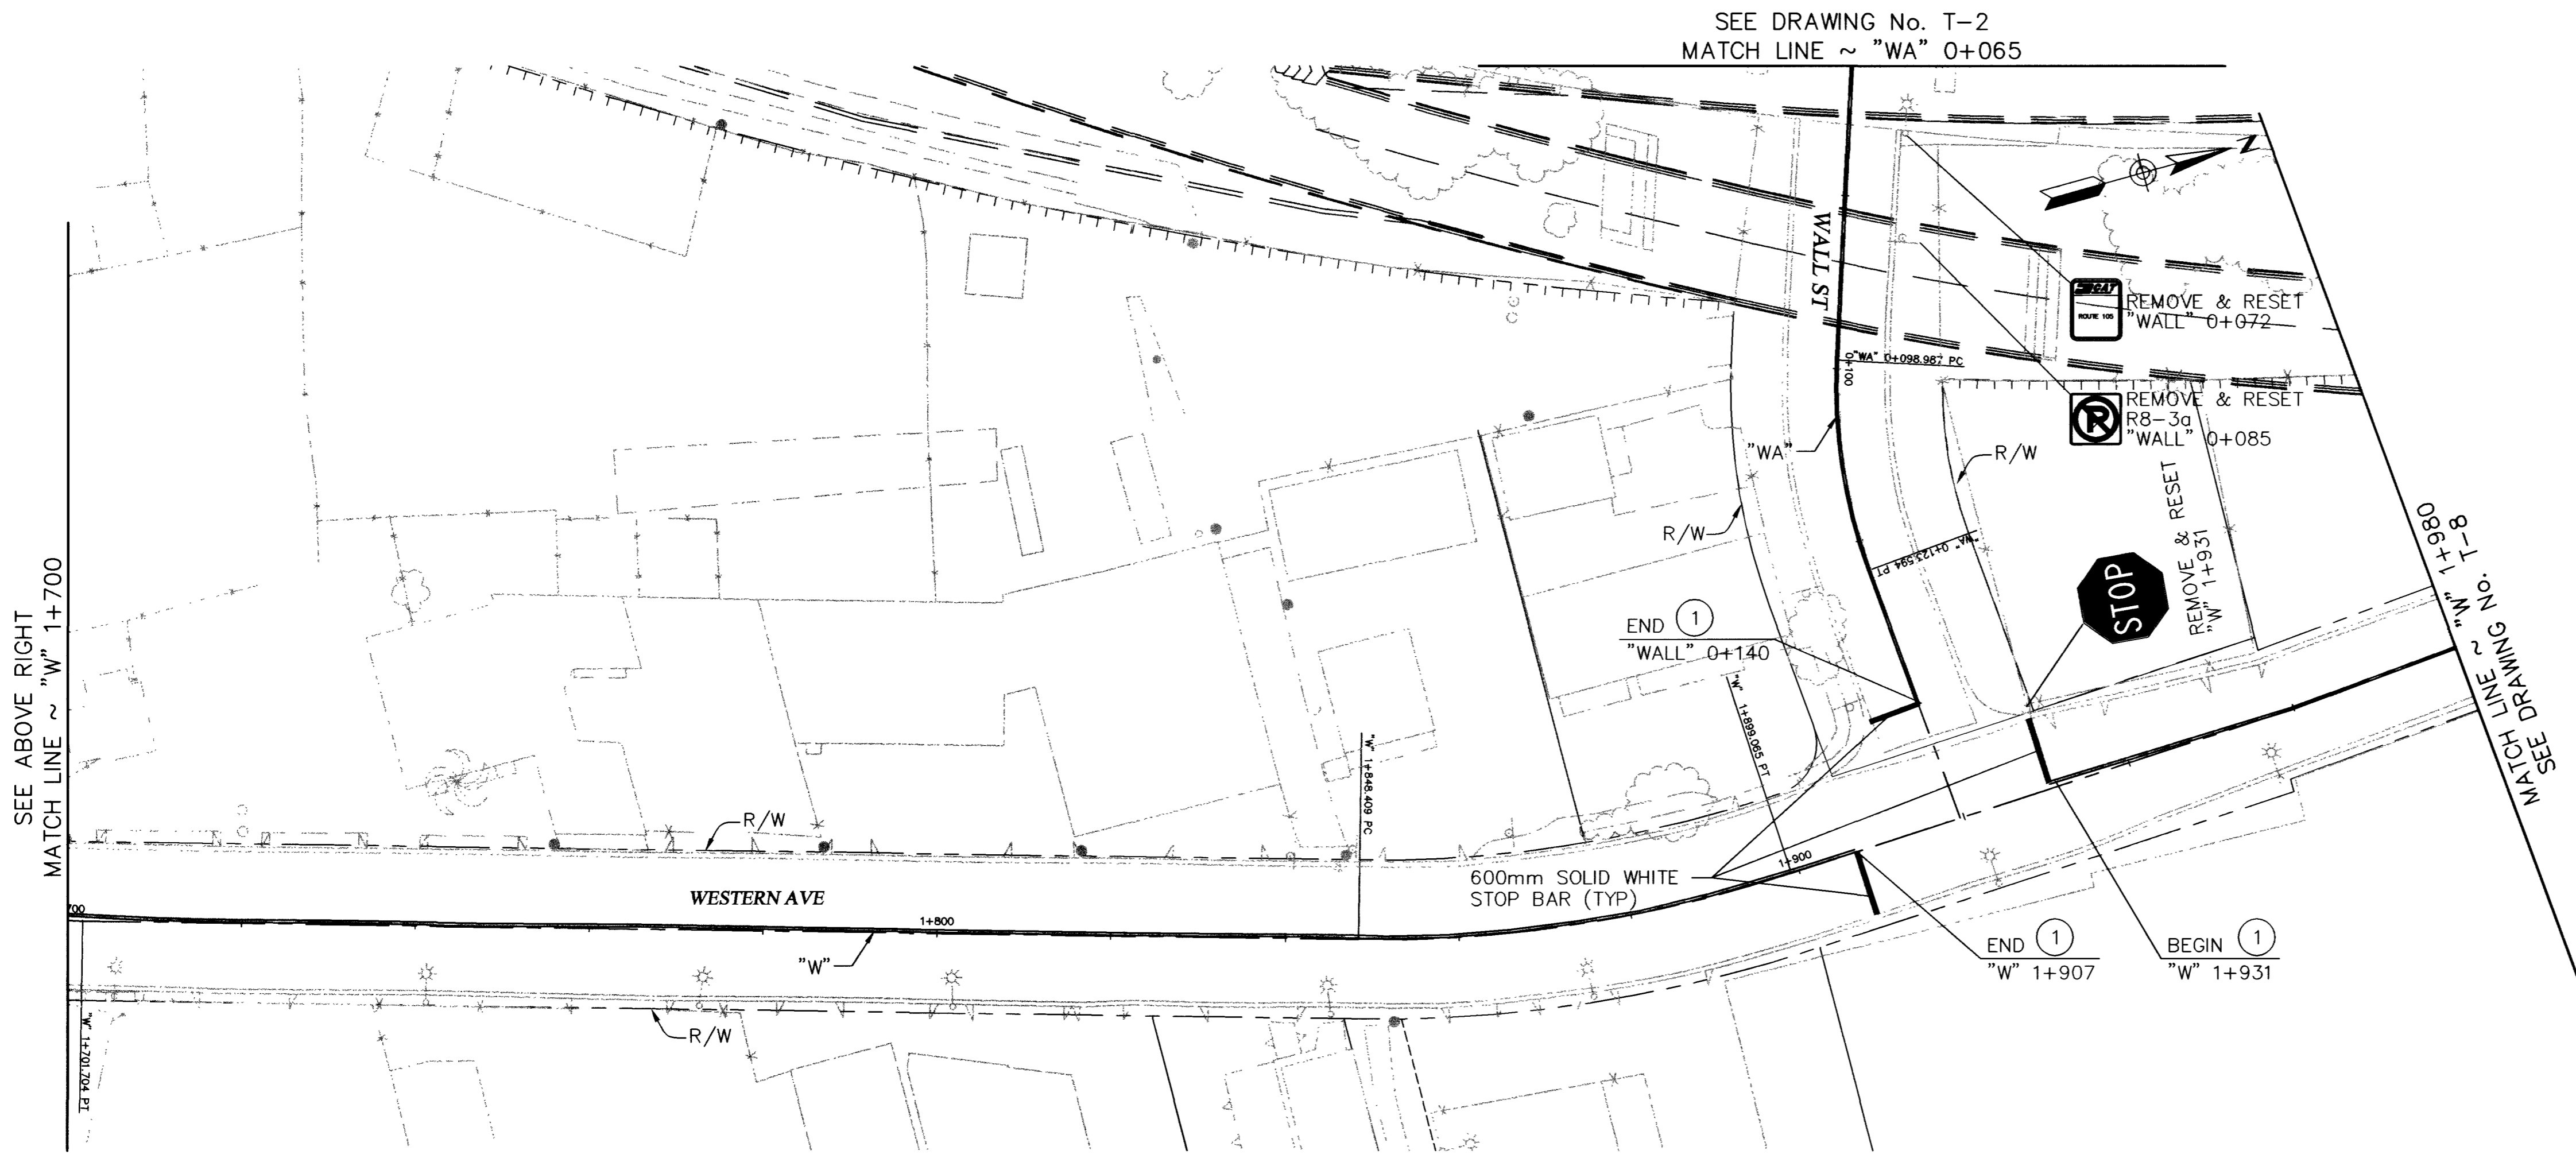



PERMANENT PAVEMENT DELINEATION LEGEND

- ① TYPE 1 CENTERLINE PER CCPW USD DWG 244
- ③ STORAGE LANE LINE PER CCPW USD DWG 246A
- ④ TYPE 4 LANE LINE PER CCPW USD DWG 244A
- A INSTALL "ARROWS", "ONLY", & "STOP" USING TYPE 2 MARKING FILM

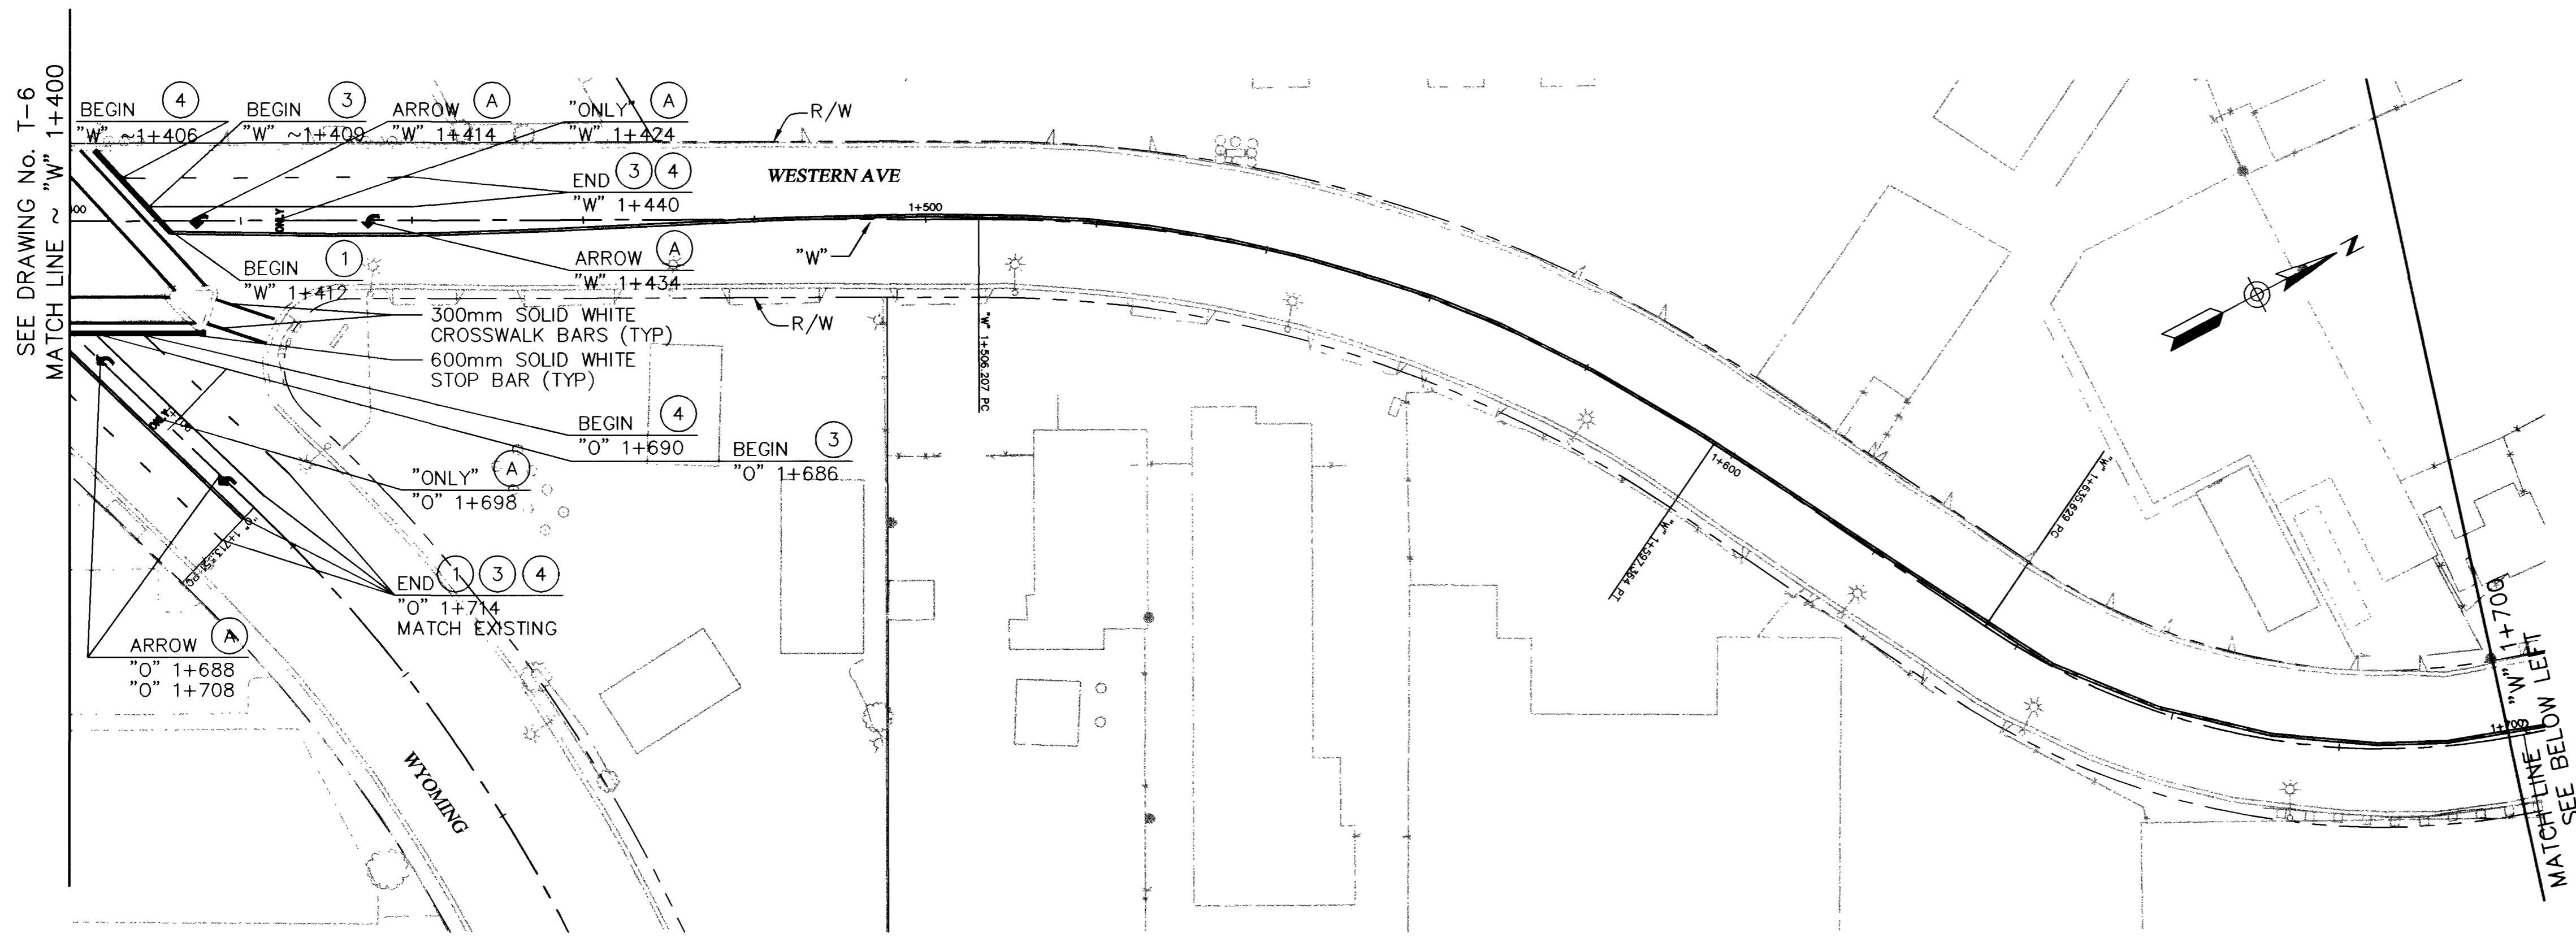


Call before you Dig. 1-800-277-2600 UNDERGROUND SERVICE (USA)

Call before you Overhead 563-6111 OVERHEAD SERVICE (USA)

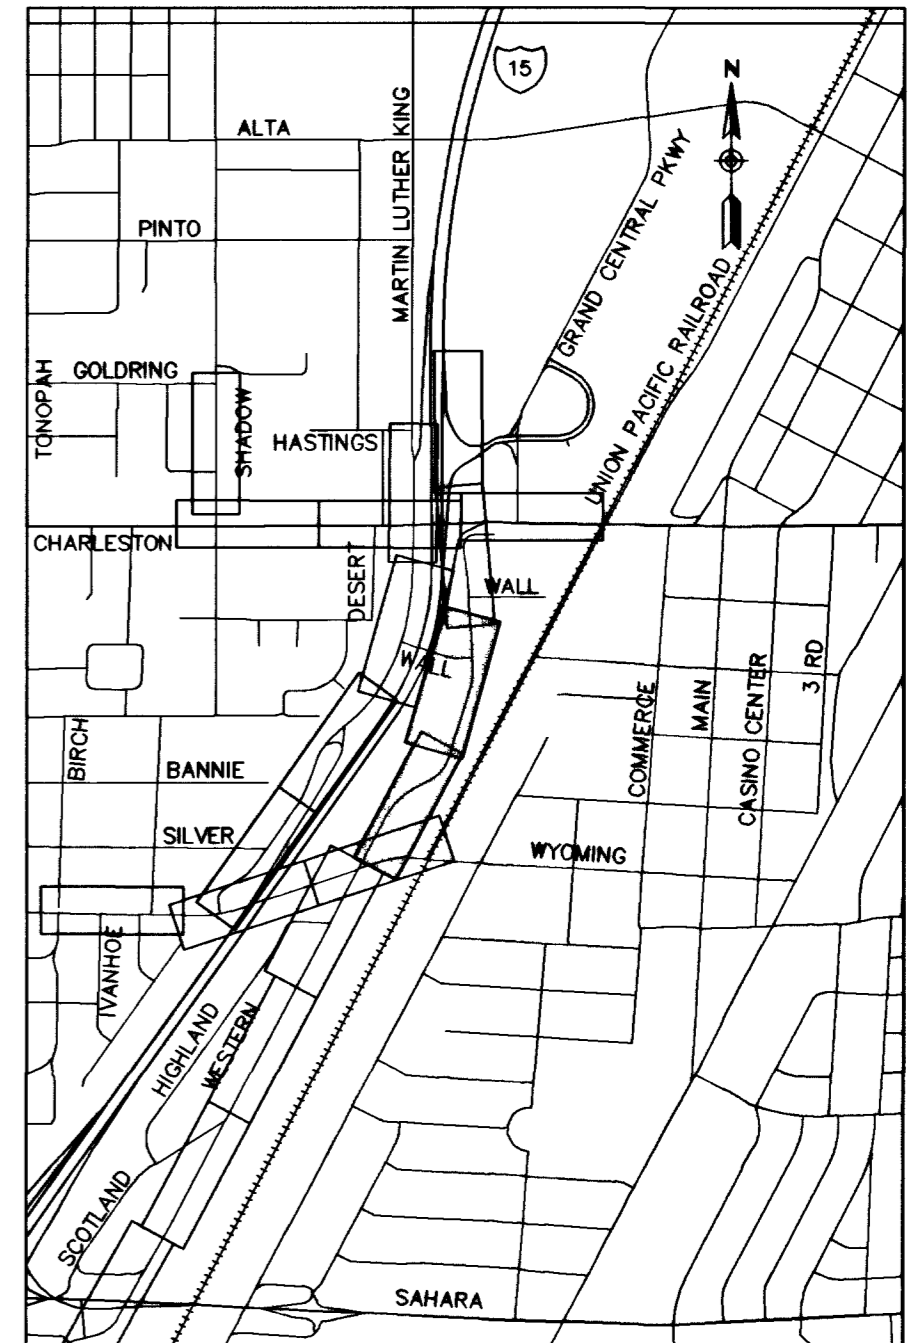


DATE	REVISIONS	PROJECT #	SCALE (V)	SCALE (H)	F.L.D. BK. #
4/30/03		31604	N/A	1:500	N/A
	RECORD DRAWING	DESIGN BY KFN			
		DEC 17, 1999			

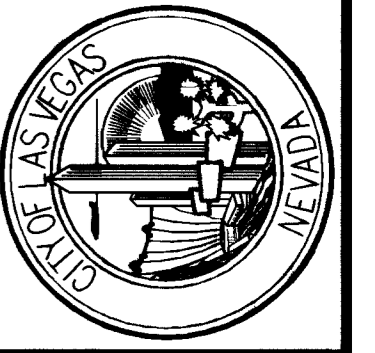

DEPARTMENT OF PUBLIC WORKS

I-15 FREEWAY CHANNEL  
SIGNING AND STRIPING PLAN  
"W" 1+400 TO "W" 1+980

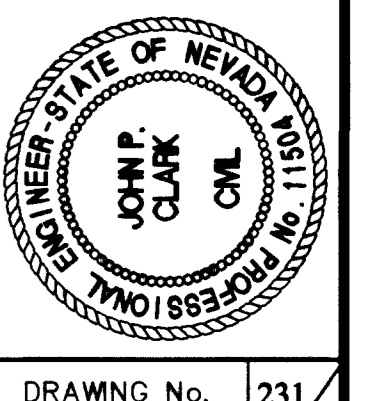

DRAWING No. 231

T-7 241

51600