


LEGEND:


- ≡≡≡ PORTABLE PRECAST CONCRETE BARRIER RAIL
- ∞ TEMPORARY IMPACT ATTENUATOR (70KM/H)
- TEMPORARY CONSTRUCTION SIGN
- ▶ TRAFFIC DRUM AT 9.0m SPACING

TEMPORARY PAVEMENT DELINEATION LEGEND


- ① 200mm SOLID WHITE LINE
- ② 200mm SOLID YELLOW LINE

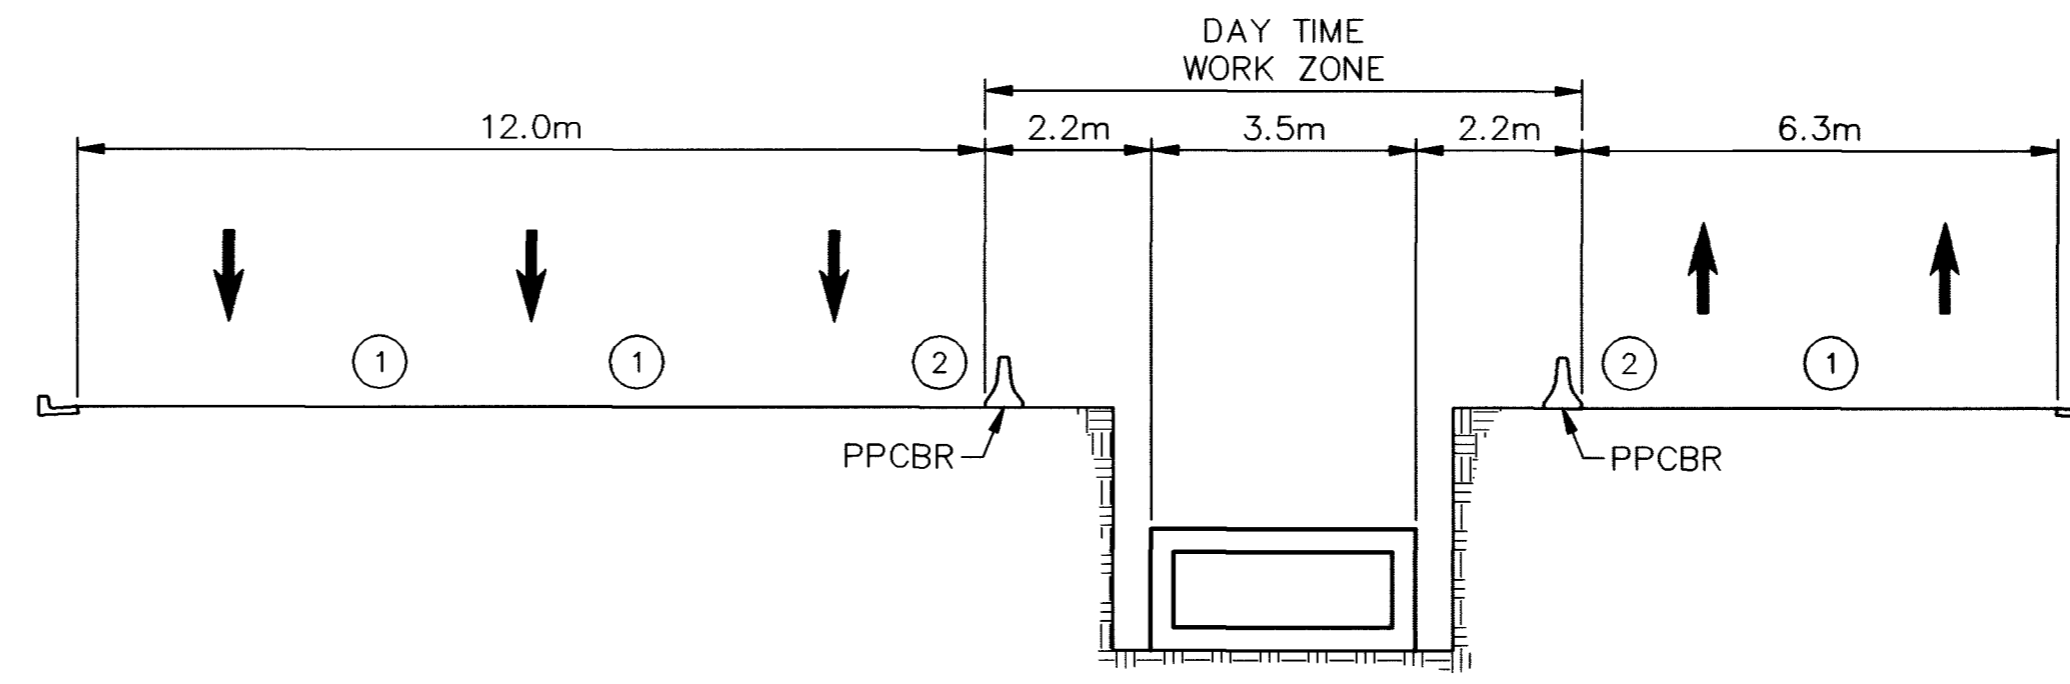

SECTION A-A

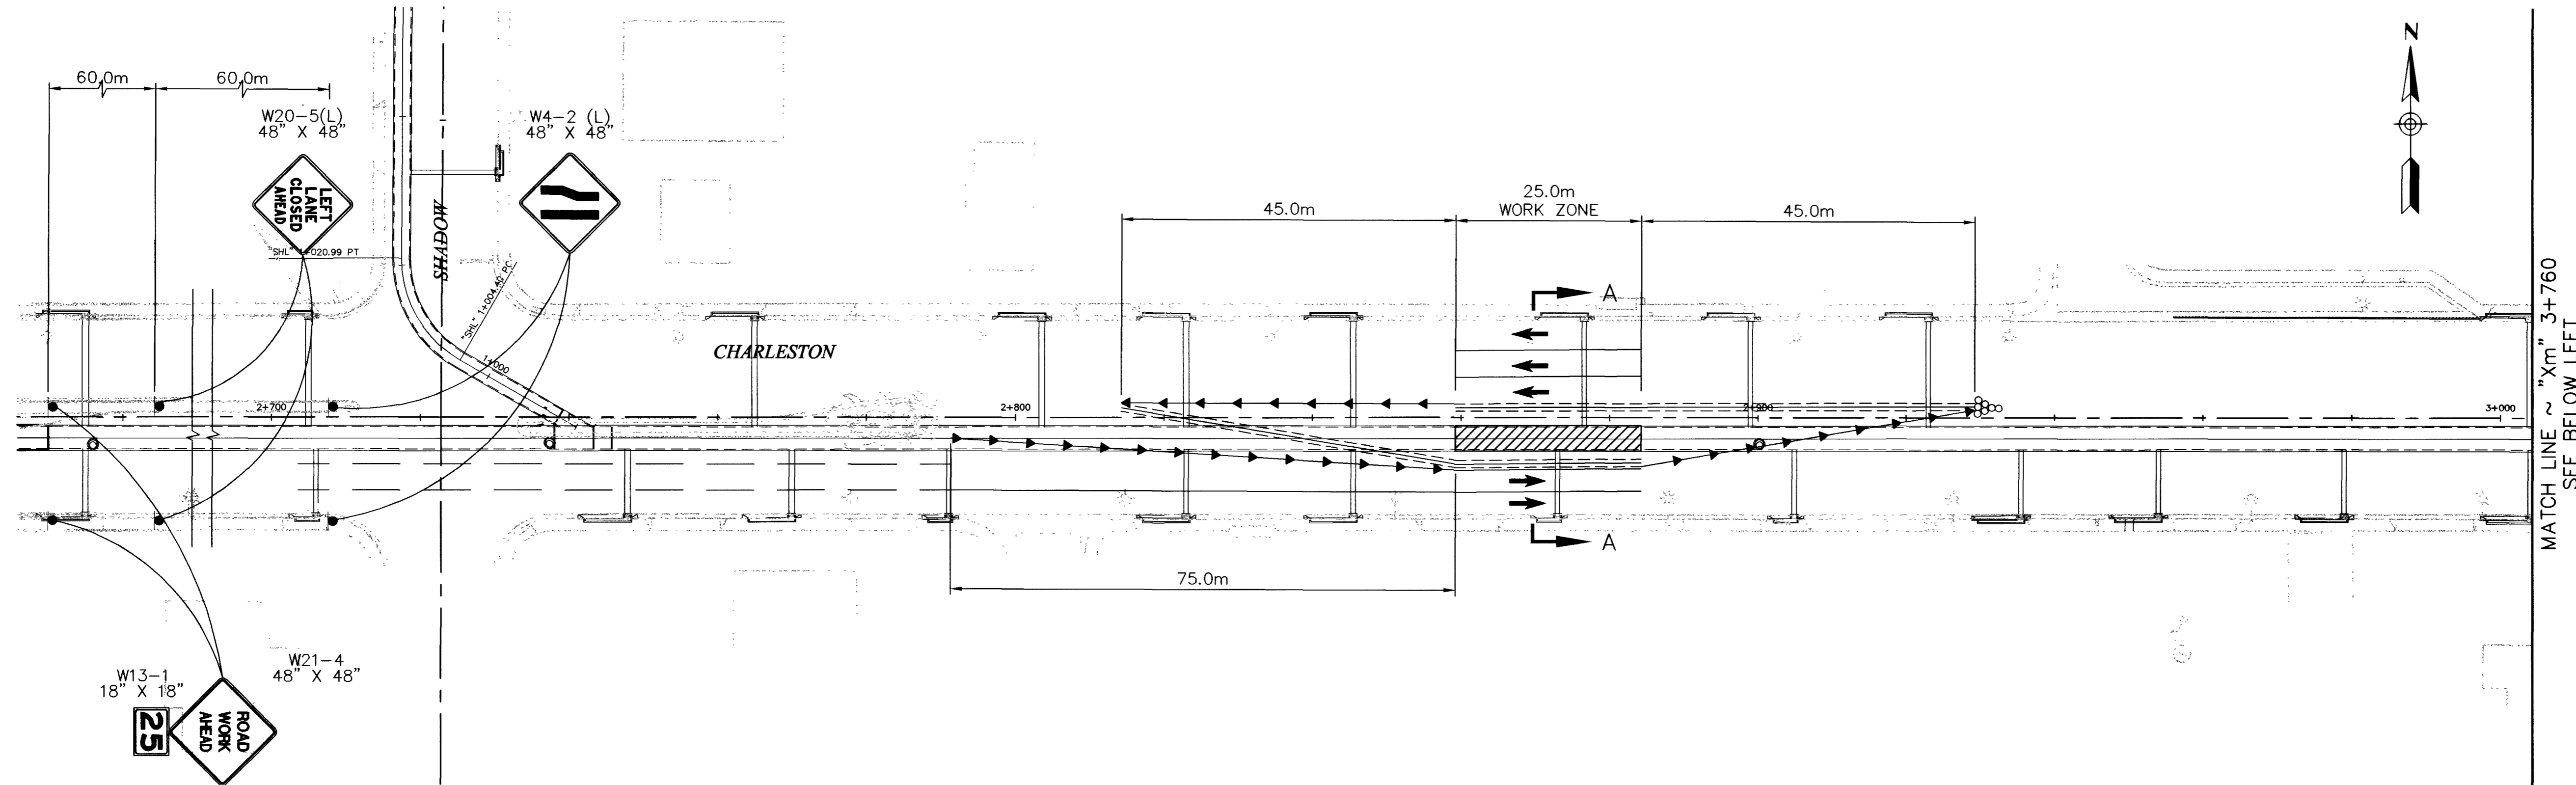

MATCH LINE ~ "Xm" 3+760
SEE BELOW LEFT

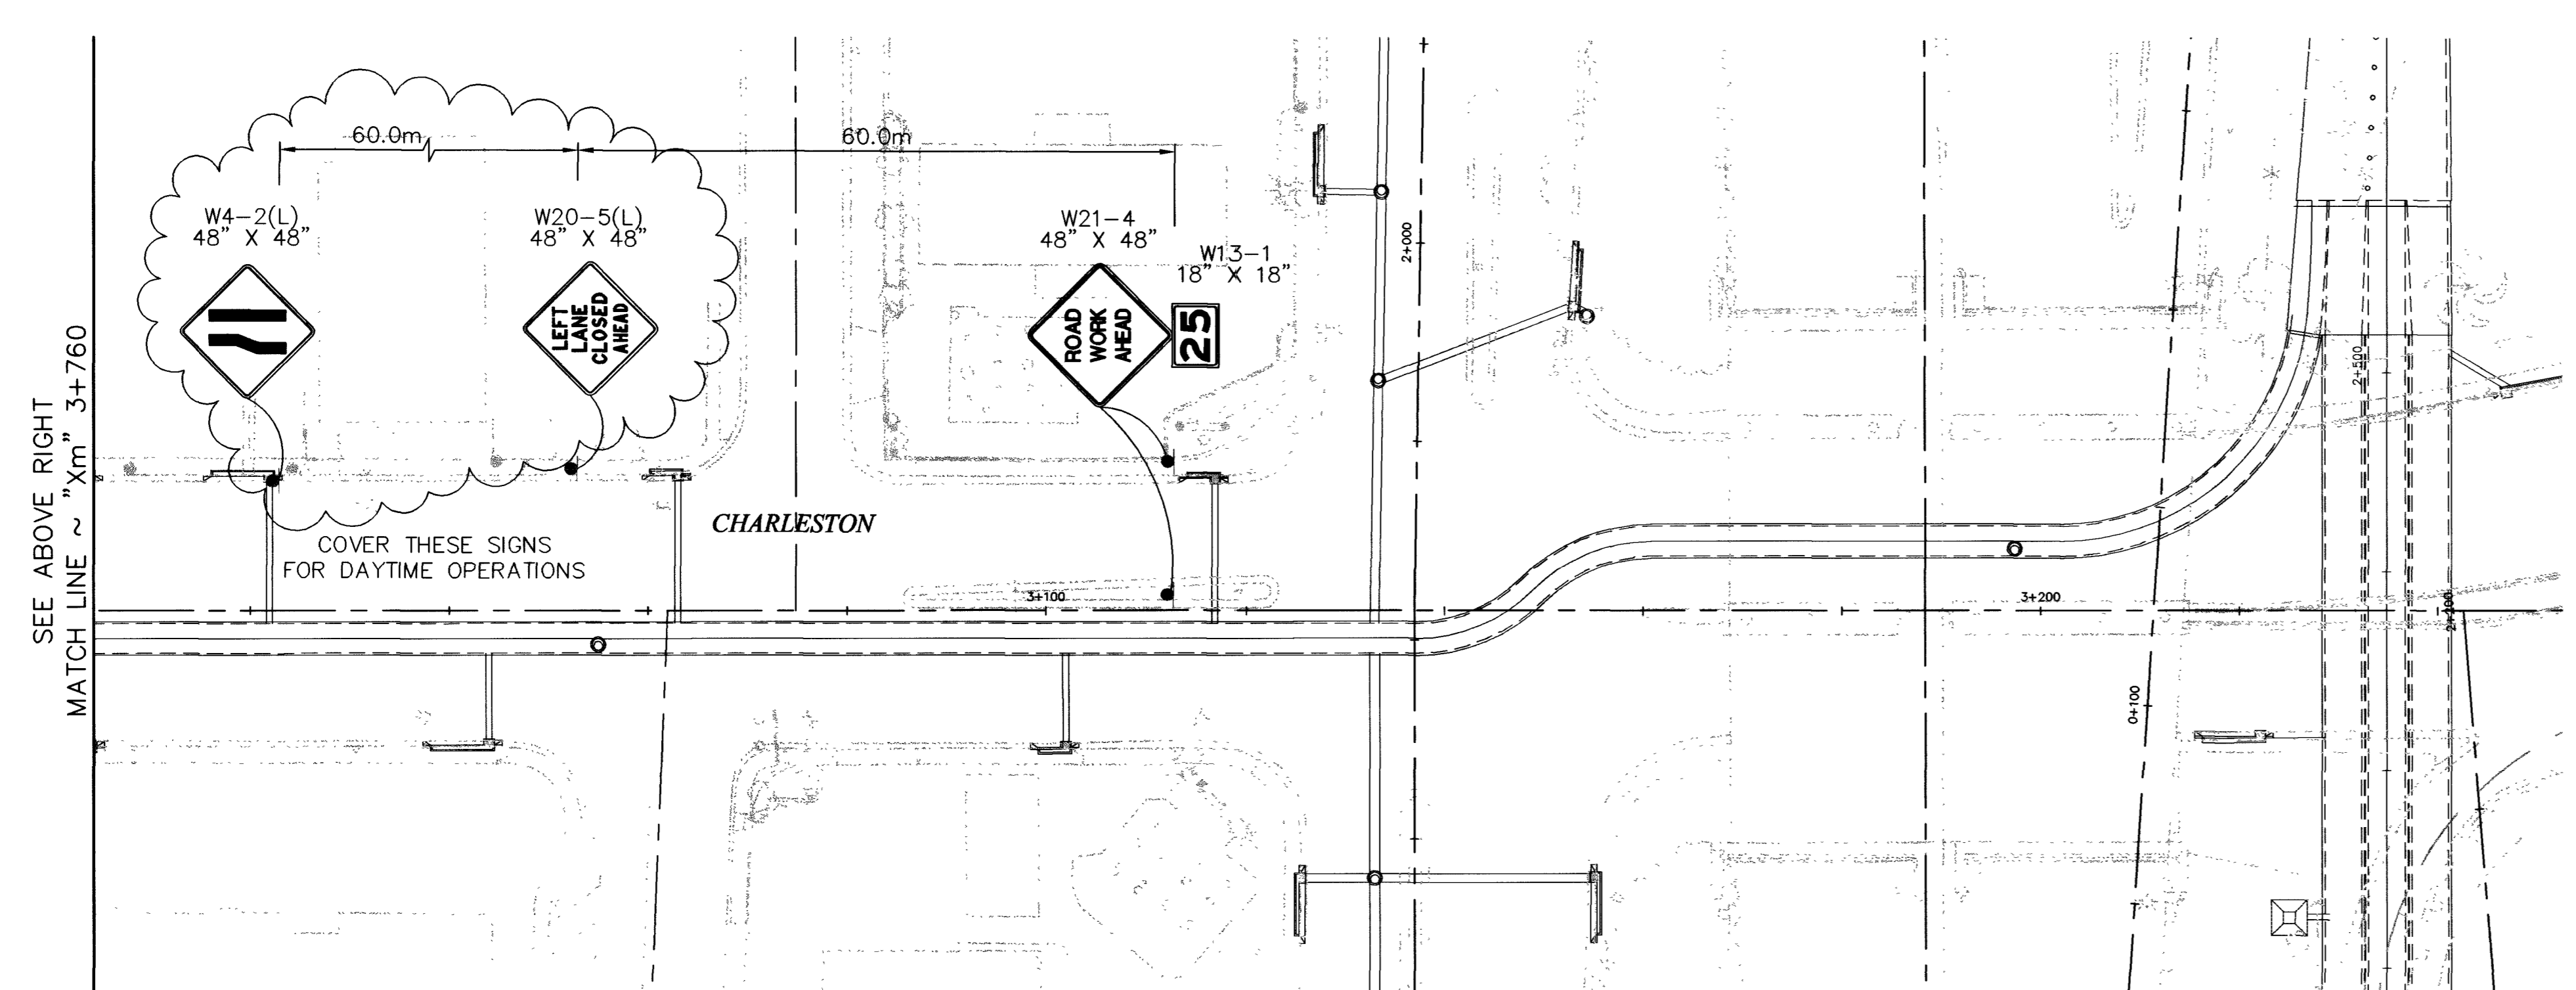

SEE ABOVE RIGHT
MATCH LINE ~ "Xm" 3+760

COVER THESE SIGNS
FOR DAYTIME OPERATIONS

Call before you Dig.
1-800-277-2600
UNDERGROUND SERVICE (USA)
CLARK COUNTY ROAD MAINTENANCE MANAGEMENT
702-455-7540
AND
CLARK COUNTY TRAFFIC MANAGEMENT
702-455-7511


REVISIONS	DATE
RECORD DRAWING	4/30/03

PROJECT # 31604
SCALE (V) N/A
SCALE (H) N/A
DATE DEC 17, 1999
DESIGN BY DMR
F.L.D. # N/A

PARSONS BRINCKERHOFF
Las Vegas, Nevada



DEPARTMENT OF PUBLIC WORKS
I-15 FREEWAY CHANNEL
CHARLESTON BLVD
DAYTIME TRAFFIC CONTROL

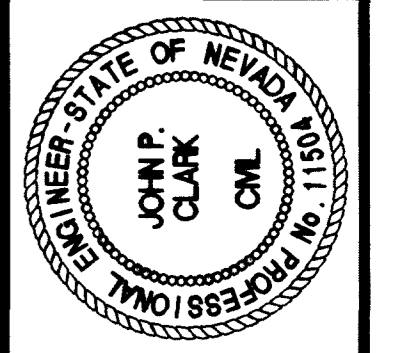

DRAWING No. 221
TC-14 241

RECORD DRAWING METRIC