



DATE	REVISIONS
4/30/03	RECORD DRAWING

SCALE (H)	N/A	SCALE (V)	N/A	PROJECT #	31604
FLD. BK. #	N/A	DATE	DEC 17, 1999	DESIGN BY	DWR

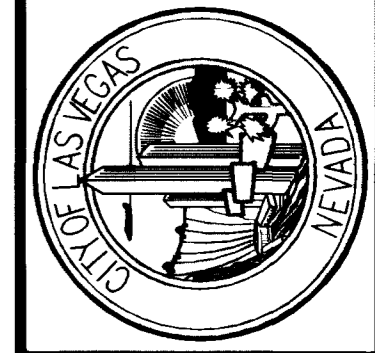

DEPARTMENT OF PUBLIC WORKS
I-15 FREEWAY CHANNEL
TRAFFIC DETOUR PLAN FOR
MARTIN L KING BLVD CLOSURE

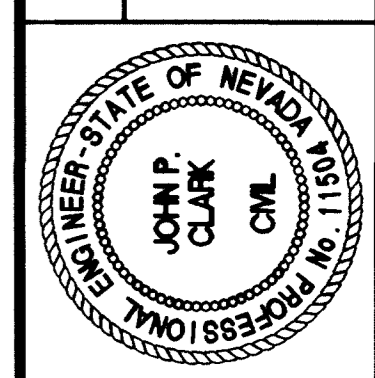

DRAWING No. 224
 241

RECORD DRAWING METRIC

TC-17