



PERMANENT PAVEMENT DELINEATION LEGEND

- ① TYPE 1 CENTERLINE PER CCPW USD DWG 244
- ② TRANSITION SECTION PER CCPW USD DWG 245
- ④ TYPE 4 LANE LINE PER CCPW USD DWG 244A

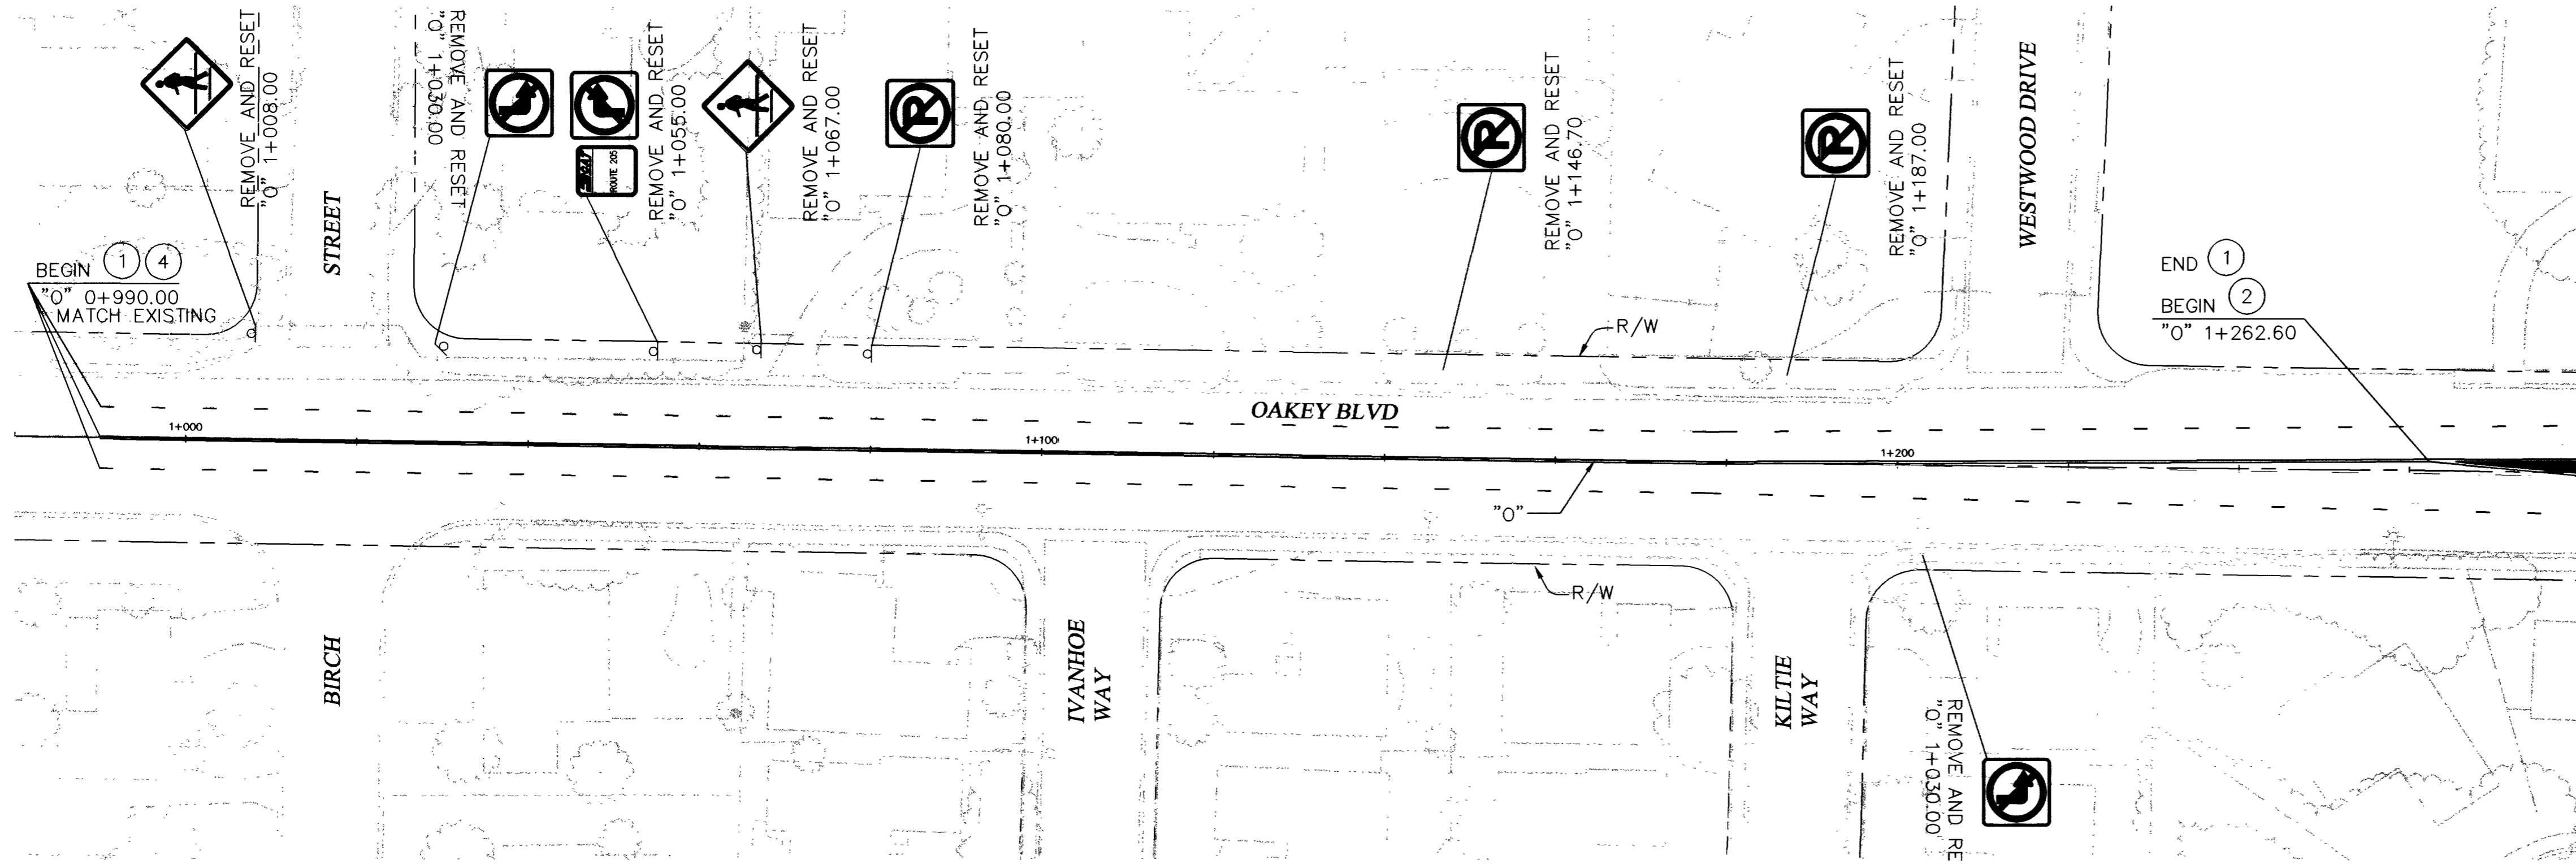


**Call before you Dig.**  
1-800-277-2600  
UNDERGROUND SERVICE (USA)

**Call before you Overhead.**  
563-6111  
OVERHEAD SERVICE (USA)

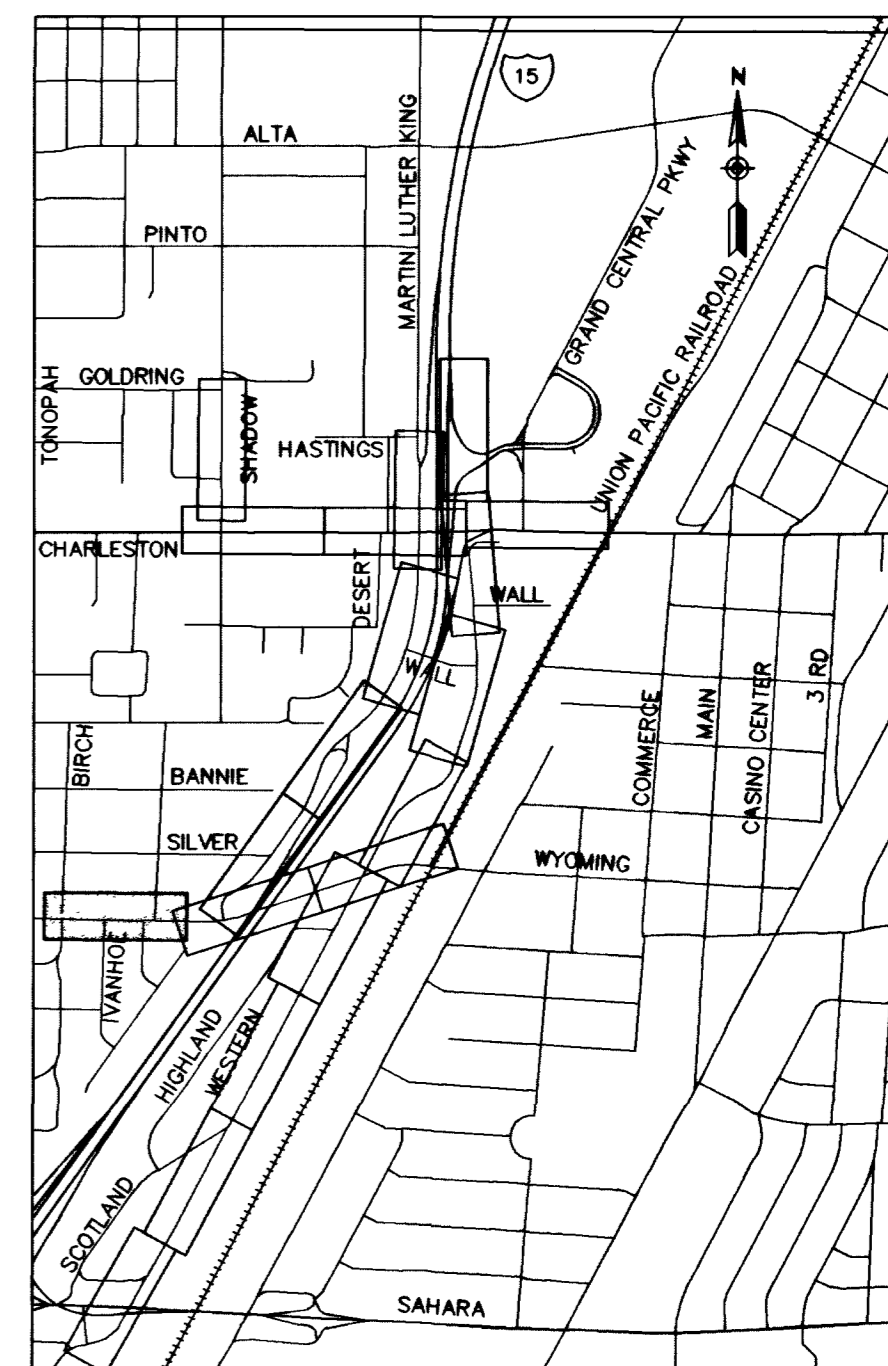


DATE	REVISIONS
4/20/03	RECORD DRAWING

SCALE (H) 1:500	SCALE (V) N/A	PROJECT # 31604
F.L.D. BK. # N/A	DATE DEC 17, 1999	DESIGN BY KFN

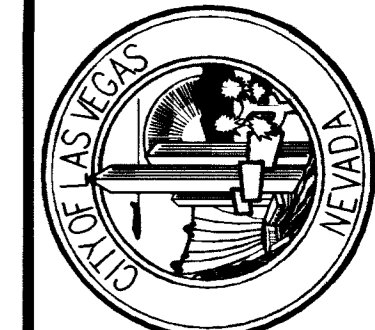

**DEPARTMENT OF PUBLIC WORKS**  
I-15 FREEWAY CHANNEL  
SIGNING AND STRIPING PLAN  
"0" 0+990 TO "0" 1+280

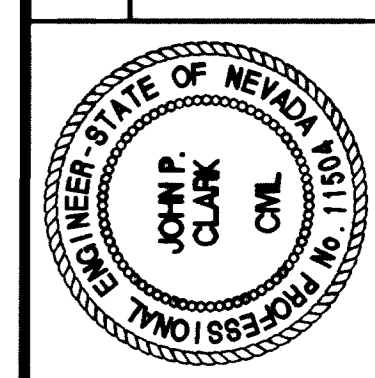

DRAWING No. 227  
T-3 241

RECORD DRAWING METRIC