

- REMOVAL ITEMS**
- [F] REMOVE AC PAVEMENT
  - [T] REMOVE MH
  - [W] MAINTAIN AND RESTORE TRAFFIC SIGNAL
- CONSTRUCTION ITEMS**
- ① "Xm" 3+710.000, 11.462m RT TO "Xm" 3+810.222, 11.795m RT  
"Xm" 3+810.222, 11.795m RT TO "Xm" 3+860.000, 11.919m RT  
CONSTRUCT 750mm SANITARY SEWER PIPE
  - ② "Xm" 3+810.222, 11.795m RT  
CONSTRUCT TYPE I SANITARY SEWER MH
  - ③ "Xm" 3+802.760, 19.250m RT  
"Xm" 3+805.240, 9.240m RT  
RELOCATE 400mm DIP
- MATERIALS LIST**
- ① INSTALL 400mm DIA, 45' HORIZONTAL BEND
  - ② CONCRETE THRUST BLOCK  
SEE DRAWING U-41


DATE	REVISIONS
3/30/03	
7/15/03	
4/30/03	

APPENDIX 2  
 ① MODIFIED 750mm SS  
 RECORD DRAWING

PROJECT # 31604  
 SCALE (V) 1:50  
 DATE DEC. 17, 1999  
 DESIGN BY KFN

SCALE (H) 1:250  
 FLD. BK. # N/A

**PB PARSONS BRINCKERHOFF**  
 Las Vegas, Nevada

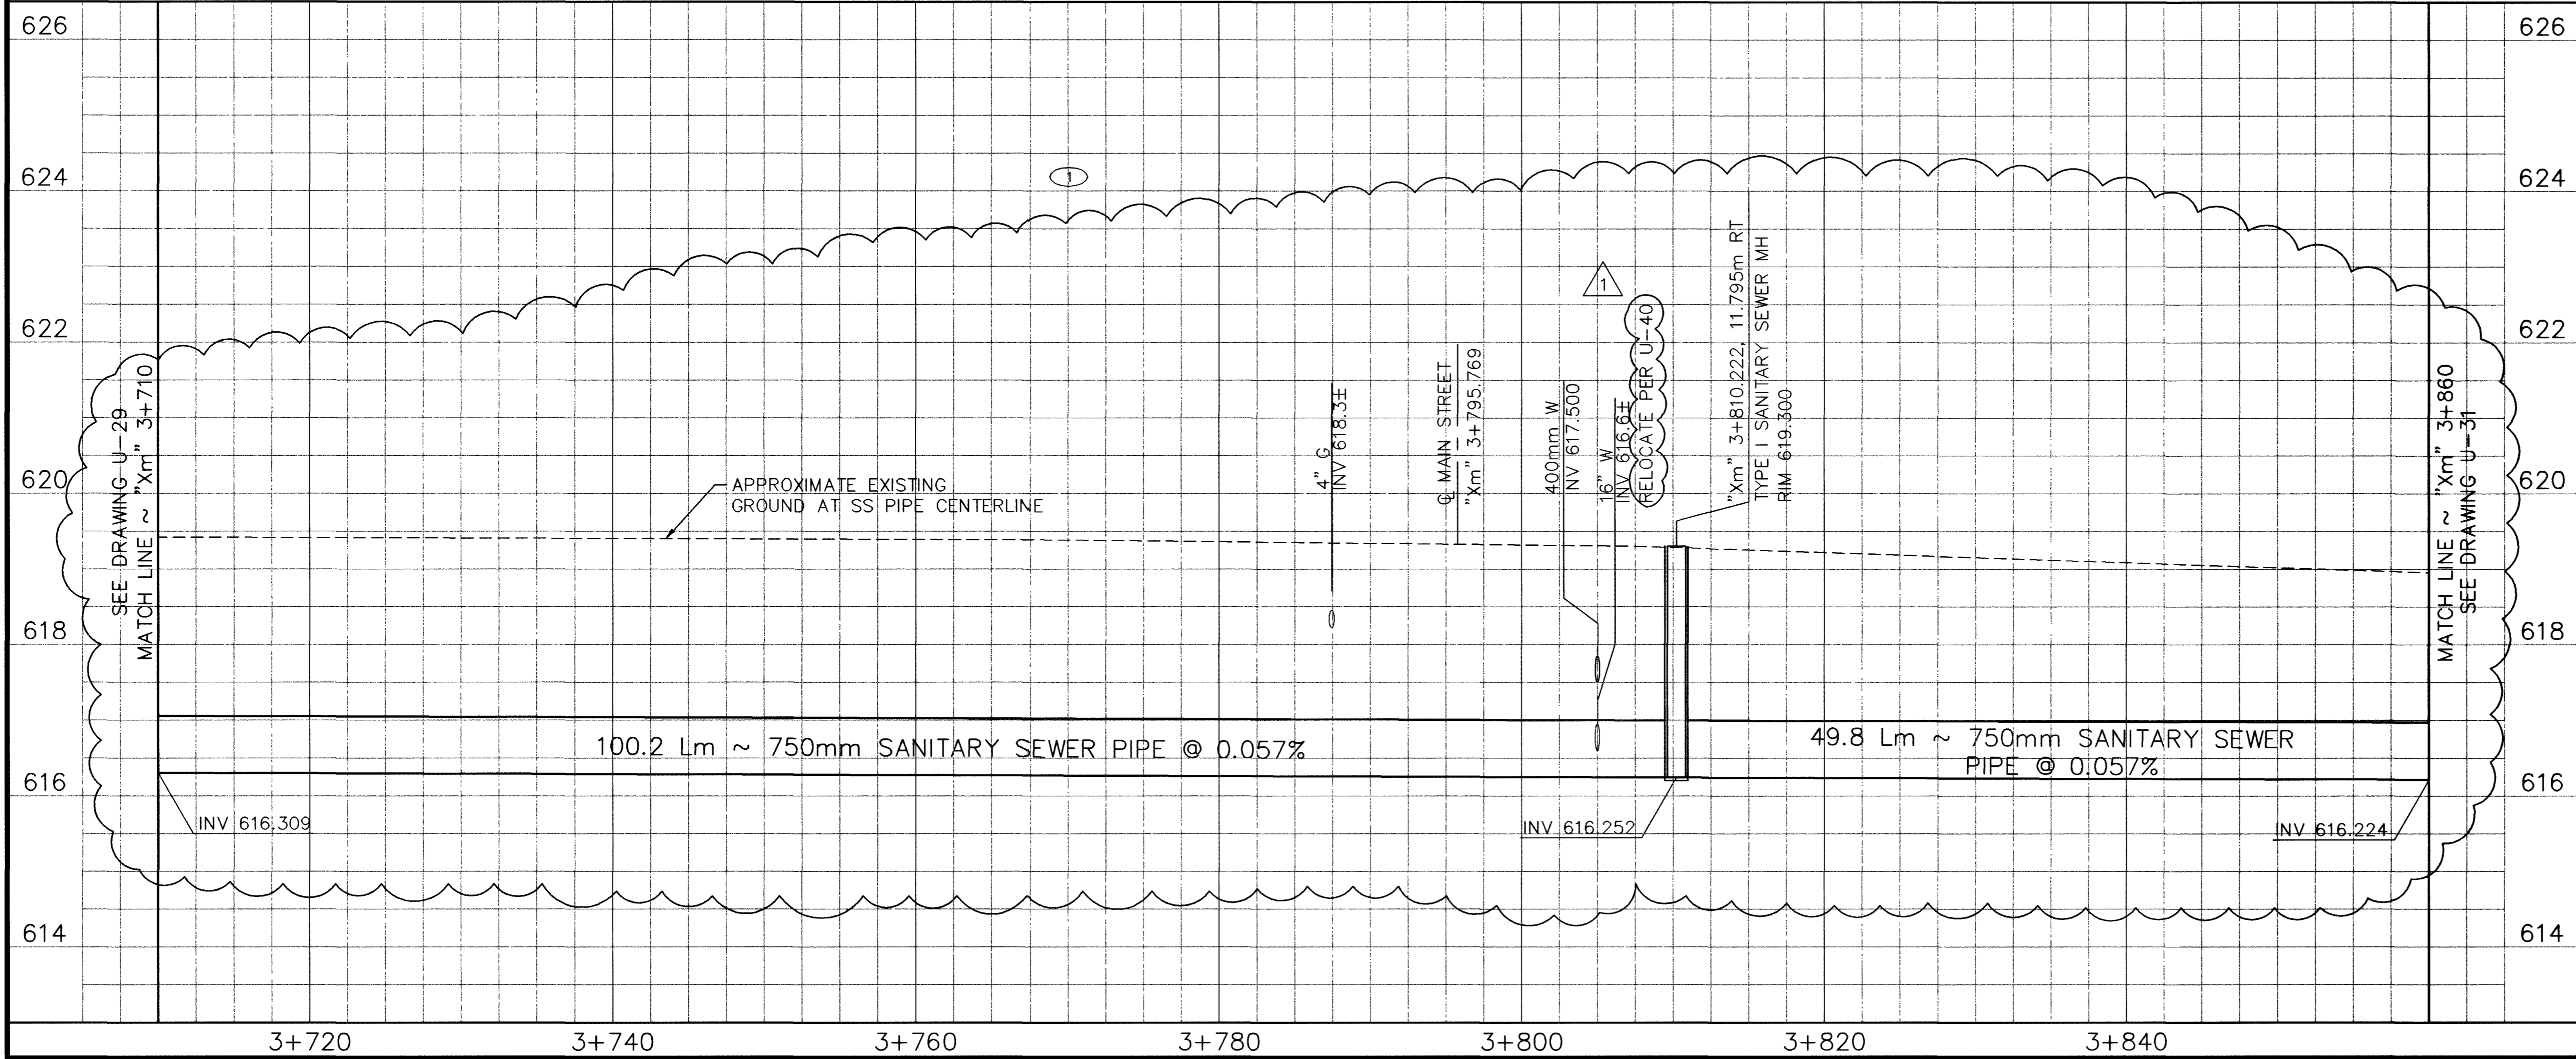


APPROVED FOR CONSTRUCTION

LAS VEGAS VALLEY WATER DISTRICT      DATE

**Call before you Dig.**  
 1-800-227-2600  
 UNDERGROUND SERVICE (USA)

**Call before you Crane.**  
 227-2929  
 OVERHEAD SERVICE (USA)

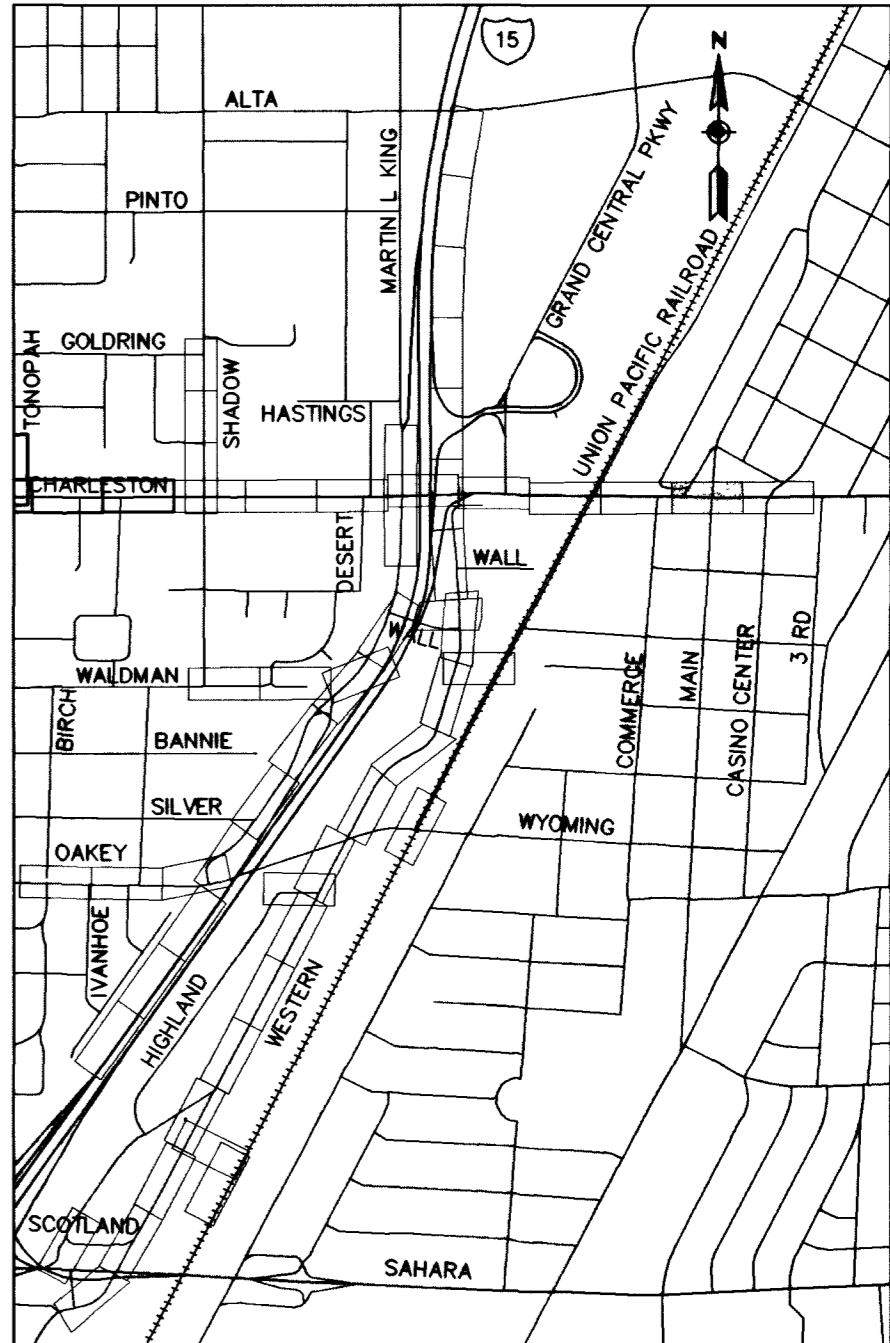


**DEPARTMENT OF PUBLIC WORKS**

**I-15 FREEWAY CHANNEL**

**UTILITY RELOCATION (CHARLESTON BLVD)**

"Xm" 3+710 TO "Xm" 3+860

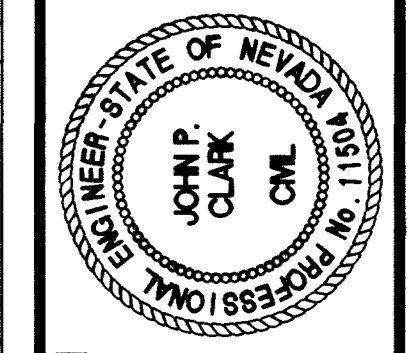

DRAWING No. 189  
**U-30**