



PHASE I: INSTALL TAPS AND VALVES, 750mm BYPASS LINE WITH AIR-VACS, BUMPED HEAD, AND CONCRETE ANCHOR / THRUST BLOCKS

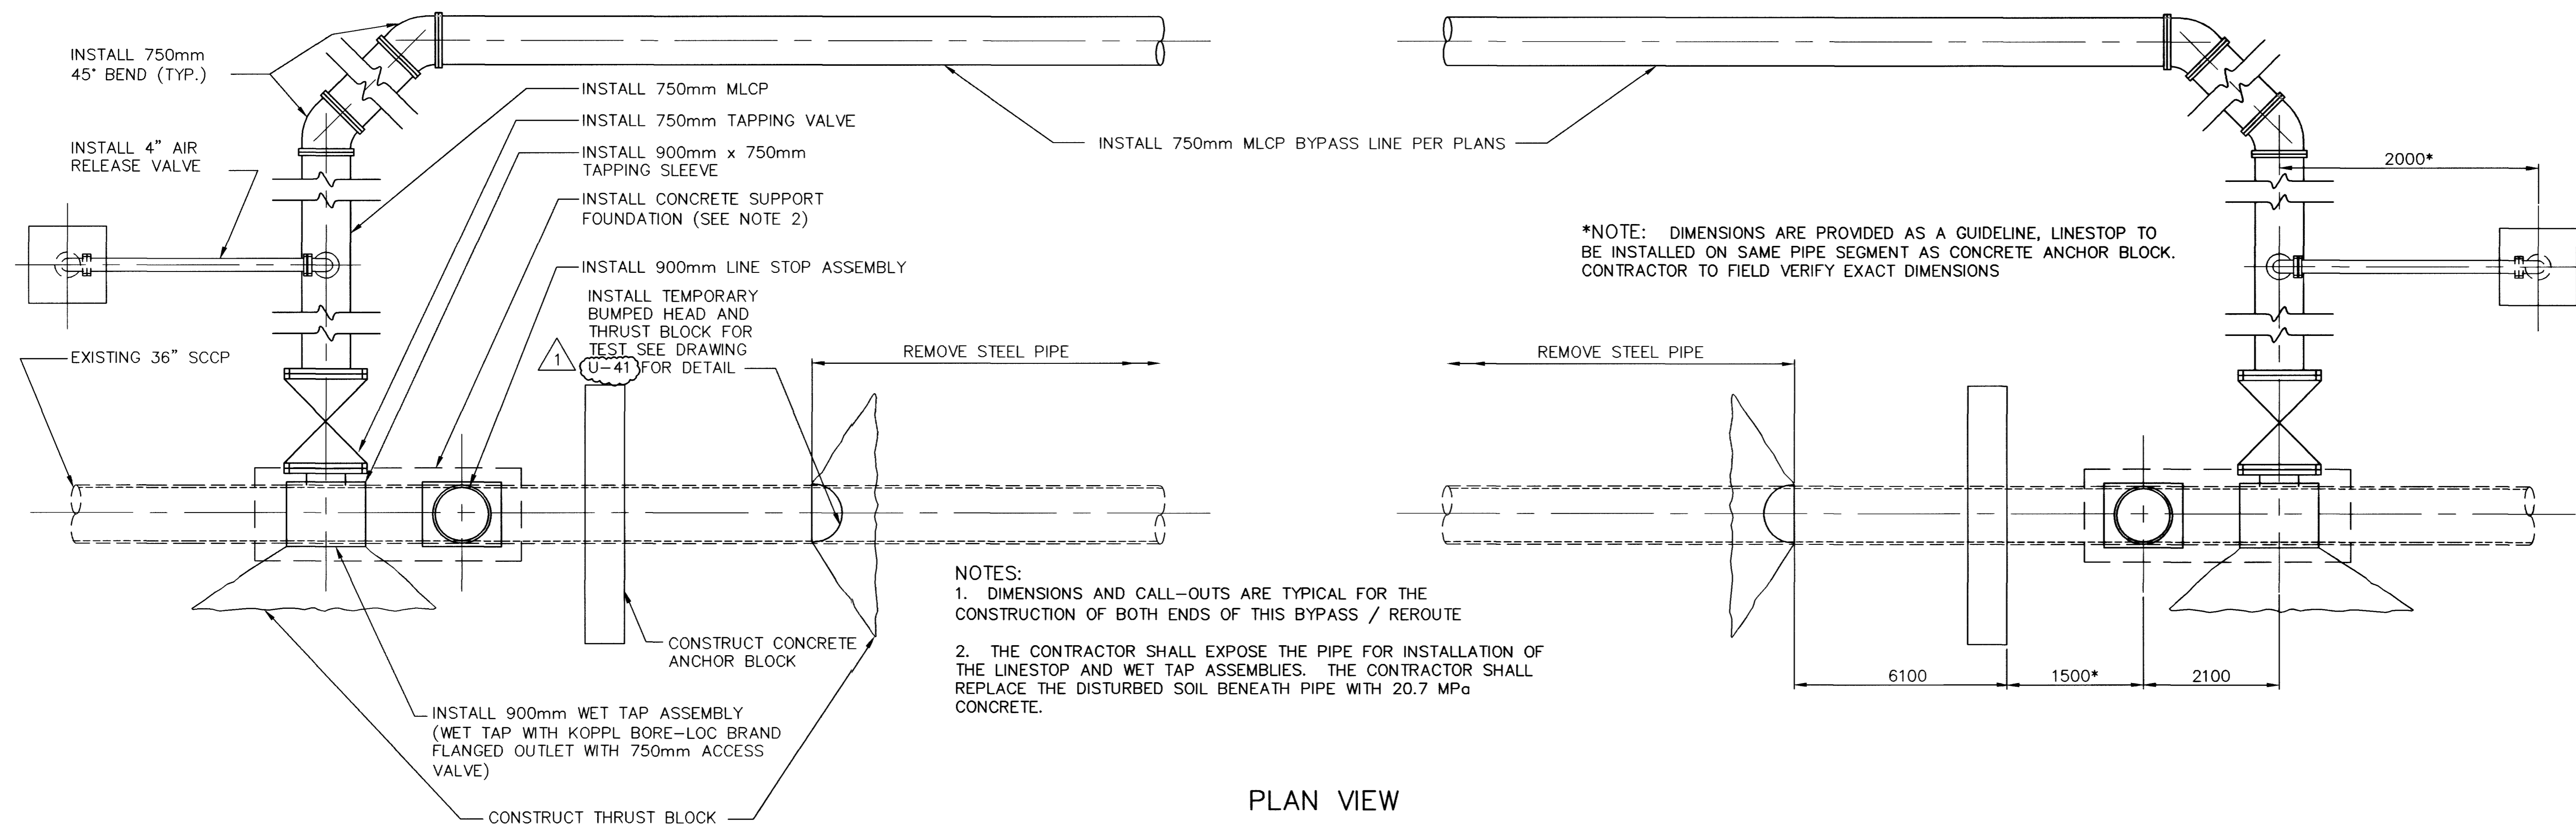

PLAN VIEW

PHASE II: REMOVE BUMPED HEAD AND THRUST BLOCK, CONNECT NEW 900mm MAIN

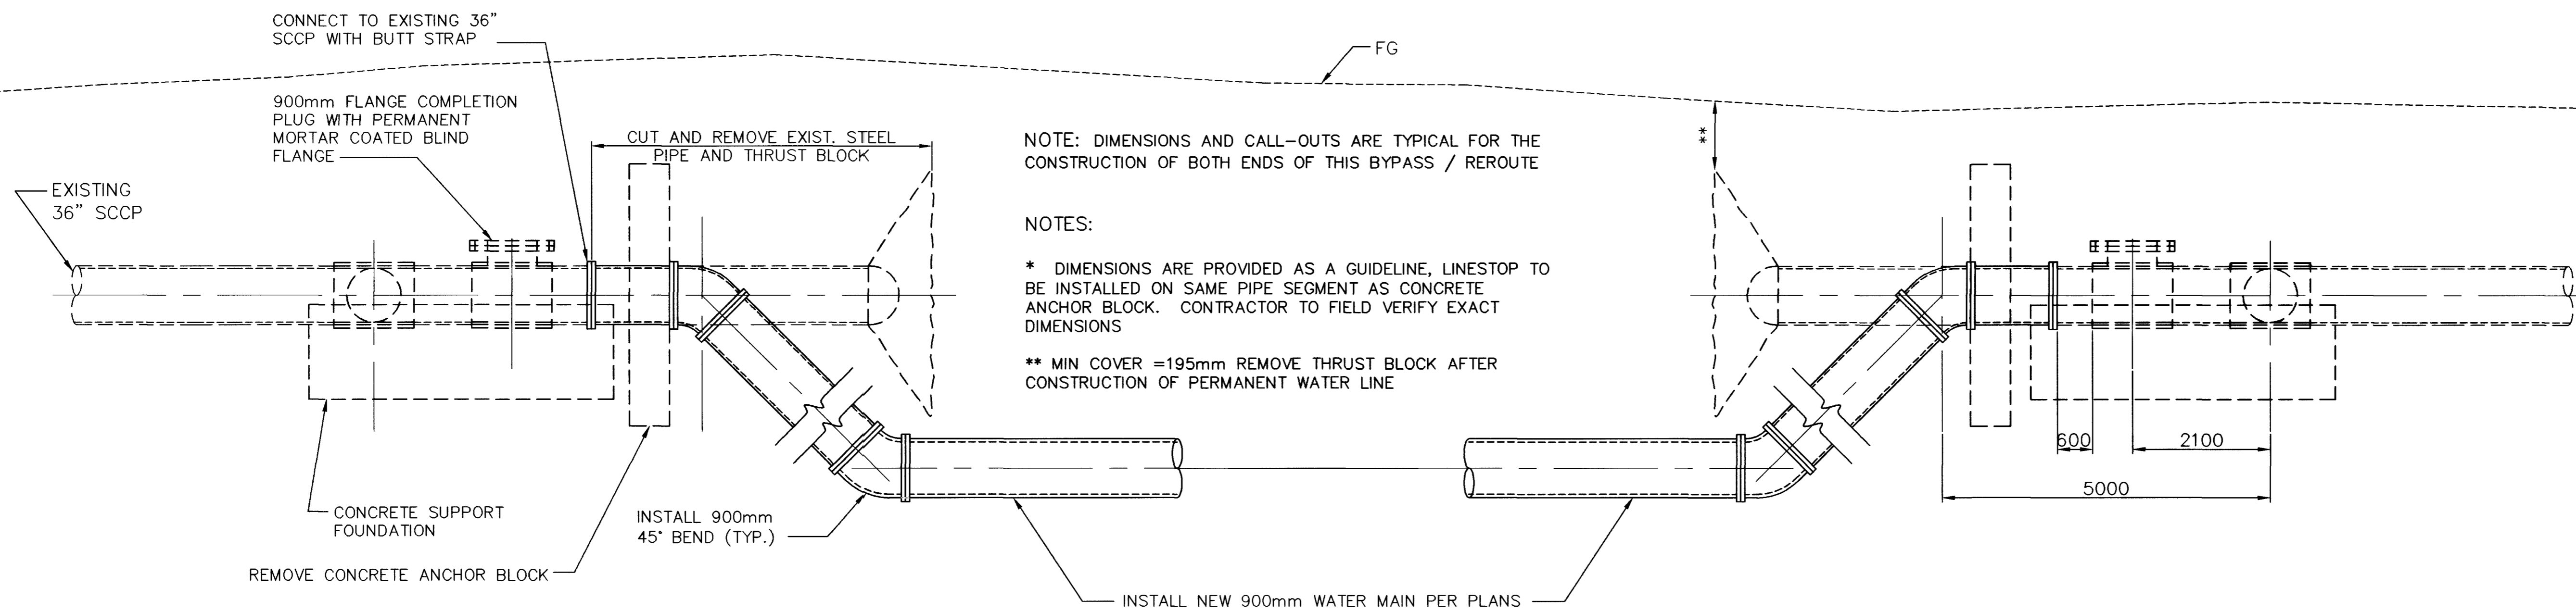

PROFILE VIEW

WET TAP ASSEMBLY DETAIL

APPROVED FOR CONSTRUCTION

LAS VEGAS VALLEY WATER DISTRICT DATE

DATE	5/30/00	REVISIONS	
	4/30/03		
PROJECT #	31804	DESIGN BY	BRP
SCALE (V)	N/A	DATE	DEC 17, 1999
SCALE (H)	1:50	DATE	
F.L.D. Bk. #	N/A		

ADDITIONAL RECORD DRAWING

PARSONS BRINCKERHOFF
Las Vegas, Nevada

STATE OF NEVADA
PLUMBING ENGINEER

DEPARTMENT OF PUBLIC WORKS
I-15 FREEWAY CHANNEL
WATER LINE DETAILS

ENGINEER
JOHN CLARK
No. 1180

DRAWING No. 198
U-39
241

RECORD DRAWING METRIC