



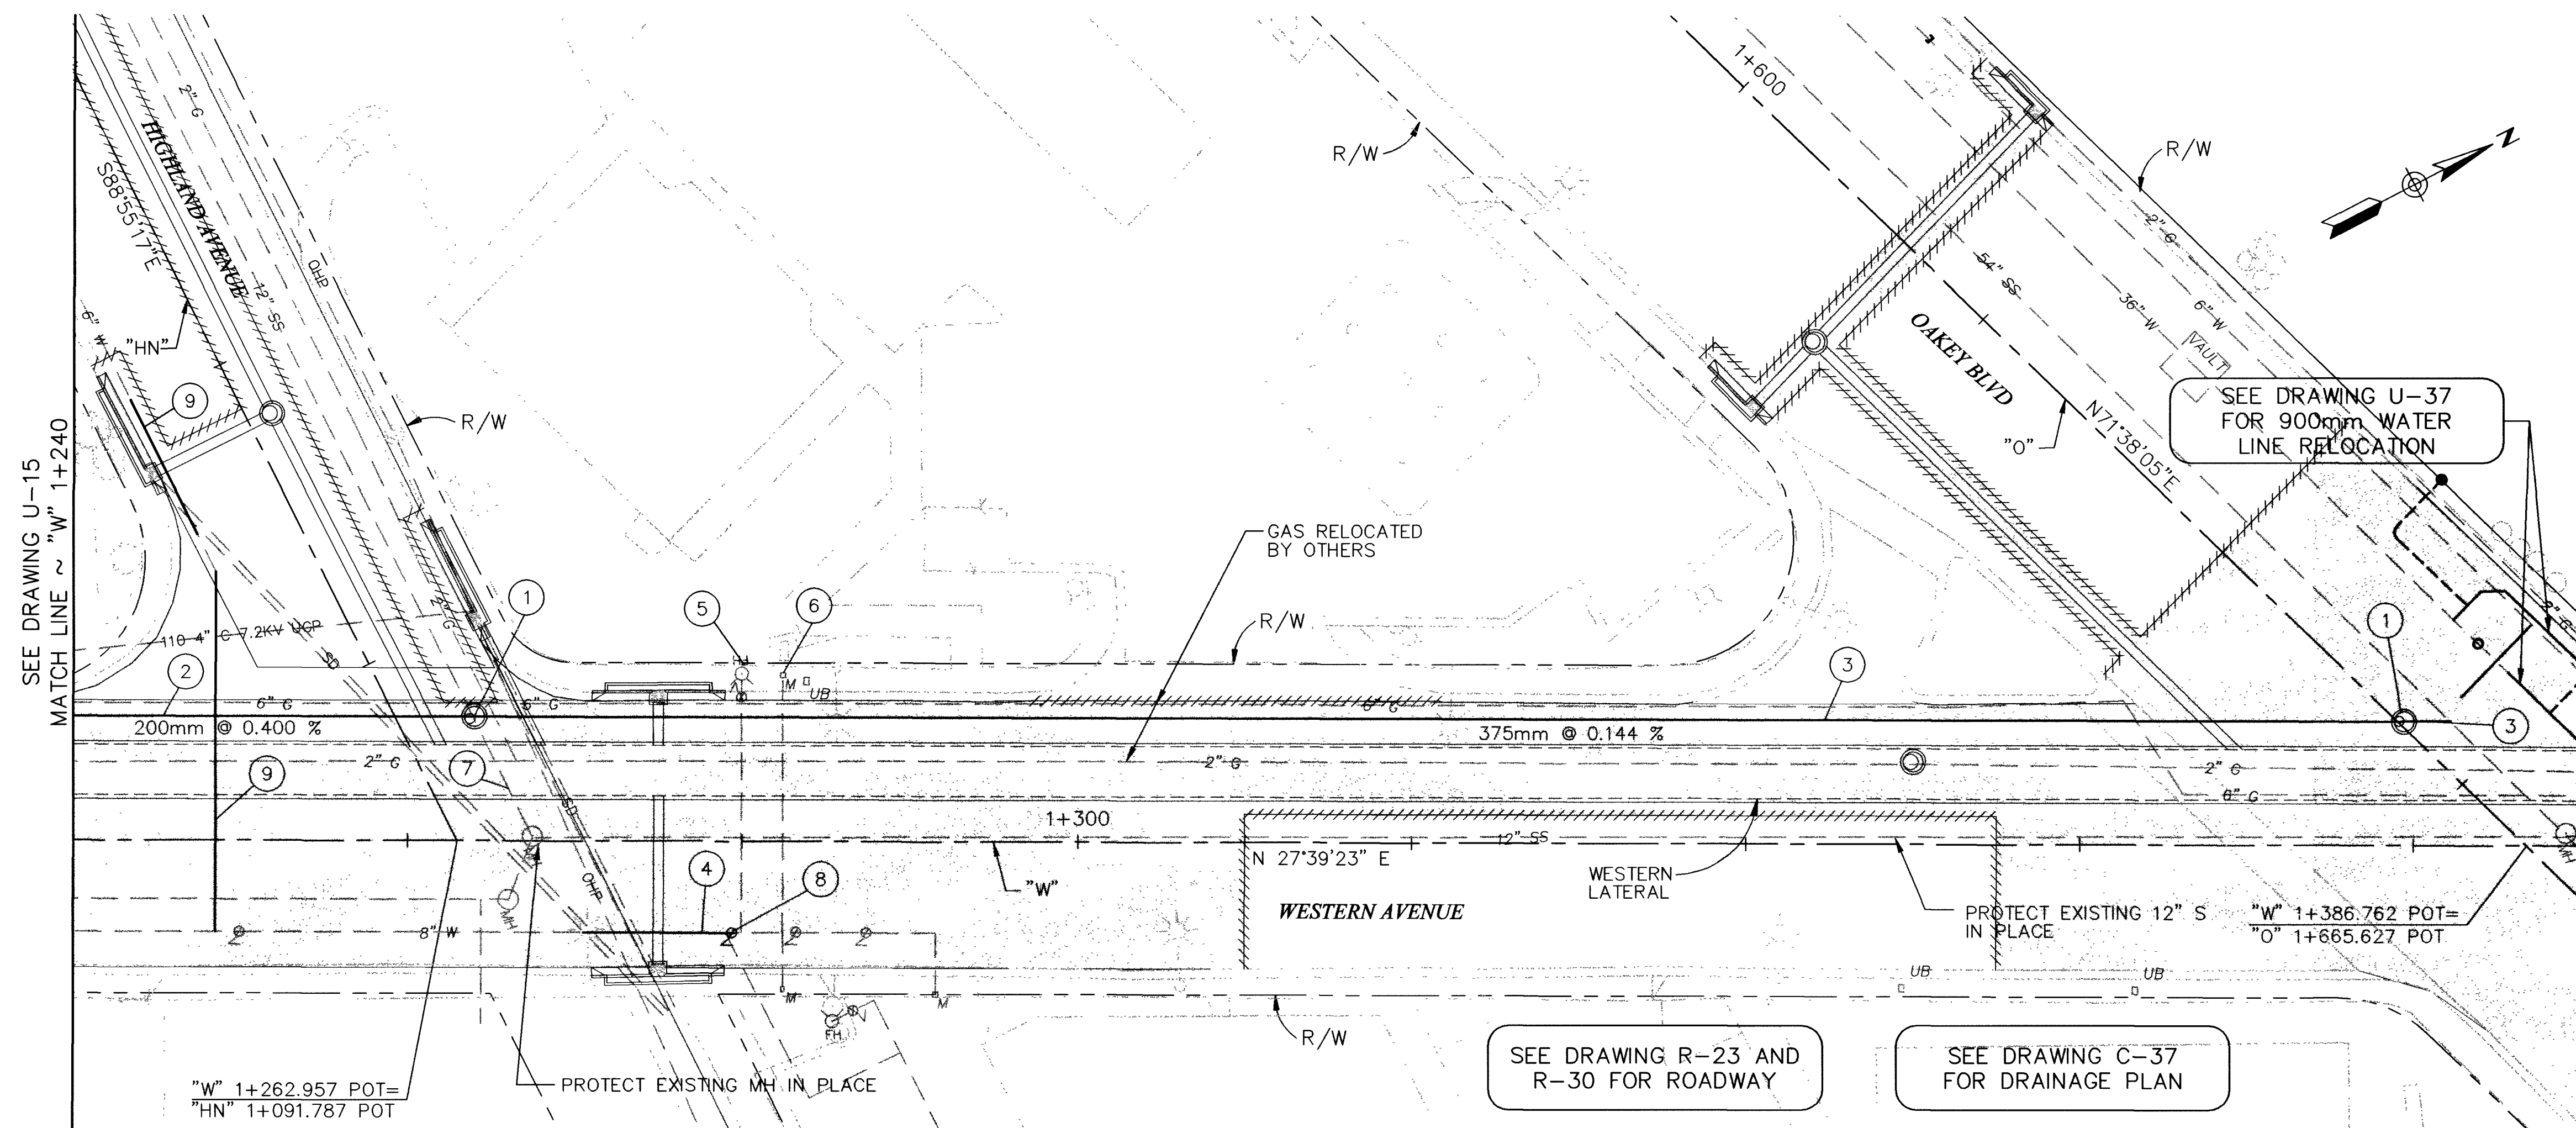

- ## CONSTRUCTION ITEMS
- | | | |
|---|---|---|
| ① | "W" 1+264.000, 7.410m LT
"W" 1+379.500, 7.410m LT | CONSTRUCT TYPE I SANITARY
SEWER MH |
| ② | "W" 1+240.000, 7.410m LT TO
"W" 1+264.000, 7.410m LT | CONSTRUCT 200mm
SANITARY SEWER PIPE |
| ③ | "W" 1+379.500, 7.410m LT TO
"W" 1+381.080, 7.410m LT | CONSTRUCT 375mm
SANITARY SEWER PIPE |
| ④ | "W" 1+270.500, 5.500m RT TO
"W" 1+279.500, 5.500m RT | RELOCATE 200mm WATER LINE
SEE DETAIL U-40 |
| ⑤ | "W" 1+280.000, 10.600m LT | RECONNECT EX FIRE HYDRANT
PER LVVWD UDS PLATE No. 7 |
| ⑥ | "W" 1+282.220 LT | RECONNECT EX WATER SERVICE
PER LVVWD UDS PLATE
No. 1B OR 1D |
| ⑦ | "W" 1+267.200, 0.810m LT | DISCONNECT AND PLUG
EX 12" SANITARY SEWER PIPE |
| ⑧ | "W" 1+279.500, 5.000m RT | INSTALL 150mm GATE VALVE |
| ⑨ | "HN" 1+059.500, 5.500m RT TO
"HN" 1+068.500, 5.500m RT
"W" 1+248.530, 16.086m LT TO
"W" 1+248.530, 5.486m RT | RELOCATE 150mm WATER LINE
SEE DETAIL U-40 |

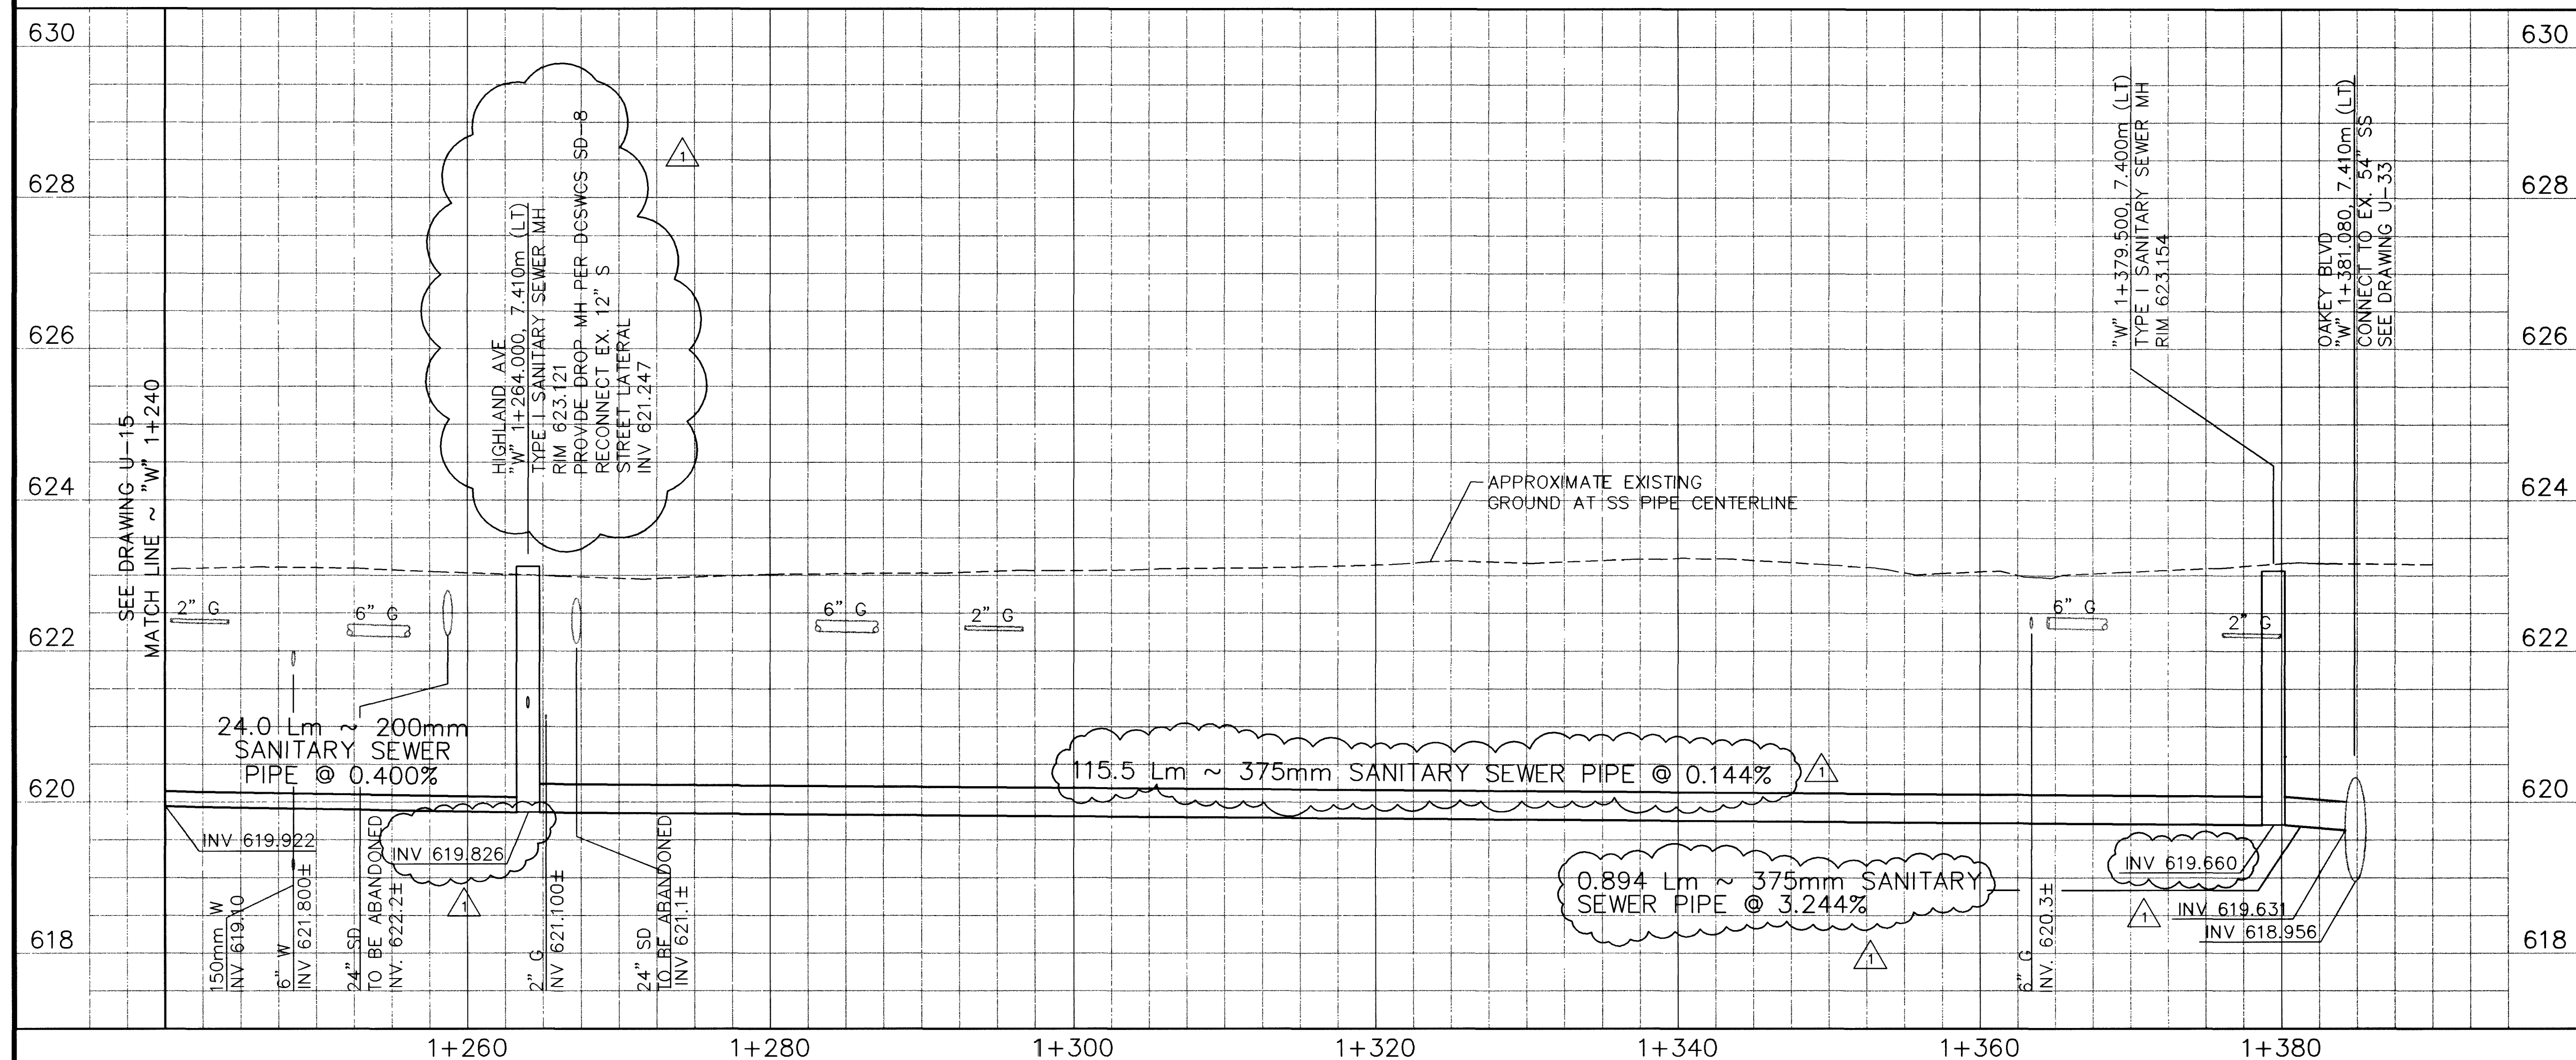


APPROVED FOR CONSTRUCTION

LAS VEGAS VALLEY WATER DISTRICT

**Call
before you
Dig.
1-800-277-2600
UNDERGROUND SERVICE (USA)**

**Call
before you
Overhead
563-6111**

OVERHEAD SERVICE (USA)

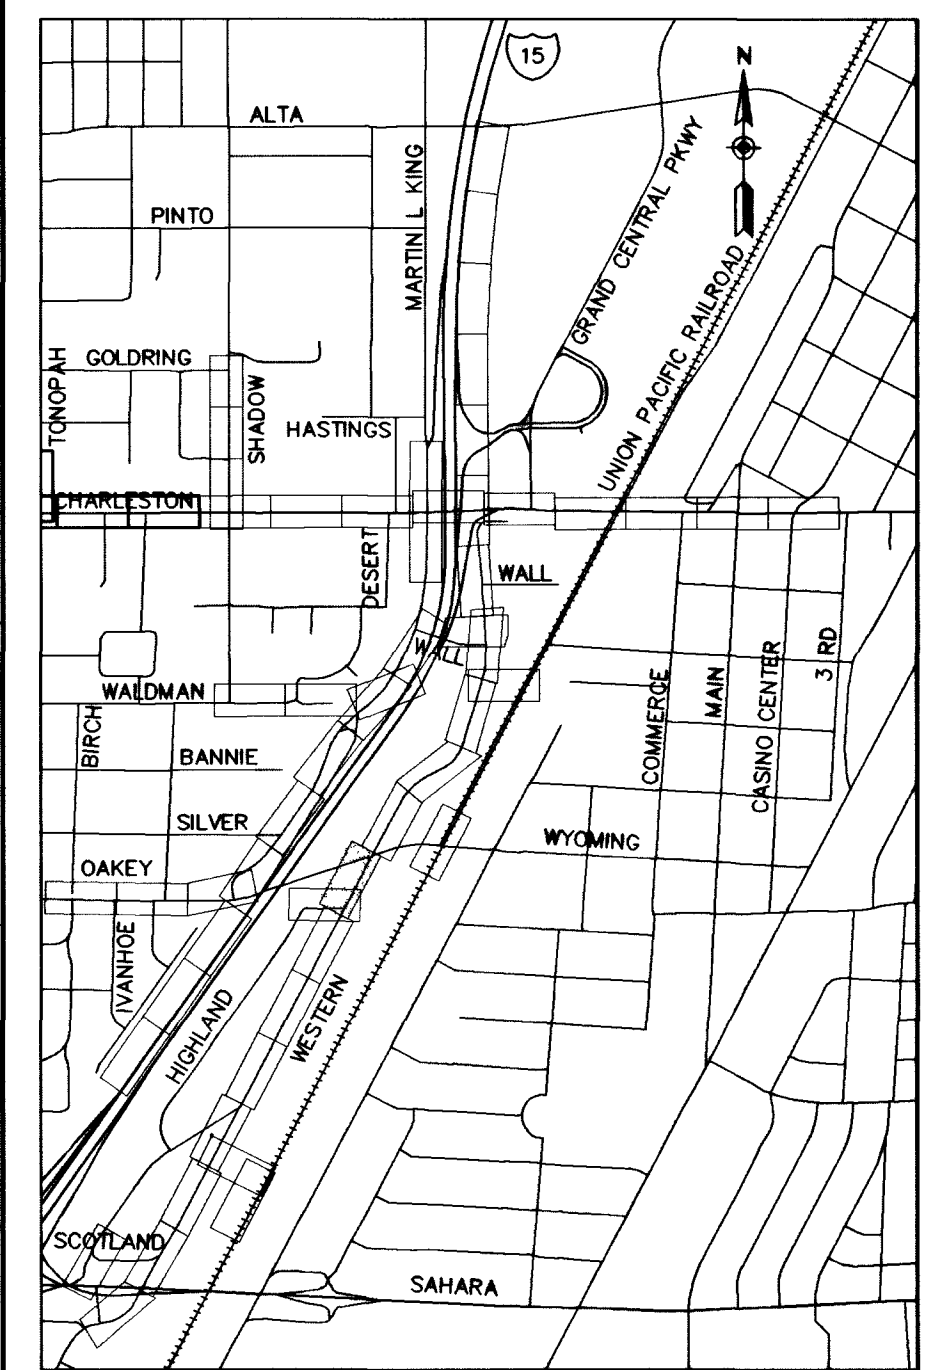


RECORD DRAWING METRIC

DEPARTMENT OF PUBLIC WORKS
115 FREEWAY CHANNEL

UTILITY RELOCATION (WESTERN AVE)
"W" 1+240 TO "W" 1+390

0
A
0
4
2
0
4
0
1
4
2

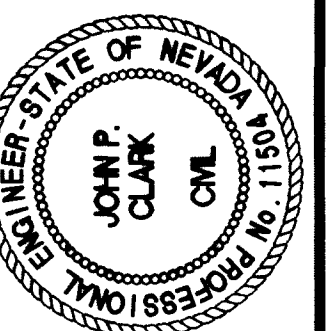

DRAWING No.	175
-------------	-----

J-16 / 241

327-V254