



SEE DRAWING U-19  
FOR PLAN VIEW

EAST PROFILE

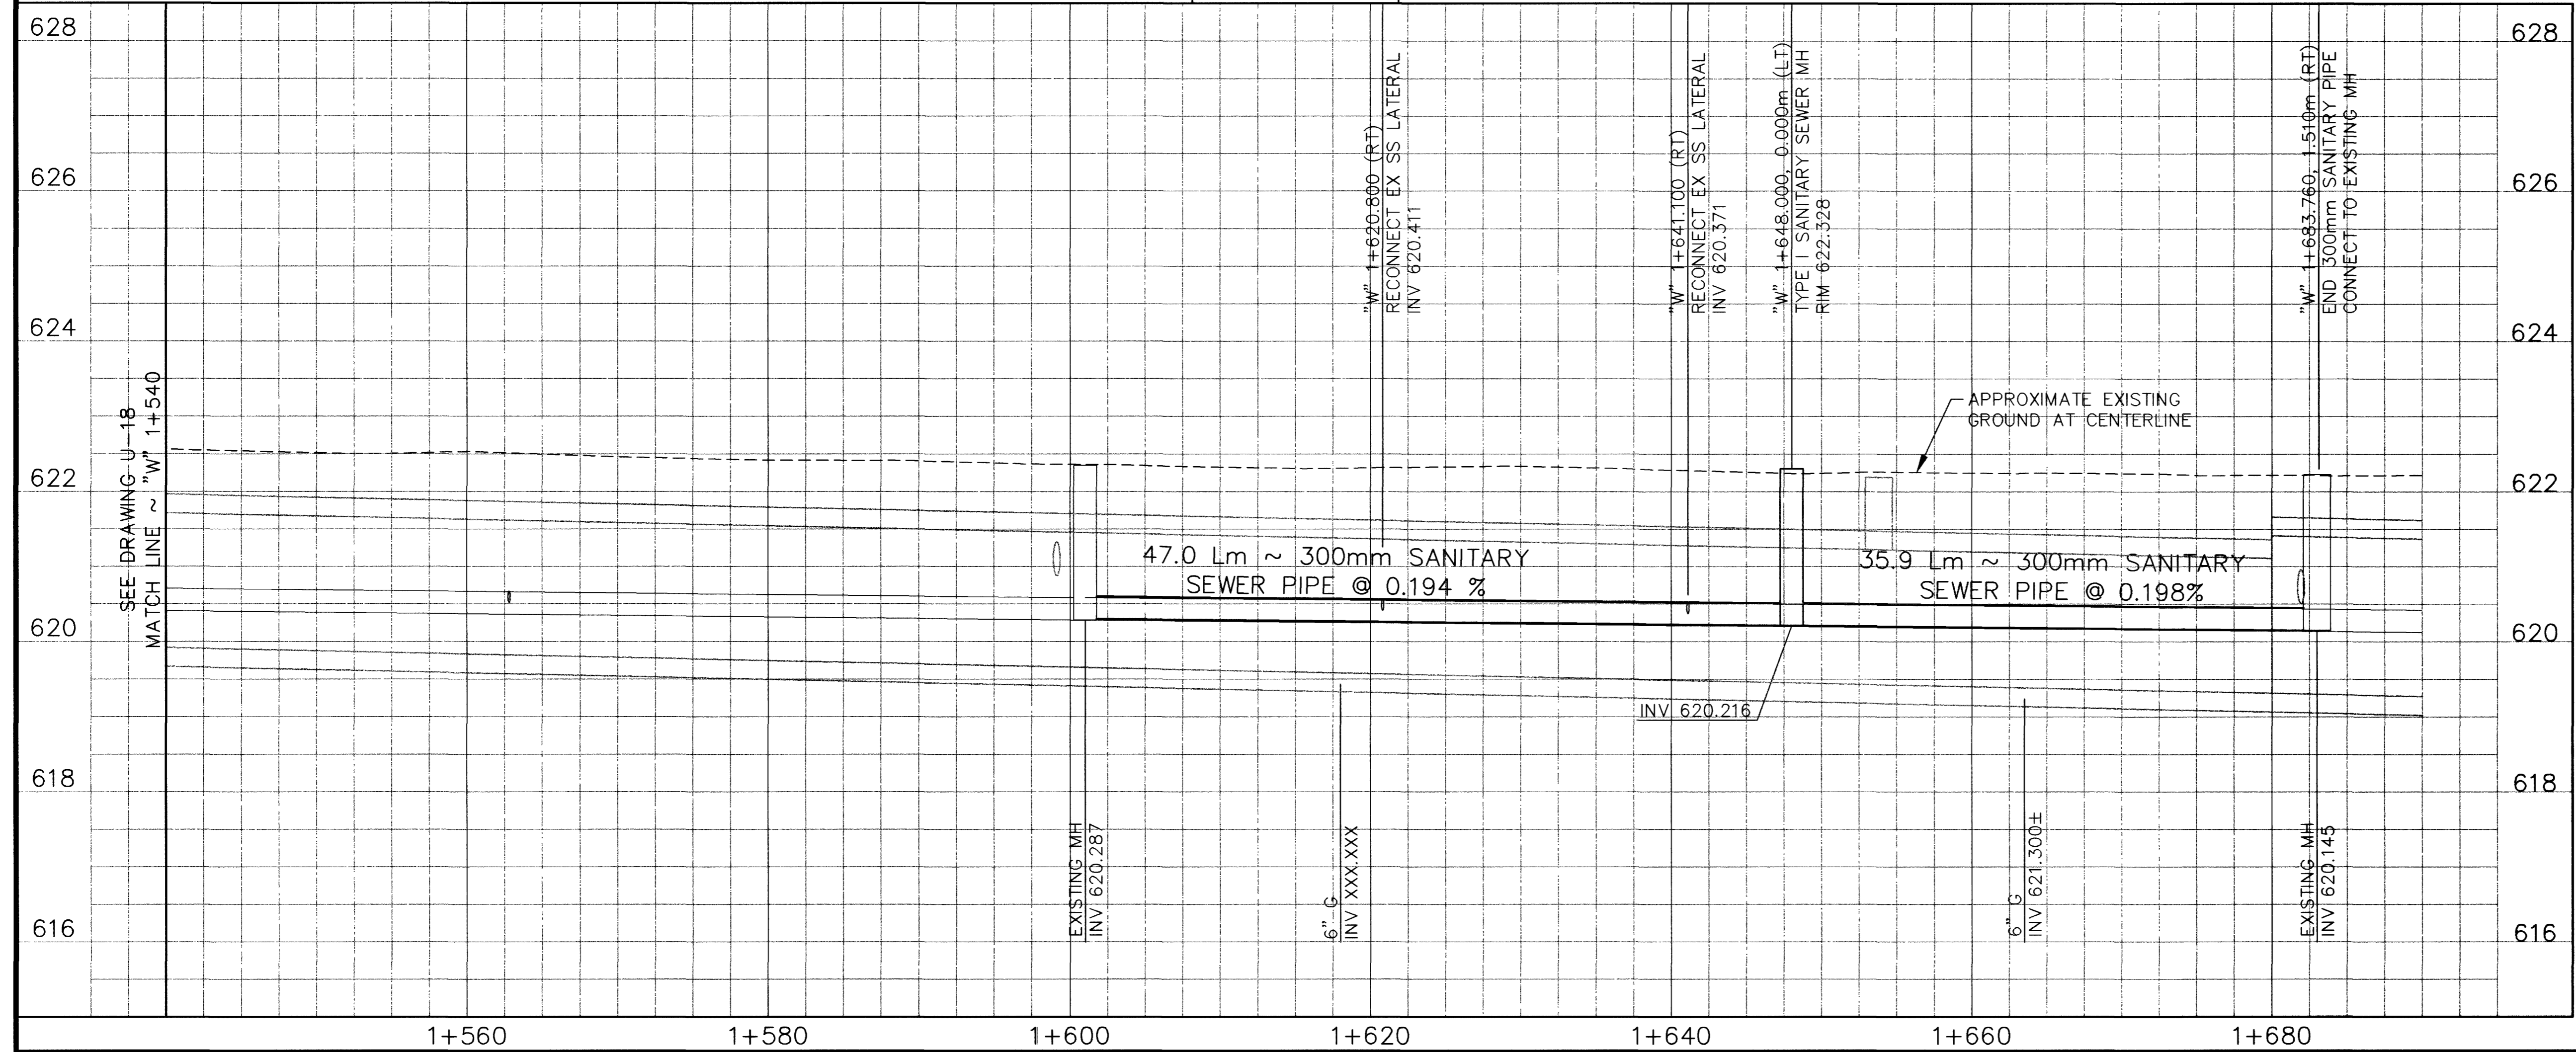


**Call before you Dig.**  
1-800-277-2600  
UNDERGROUND SERVICE (USA)

**Call before you Overhead.**  
563-6111  
OVERHEAD SERVICE (USA)

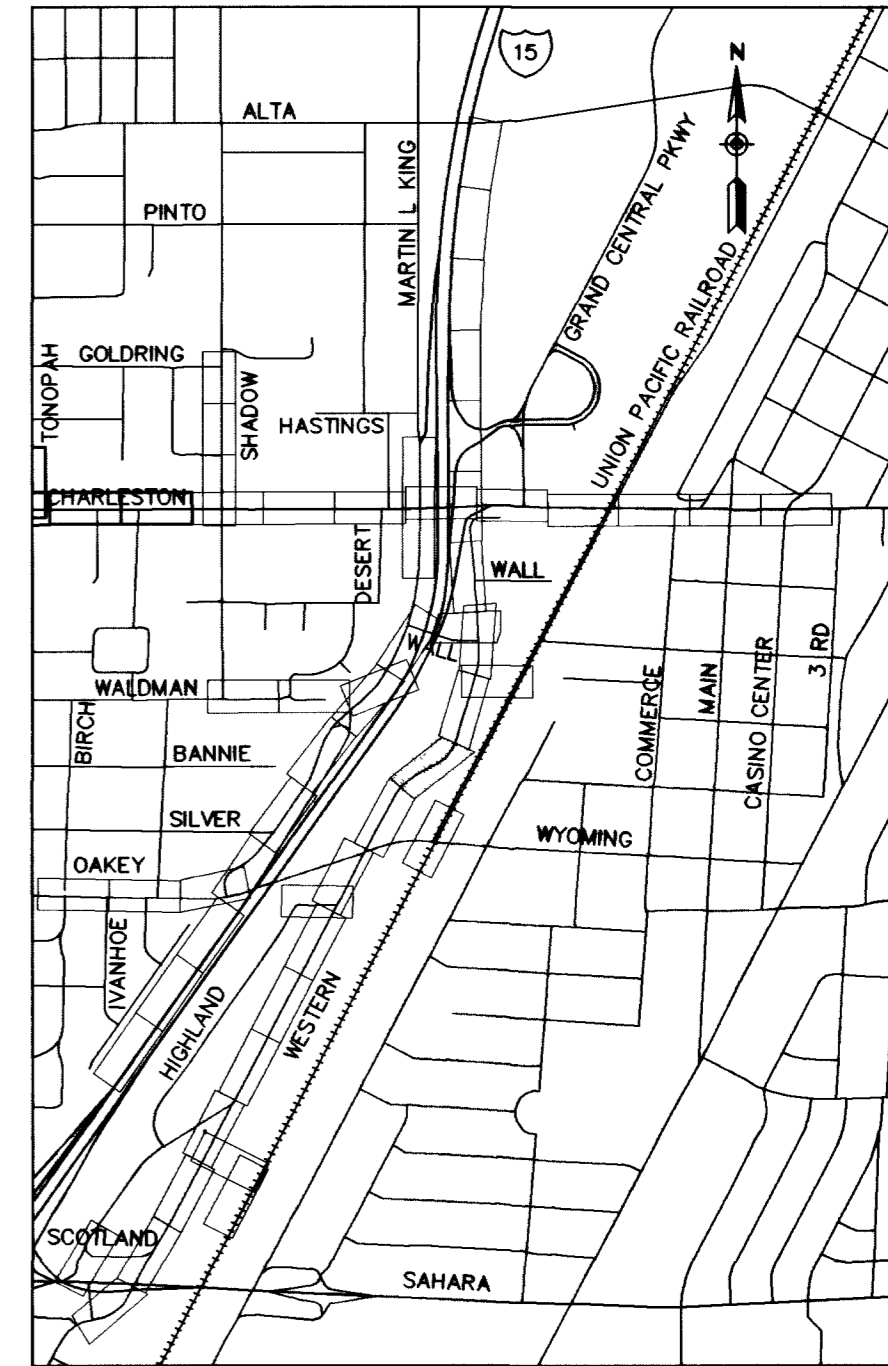


REVISIONS	DATE
RECORD DRAWING	4/30/03

SCALE (H)	SCALE (V)	PROJECT #
1:250	1:50	31604
F.L. BK. #	DATE	DESIGN BY
N/A	DEC 17, 1998	KFN

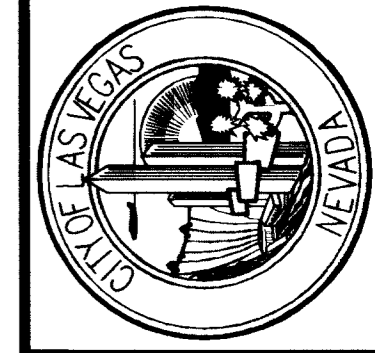

**DEPARTMENT OF PUBLIC WORKS**  
I-15 FREEWAY CHANNEL  
UTILITY RELOCATION (WESTERN AVE)  
"W" 1+540 TO "W" 1+690

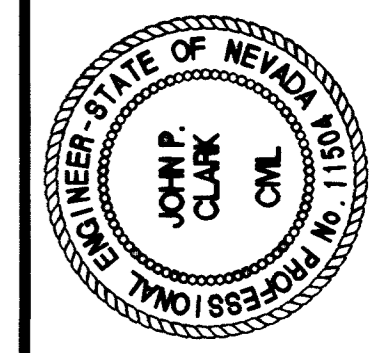

DRAWING No. 179  
U-20

327-V254