
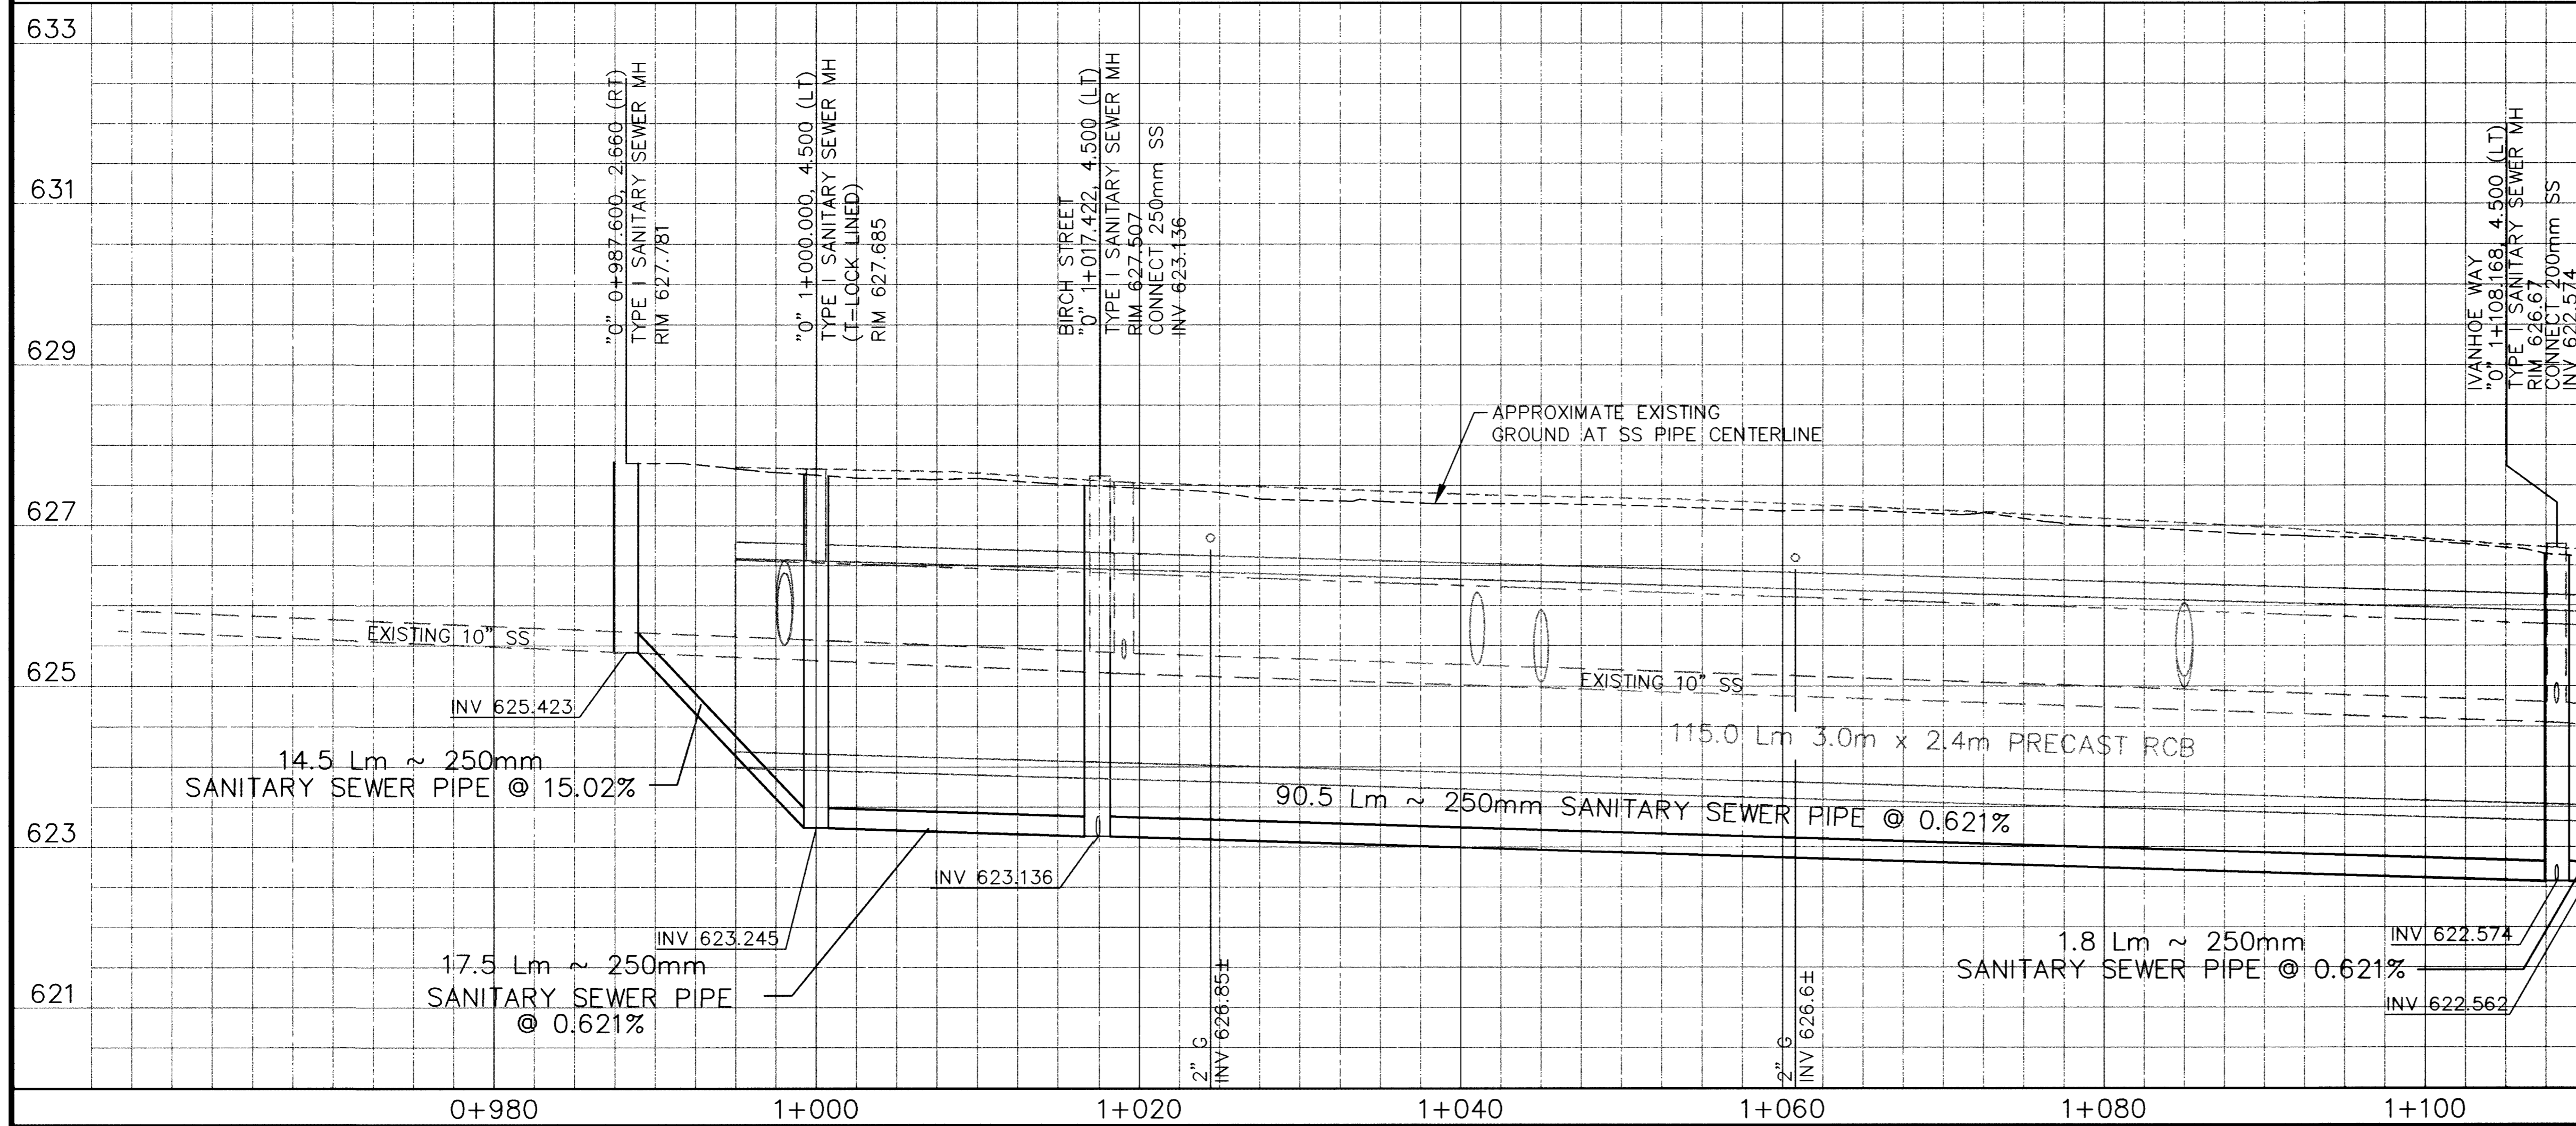


REMOVAL ITEMS	
1	REMOVE MH

CONSTRUCTION ITEMS		
1	0" 0+987.600, 2.660m RT TO 0" 1+000.000, 4.500m LT 0" 1+000.000, 4.500m LT TO 0" 1+017.422, 4.500m LT 0" 1+017.422, 4.500m LT TO 0" 1+108.160, 4.500m LT 0" 1+108.160, 4.500m LT TO 0" 1+110.000, 4.500m LT 0" 1+017.422, 18.000m RT TO 0" 1+017.422, 8.000m RT 0" 1+108.168, 20.000m RT TO 0" 1+108.168, 10.000m RT	CONSTRUCT 250mm SANITARY SEWER
2	0" 0+987.600, 2.660m RT TO 0" 1+017.422, 4.500m LT 0" 1+108.168, 4.500m LT	CONSTRUCT TYPE I SANITARY SEWER MH
4	0" 0+997.100, LT 0" 1+033.529, LT 0" 1+075.500, LT	PROTECT IN PLACE
5	0" 1+017.422, 8.000m RT 0" 1+108.168, 10.000m RT 0" 1+000.000, 4.500m LT	CONSTRUCT TYPE I T-LOCK LINED SANITARY SEWER MH
6	0" 0+988.000, 6.600m RT 0" 1+110.000, 6.600m RT	CONSTRUCT 200mm WATER LINE


NOTE:
ALL MANHOLE RIM ELEVATIONS SHALL BE FLUSH WITH FINISHED AC PAVEMENT

DATE	5/30/00
REVISIONS	
ADDENDUM 2	RECORD DRAWING
PROJECT #	31804
DESIGN BY	KFN
DATE	DEC 17, 1999
SCALE (H)	1:250
SCALE (V)	1:50
F.L.D. BK. #	N/A

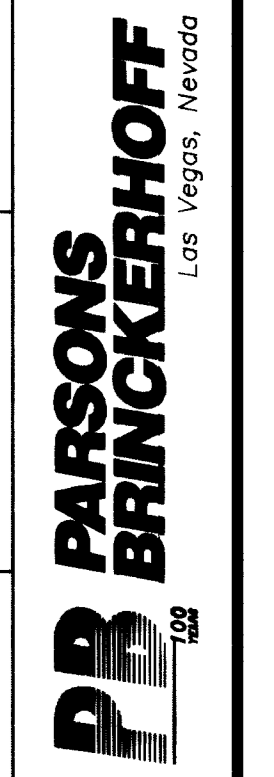


APPROVED FOR CONSTRUCTION
LAS VEGAS VALLEY WATER DISTRICT DATE

Call before you Dig. 1-800-277-2600
Call before you Overhead. 563-6111

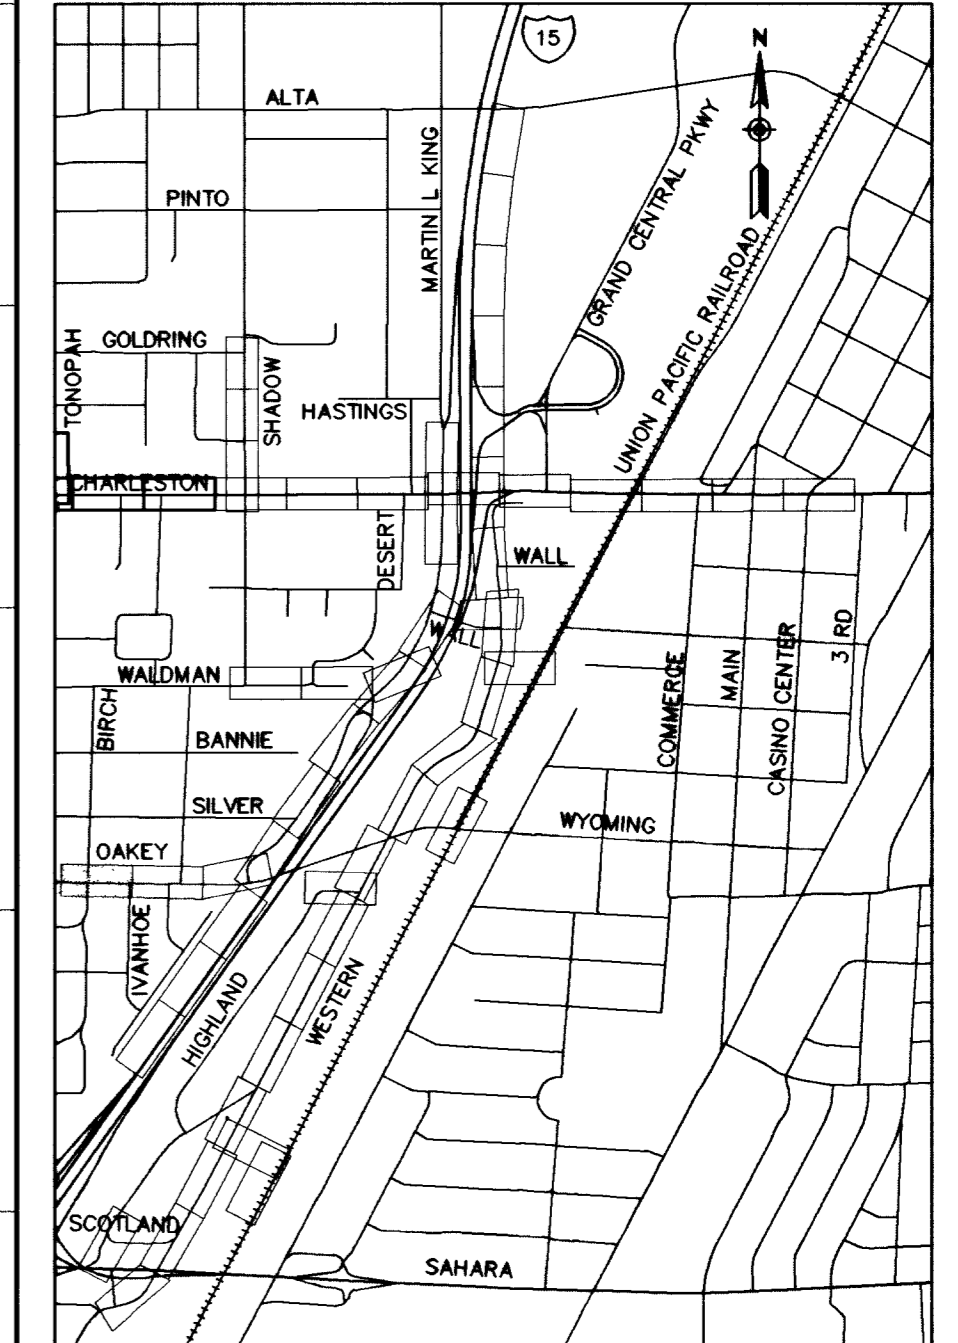

DEPARTMENT OF PUBLIC WORKS
I-15 FREEWAY CHANNEL
UTILITY RELOCATION (OAKEY BLVD)
"O" 0+995 TO "O" 1+110

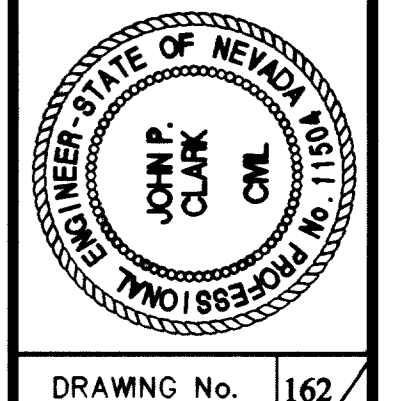

DRAWING No. 162
U-3