

- REMOVAL ITEMS**
- REMOVE MH
- CONSTRUCTION ITEMS**
- 0" 1+260.000, 4.500m LT TO 0" 1+339.895, 2.860m LT  
0" 1+316.000, 1.000m LT TO 0" 1+316.000, 9.000m RT  
CONSTRUCT 250mm SANITARY SEWER PIPE
  - 0" 1+339.895, 2.806m LT  
CONSTRUCT TYPE I SANITARY SEWER MH
  - 0" 1+277.60 LT  
RECONNECT EX WATER SERVICE PER LVWD UDS PLATE No. 1B OR 1D
  - 0" 1+280.50 LT  
RECONNECT EX SANITARY SEWER LATERAL
  - 0" 1+339.930, 1.364m LT  
0" 1+316.000, 1.000m LT  
CONNECT TO EX. 54" SANITARY SEWER
  - 0" 1+316.000, 9.000m RT  
CONSTRUCT TYPE I SANITARY SEWER DROP MH (T-LOCK) DCWSC SD-8
  - 0" 1+260.000, 6.600m RT TO 0" 1+335.470, 7.900m RT TO  
CONSTRUCT 200mm WATER LINE

DATE	REVISIONS	PROJECT #	SCALE (V)	SCALE (H)	FLD. BK. #	DATE	DESIGN BY
3/30/03		31604	1:50	1:250	N/A	DEC 17, 1999	RFN
9/11/00	ADDITION 2						
4/20/03	PROTECT OAKEY/MLK WATER METER RECORD DRAWING						



**DEPARTMENT OF PUBLIC WORKS**


**I-15 FREEWAY CHANNEL**

**UTILITY RELOCATION (OAKEY BLVD)**

"O" 1+260 TO "O" 1+366.700

**RECORD DRAWING METRIC**

U-5 241

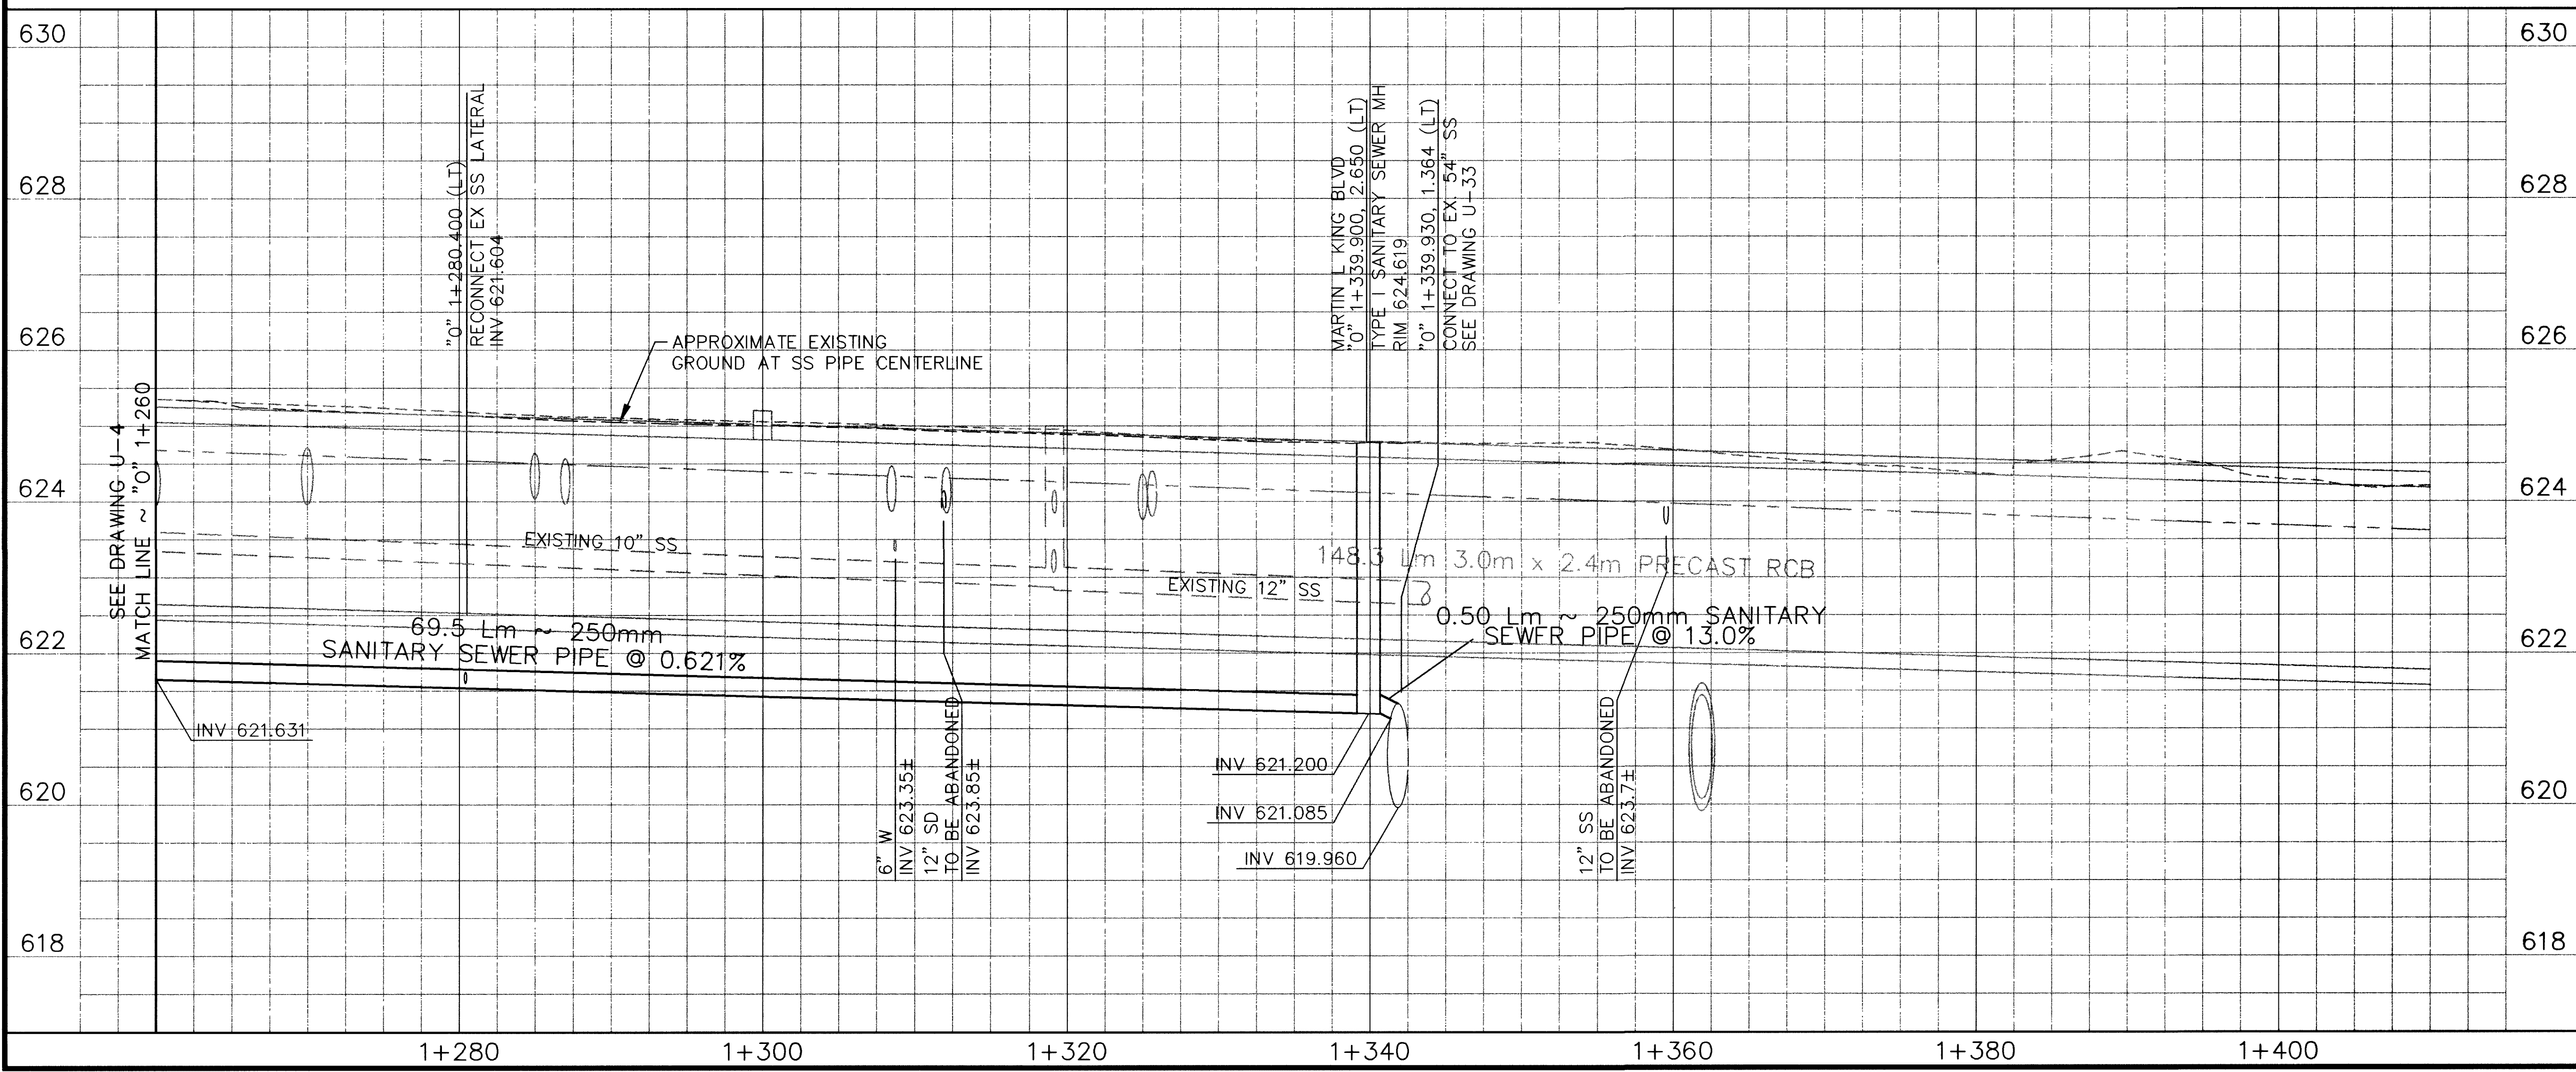

APPROVED FOR CONSTRUCTION

LAS VEGAS VALLEY WATER DISTRICT DATE

**Call before you Dig.**  
1-800-277-2600  
UNDERGROUND SERVICE (USA)

**Call before you Overhead.**  
563-6111  
OVERHEAD SERVICE (USA)

