
	DEPARTMENT OF PUBLIC WORKS			 Kimley-Horn and Associates, Inc. <i>Engineering, Planning, and Environmental Consultants</i> © 1999	DATE _____
	I-15 FREEWAY CHANNEL ITS INFRASTRUCTURE LOCATION INDEX				REVISIONS _____
DRAWING NO: IT-1	FLD. BK. * _____	DATE _____	HALF SCALE 1:500 _____	W.A. * _____	REVISIONS _____

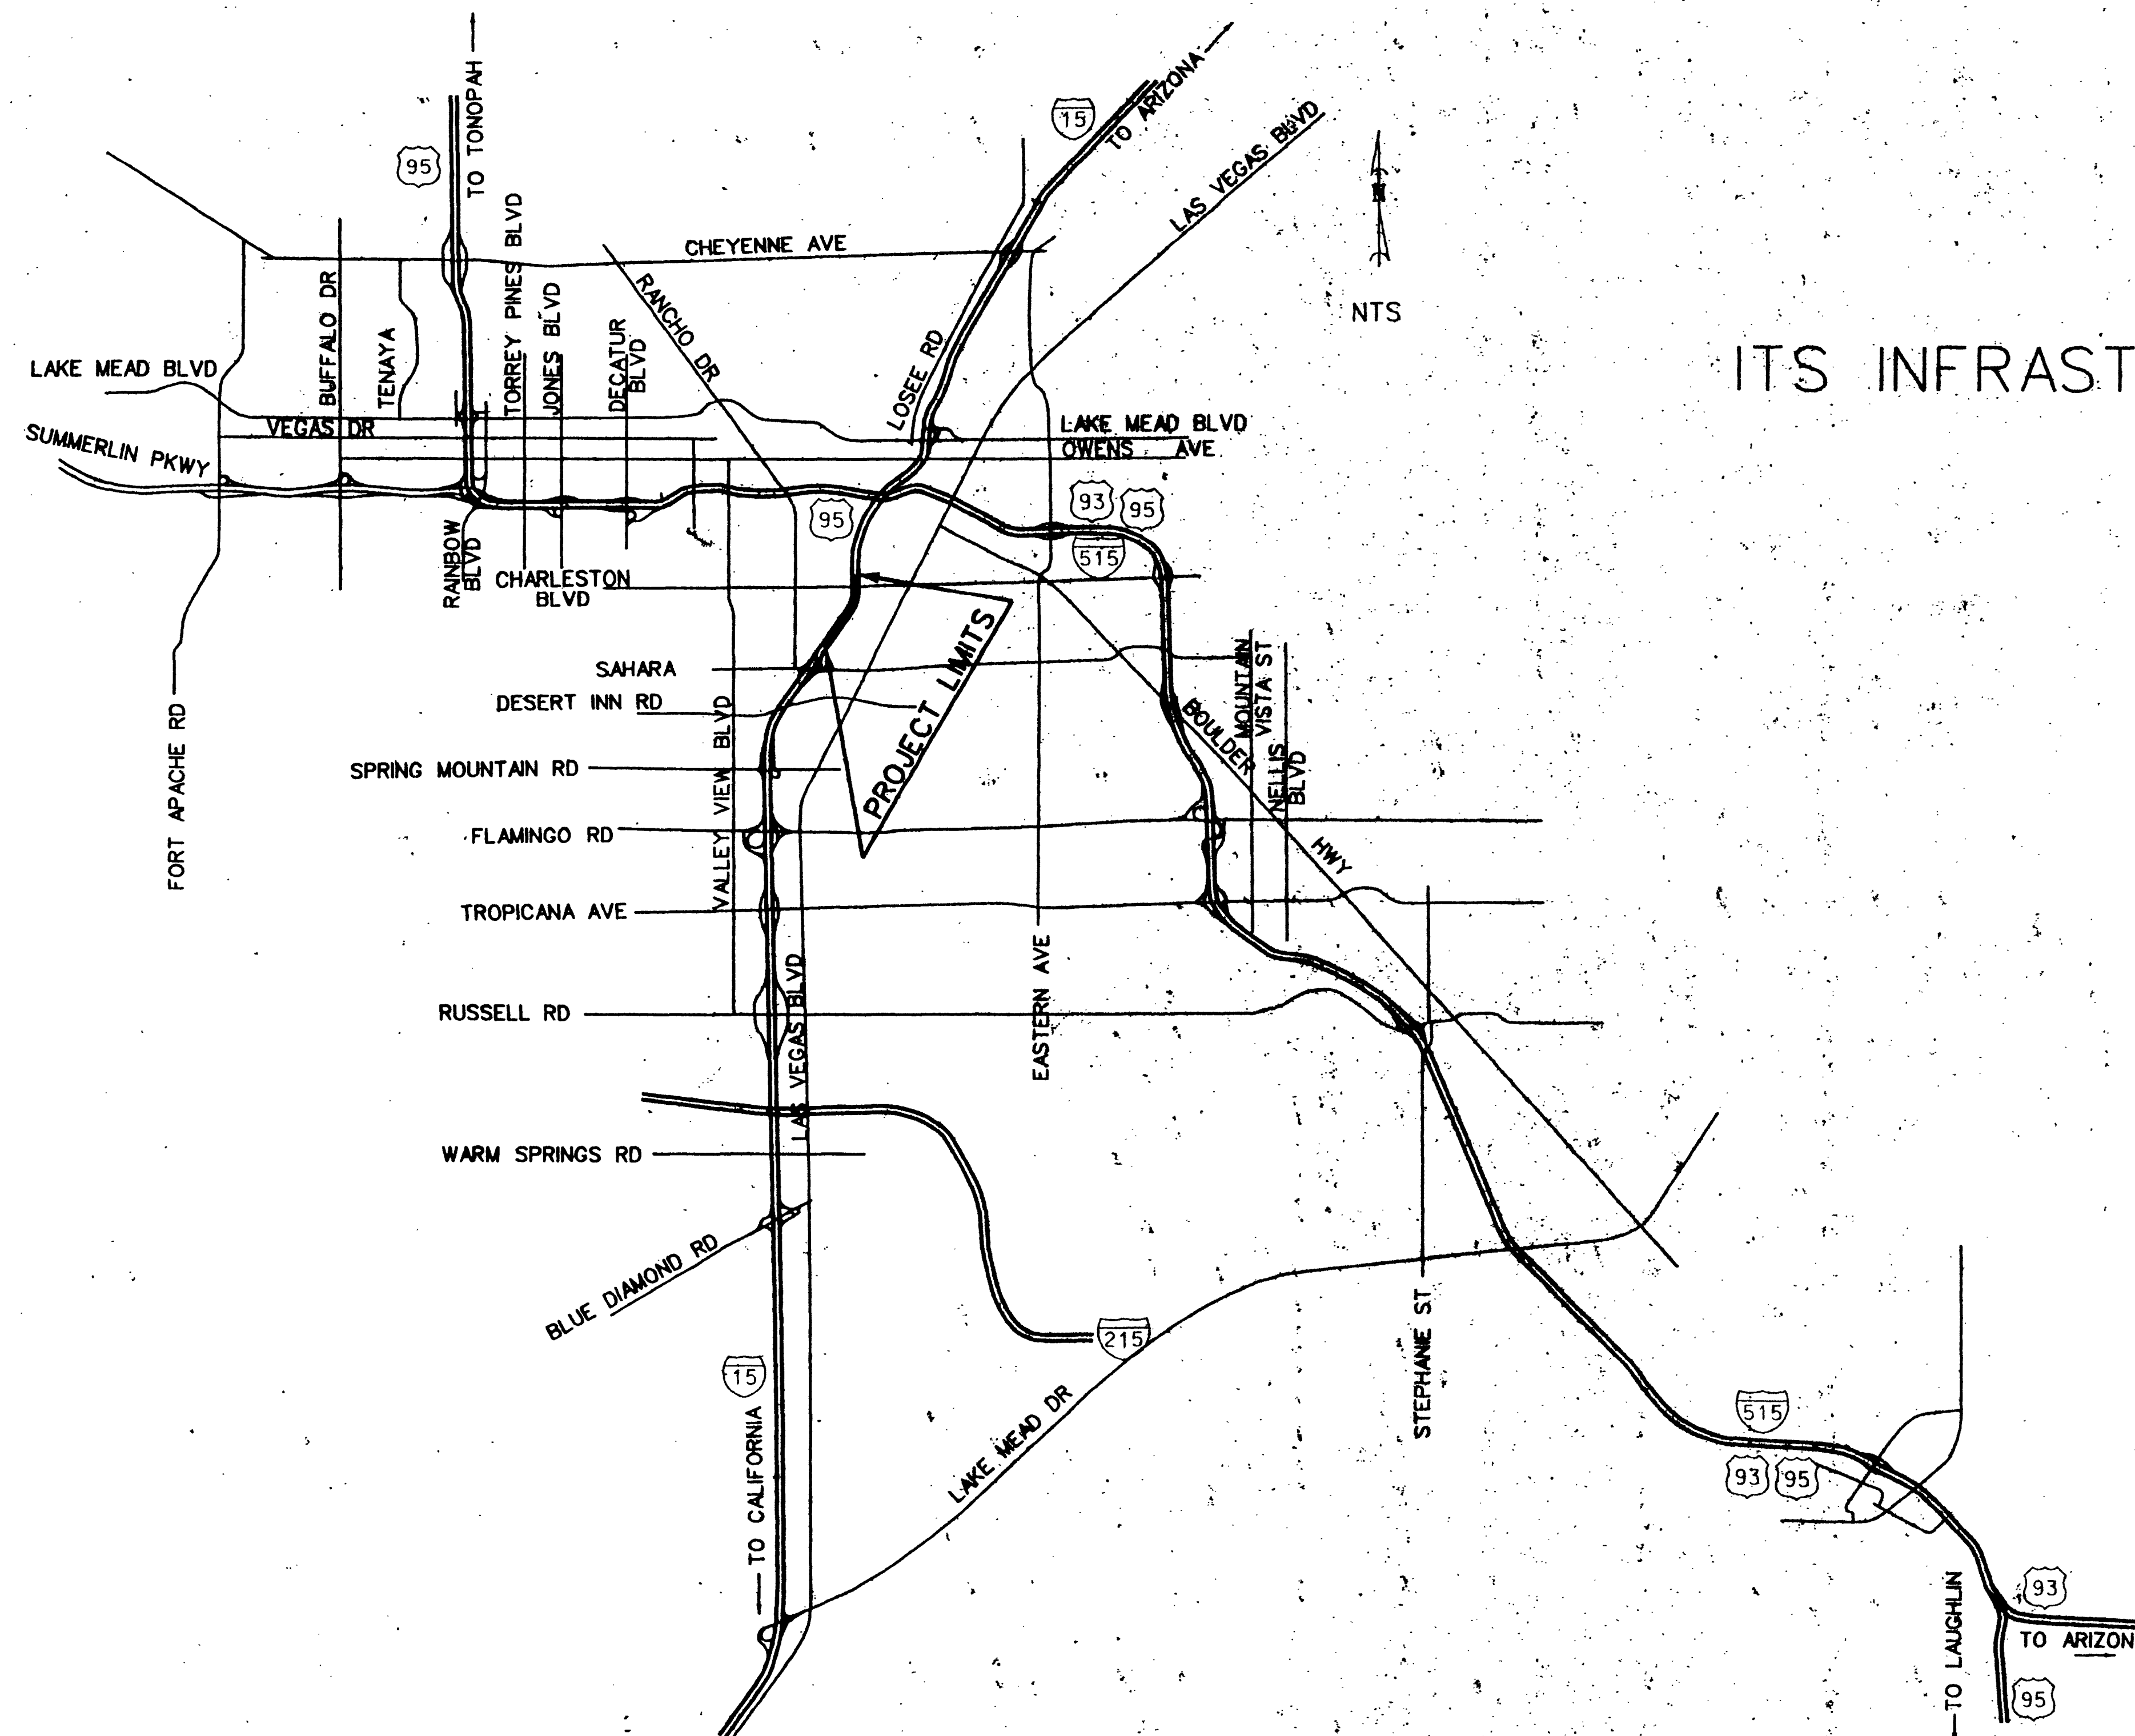

AS-BUILT BY
WESTERN DIVERSIFIED
ELECTRIC
10-7-02