


ALL DIMENSIONS ARE IN MILLIMETERS UNLESS OTHERWISE NOTED, ALL STATIONS ARE IN METERS.

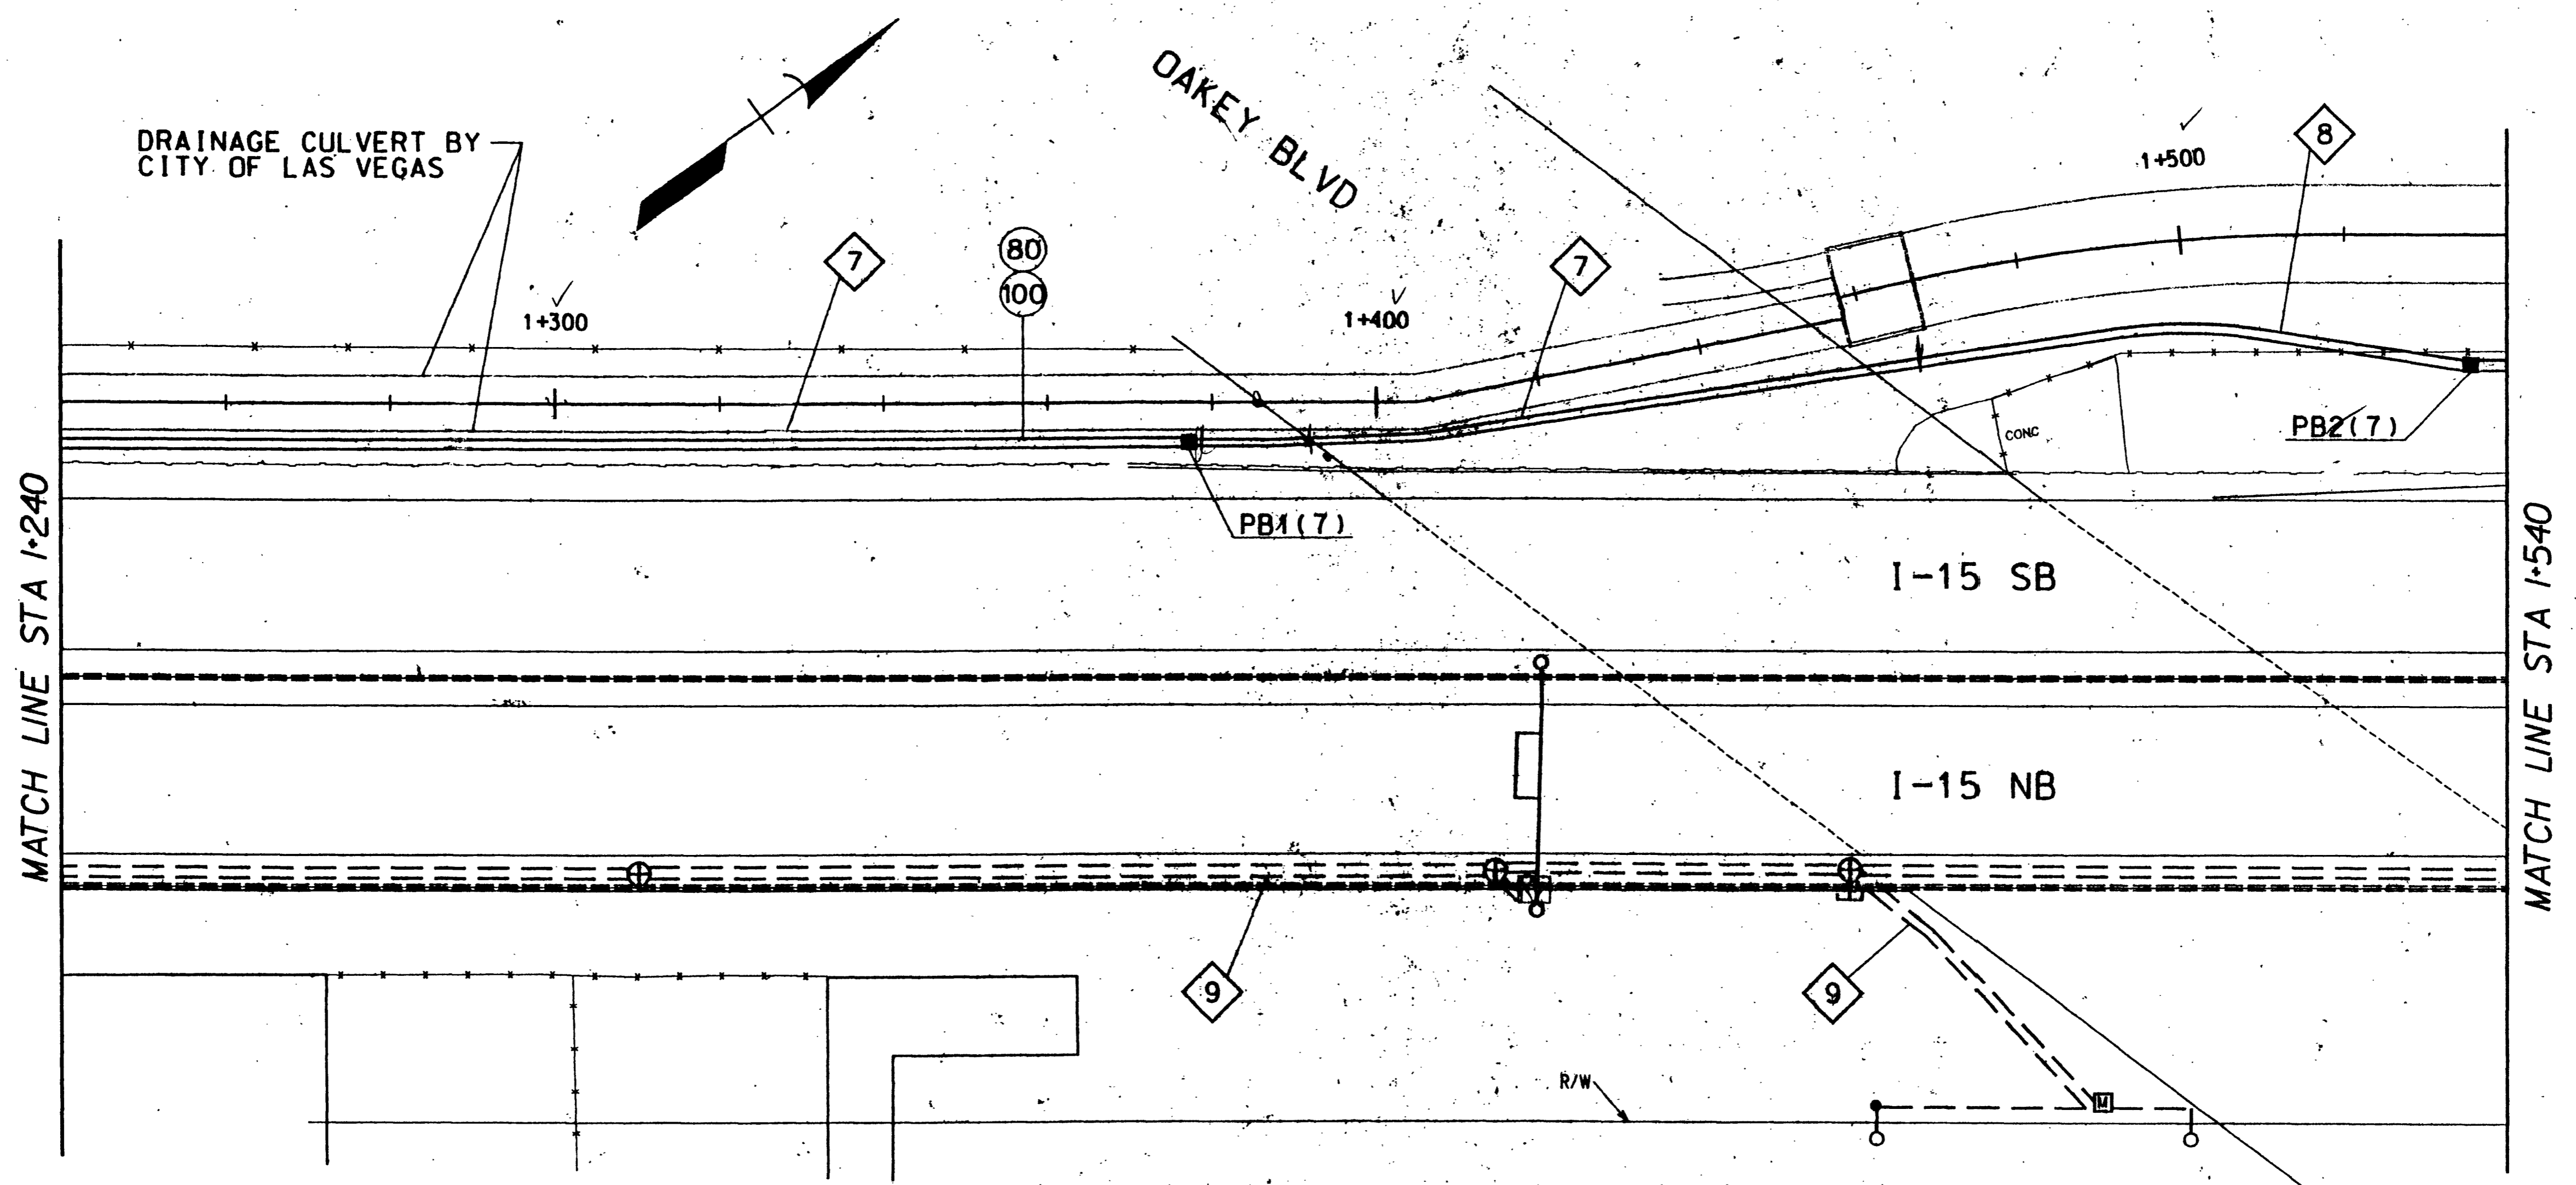

- ◇ 7 INSTALL 80 mm PVC CONDUIT AND 100 mm PVC MULTIDUCT ADJACENT TO DRAINAGE STRUCTURE IN TRENCH PER DETAILS AND SPECIFICATIONS.
- ◇ 8 TRANSITION CONDUIT TO FREEWAY SIDE OF ACCESS FENCE.
- ◇ 9 ITS INFRASTRUCTURE TO BE INSTALLED AS PART OF NDOT'S I-15/SAHARA WIDENING PROJECT.

AS BUILT BY
WESTERN DIVERSIFIED
ELECTRIC
FTEOVER: 10-2-02

DATE	
REVISIONS	
W.A.*	DESIGN BY
FULL SCALE 1:500	DATE
DATE	
HALF SCALE 1:1000	
F.L.D. BK.*	

Kimley-Horn and Associates, Inc.
Engineering, Planning, and Environmental Consultants
© 1999

DEPARTMENT OF PUBLIC WORKS
I-15 FREEWAY CHANNEL
ITS INFRASTRUCTURE
"FC" 1-240 TO "FC" 1-540

DRAWING NO. IT-11