

L:\31604\SHITS\T-17.DWG KOCHELEY 12/22/99 18:27

52285


Ernest
 A.S.C.
 429-1891
 Mark UP
 249-0799

LEGEND

- SIGNAL HEAD
- SIGNAL HEAD WITH BACKPLATE
- MAST ARM/ OVERHEAD SIGNAL WITH BACKPLATE
- SIGNAL STANDARD
- No. 3 1/2 TRAFFIC SIGNAL PULL BOX
- LOOP DETECTOR
- CONDUIT

Call before you Dig.
 1-800-277-2800
UNDERGROUND SERVICE (USA)

Call before you Overhead
 563-6111
OVERHEAD SERVICE (USA)

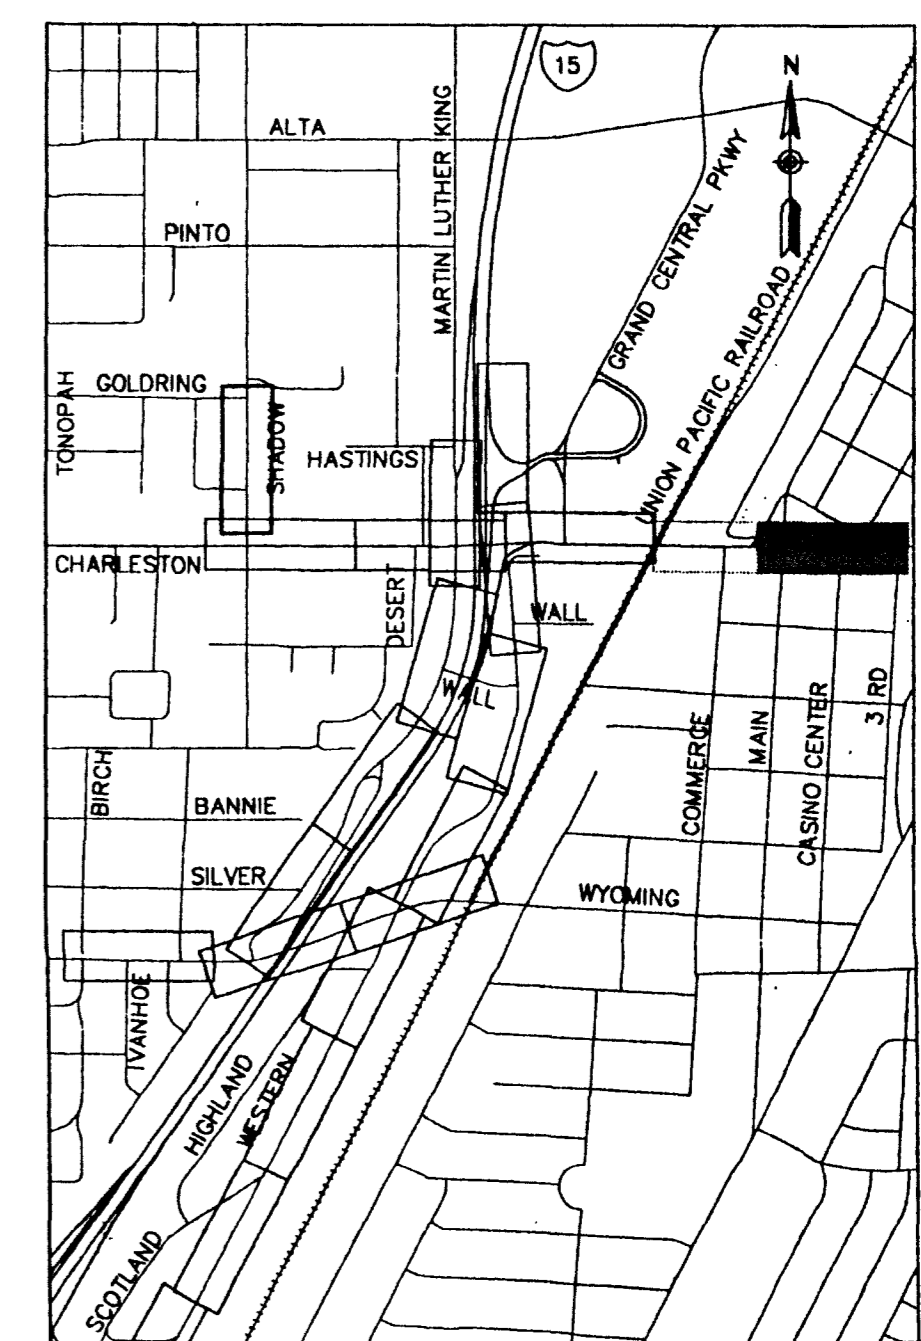

	DEPARTMENT OF PUBLIC WORKS I-15 FREEWAY CHANNEL SIGNALIZATION PLAN CHARLESTON & MAIN/CASINO CENTER		<table border="1" style="width: 100%; border-collapse: collapse;"> <tr> <td style="width: 25%;">SCALE (H) 1:200</td> <td style="width: 25%;">SCALE (V) N/A</td> <td style="width: 25%;">PROJECT # 31804</td> <td style="width: 25%;">DATE</td> </tr> <tr> <td>FLD. BK. # N/A</td> <td>DATE DECEMBER 17, 1999</td> <td>DESIGN BY KFN</td> <td>REVISIONS</td> </tr> </table>	SCALE (H) 1:200	SCALE (V) N/A	PROJECT # 31804	DATE	FLD. BK. # N/A	DATE DECEMBER 17, 1999	DESIGN BY KFN	REVISIONS
SCALE (H) 1:200	SCALE (V) N/A	PROJECT # 31804	DATE								
FLD. BK. # N/A	DATE DECEMBER 17, 1999	DESIGN BY KFN	REVISIONS								
		PARSONS BRINCKERHOFF <small>Las Vegas, Nevada</small>									
DRAWING No. 241		T-17 241									
METRIC		327-V254									