


ALL DIMENSIONS ARE IN MILLIMETERS UNLESS OTHERWISE NOTED, ALL STATIONS ARE IN METERS.

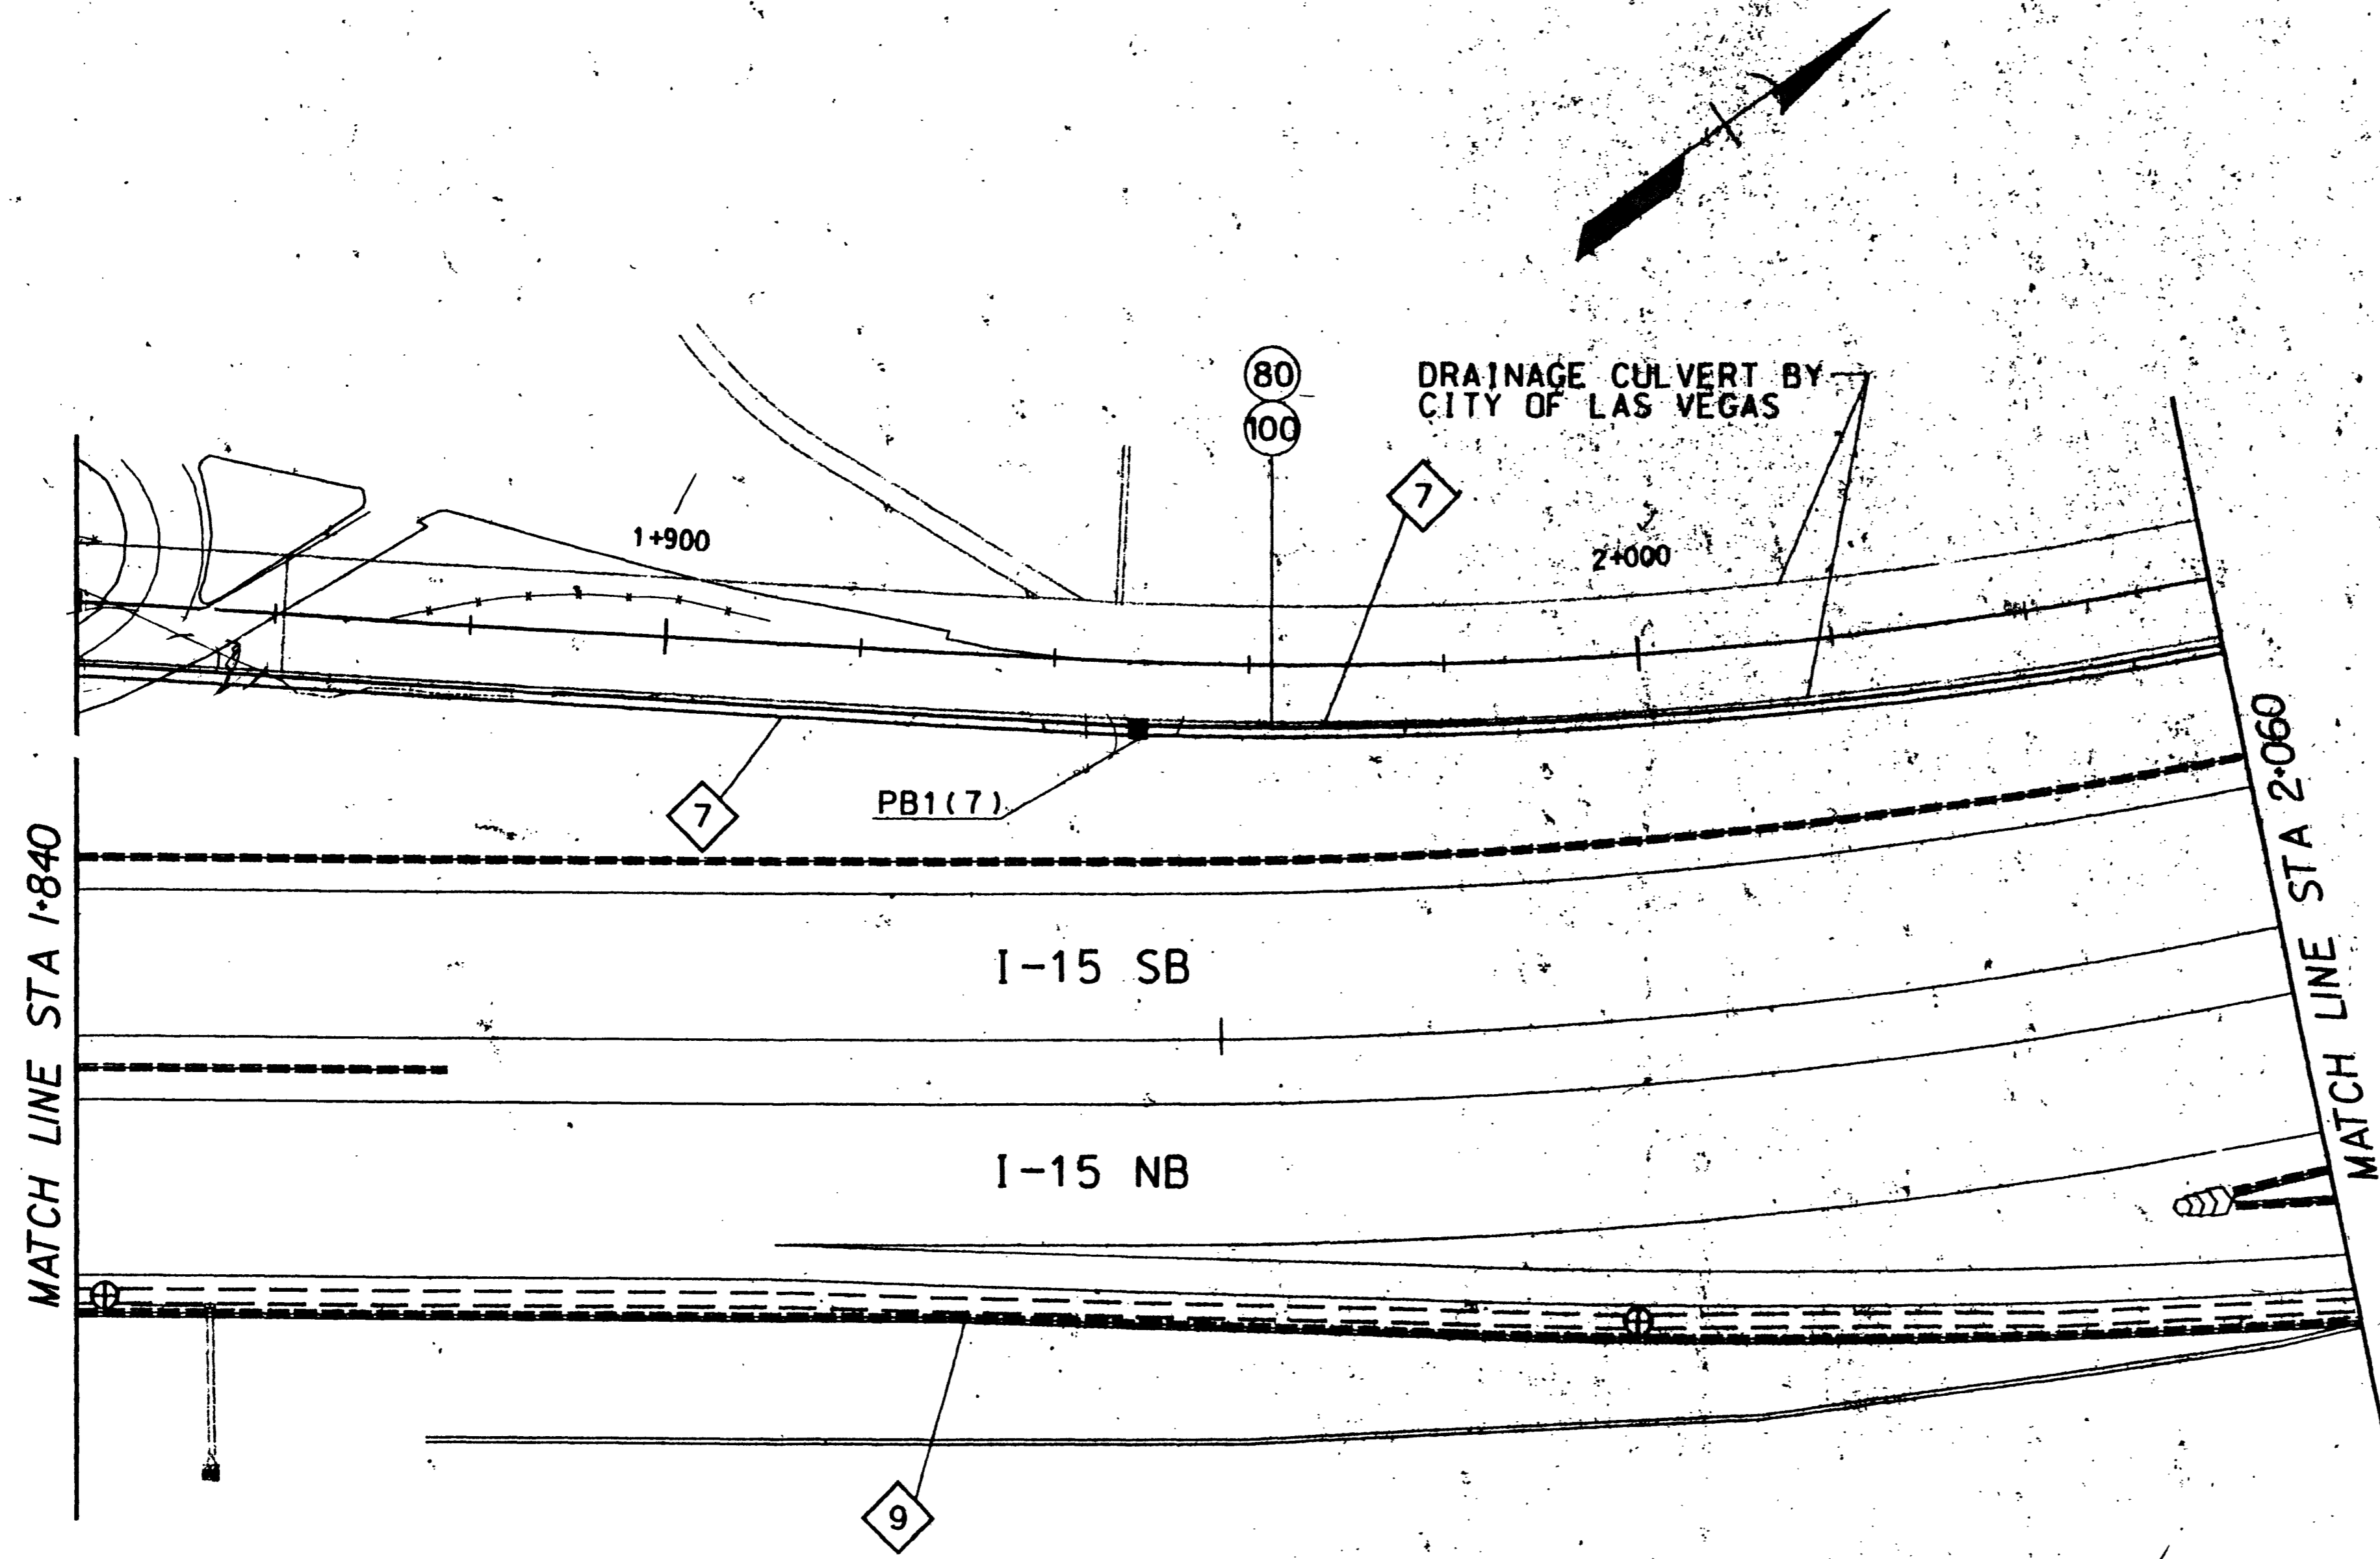

- 7 INSTALL 80 mm PVC CONDUIT AND 100 mm PVC MULTIDUCT ADJACENT TO DRAINAGE STRUCTURE IN TRENCH PER DETAILS AND SPECIFICATIONS.
- 9 ITS INFRASTRUCTURE TO BE INSTALLED AS PART OF NDOT'S I-15/SAHARA WIDENING PROJECT.

AS BUILT BY  
WESTERN DIVERSIFIED  
ELECTRIC  
B. H. H. 10-2-02

DATE		REVISIONS	
W.A.*		DESIGN BY	
Kimley-Horn and Associates, Inc.			
Engineering, Planning, and Environmental Consultants			
HALF SCALE 1:1000	FULL SCALE 1:500	DATE	
FLD. BK.*			
<b>DEPARTMENT OF PUBLIC WORKS</b> I-15 FREEWAY CHANNEL ITS INFRASTRUCTURE "FC" 1+840 TO "FC" 2+060			
DRAWING NO.			
IT-13			

S2274

327-Y254