



LEGEND

- ← SIGNAL HEAD
- ←+ SIGNAL HEAD WITH BACKPLATE
- ←+ MAST ARM OVERHEAD SIGNAL WITH BACKPLATE
- SIGNAL STANDARD
- No. 3 1/2 TRAFFIC SIGNAL PULL BOX
- LOOP DETECTOR
- CONDUIT

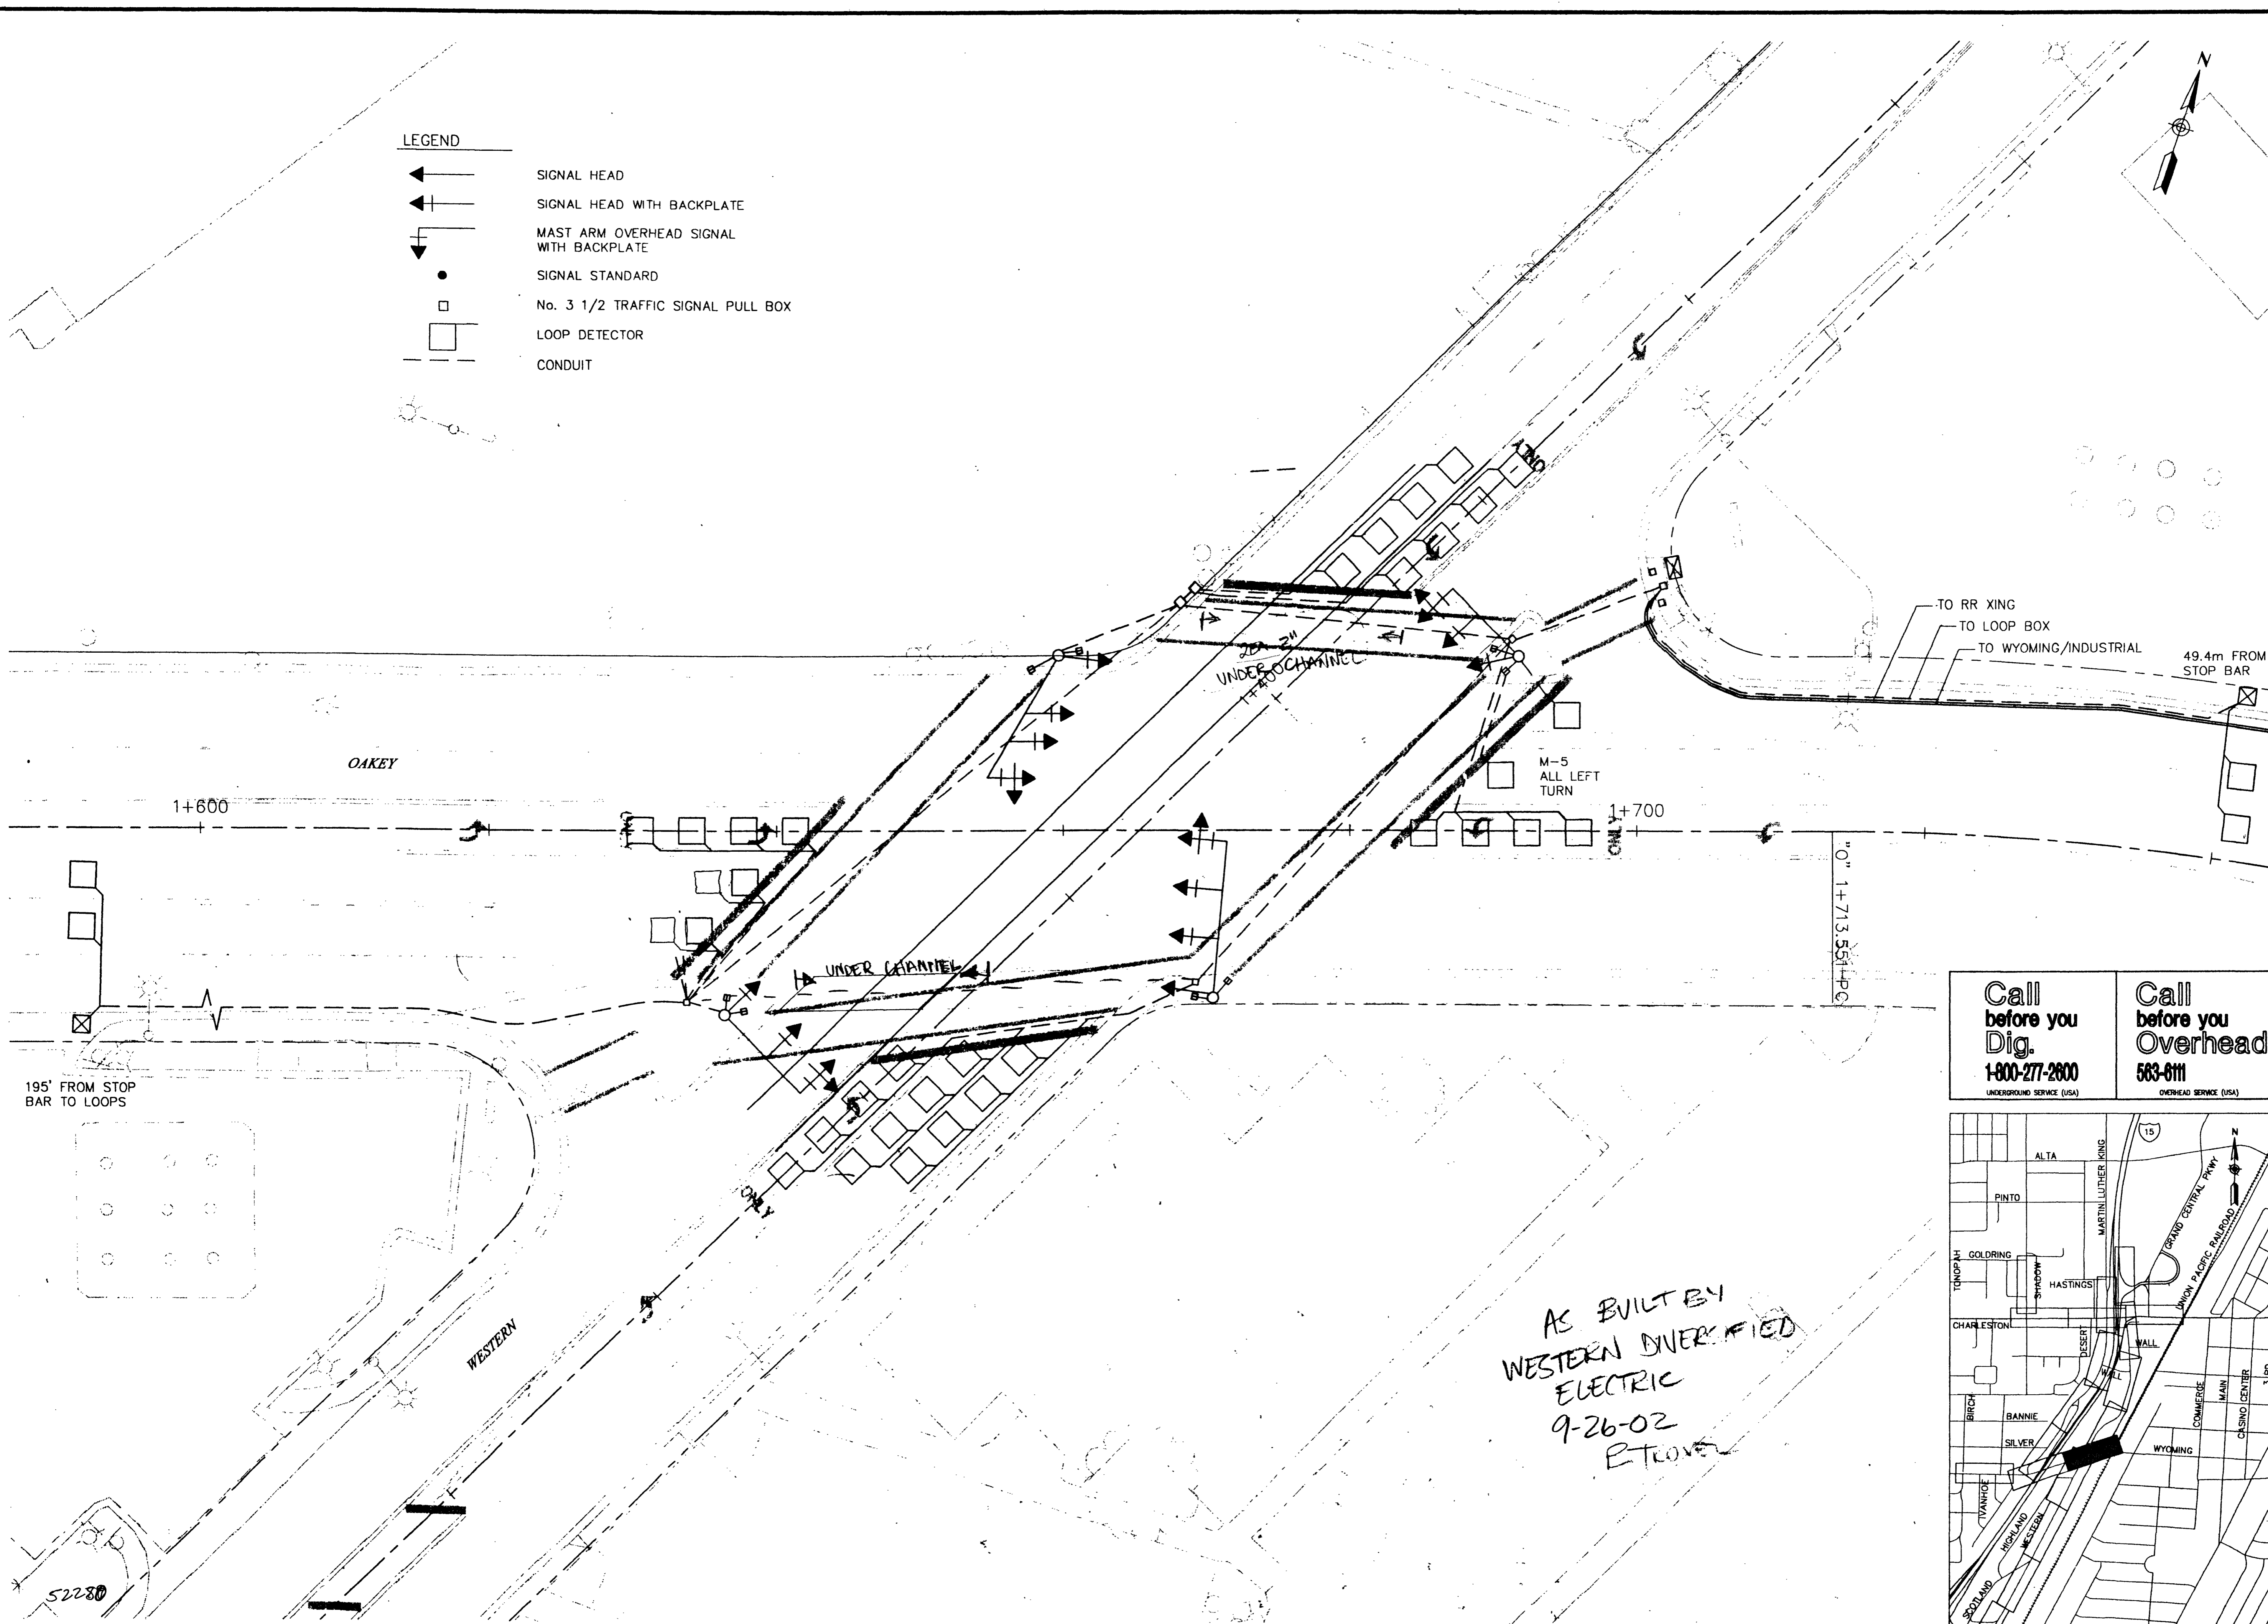

<p>Call before you Dig. 1-800-277-2800 <small>UNDERGROUND SERVICE (USA)</small></p>	<p>Call before you Overhead 563-611 <small>OVERHEAD SERVICE (USA)</small></p>
----------------------------------------------------------------------------------------------------	----------------------------------------------------------------------------------------------

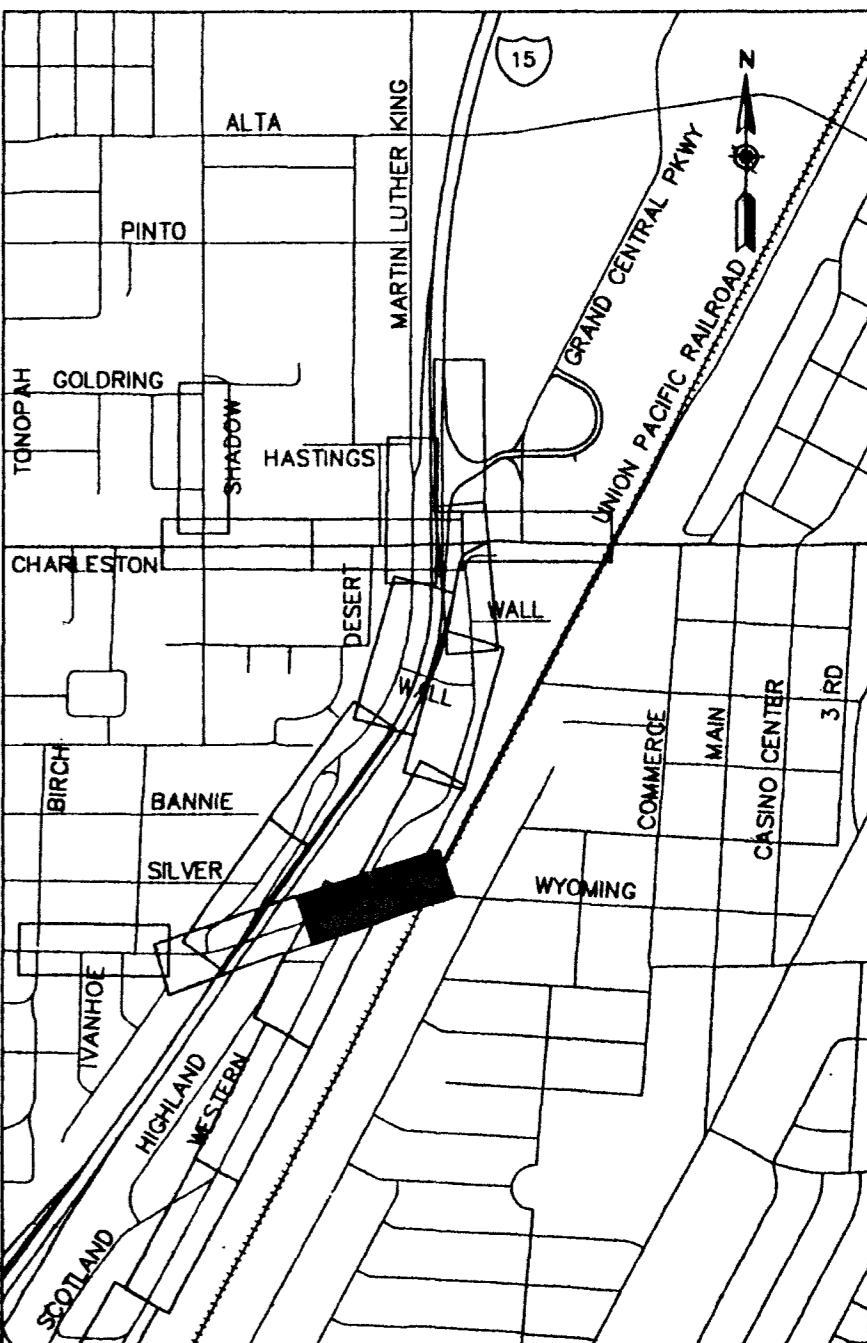

AS BUILT BY
WESTERN DIVERSIFIED
ELECTRIC
9-26-02
ET/over

<p>DATE</p>	<p>REVISIONS</p>	<p>PROJECT # 31604</p>	<p>DESIGN BY KFN</p>	<p>PARSONS BRINCKERHOFF <small>Las Vegas, Nevada</small></p>
<p>SCALE (H) 1:200</p>	<p>SCALE (V) N/A</p>	<p>DATE DECEMBER 17, 1999</p>	<p>DESIGN BY KFN</p>	
<p>DEPARTMENT OF PUBLIC WORKS</p> <p>I-15 FREEWAY CHANNEL</p> <p>SIGNALIZATION PLAN</p> <p>OAKLEY & WESTERN</p>				
<p>DRAWING No. 236</p>				<p>T-12</p>
<p>METRIC</p>				

52280