



LEGEND

- ← SIGNAL HEAD
- ←| SIGNAL HEAD WITH BACKPLATE
- ←| MAST ARM OVERHEAD SIGNAL WITH BACKPLATE
- SIGNAL STANDARD
- No. 3 1/2 TRAFFIC SIGNAL PULL BOX
- LOOP DETECTOR
- CONDUIT

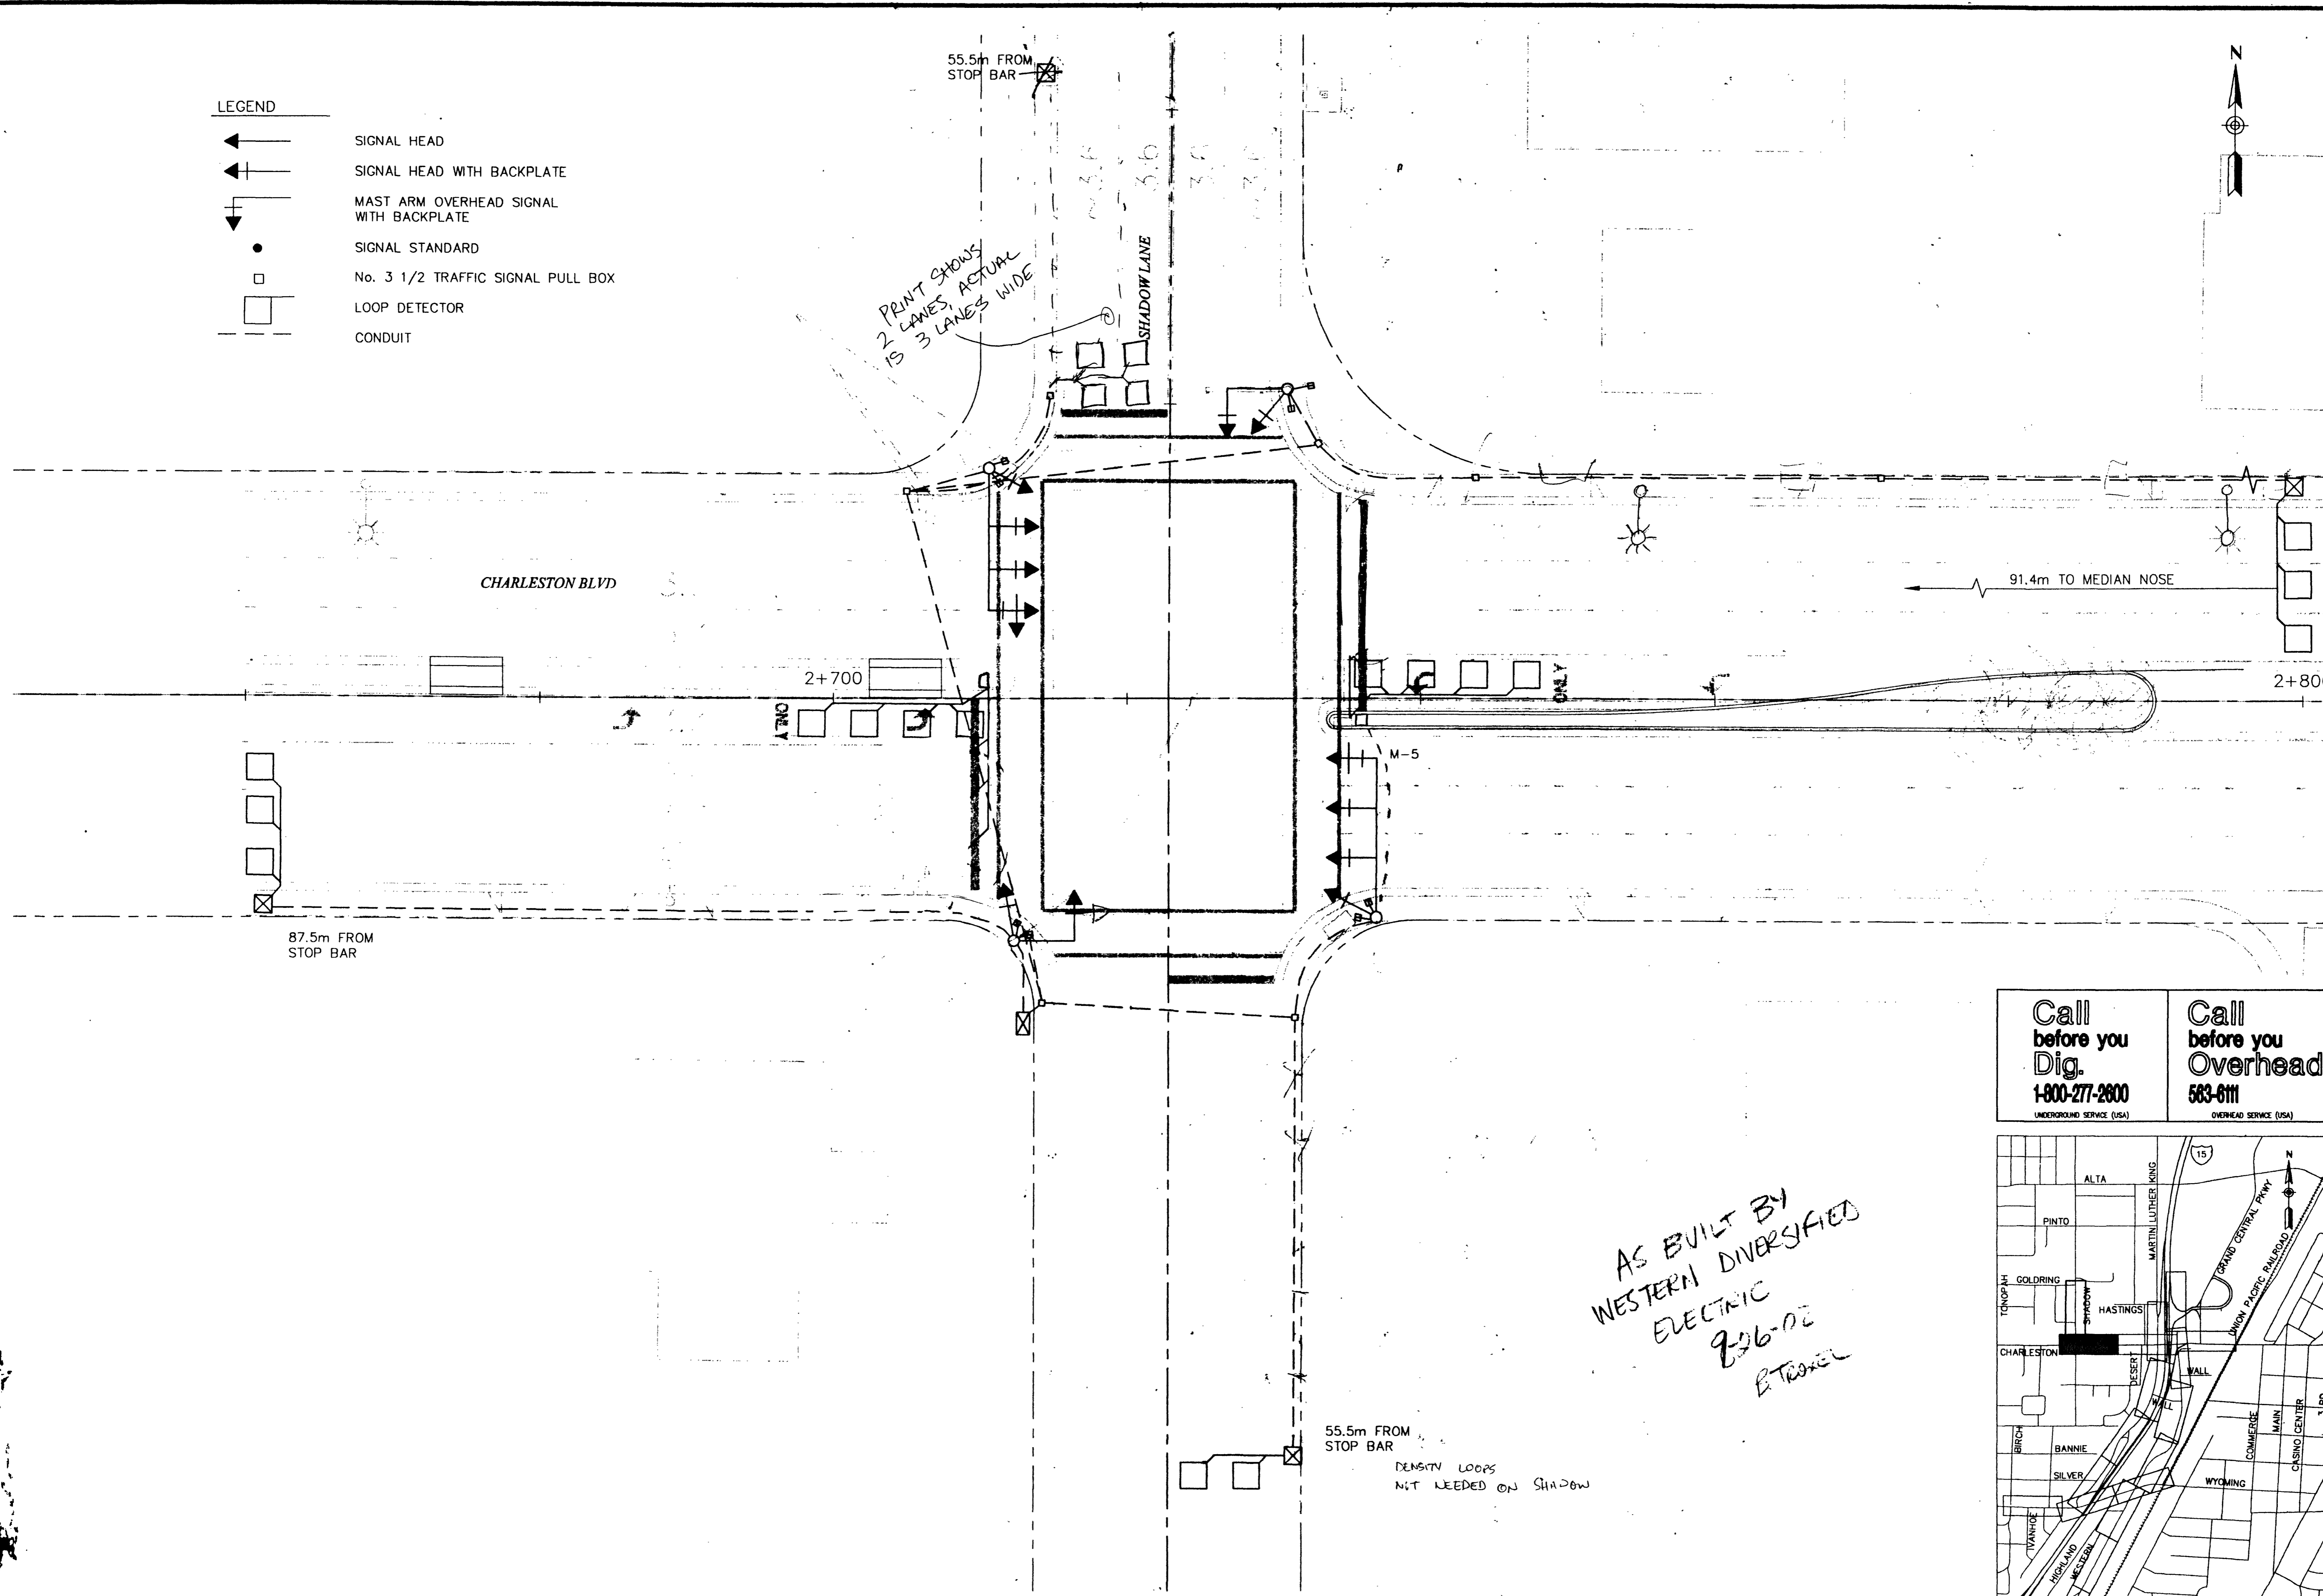

Call before you Dig. 1-800-277-2800 UNDERGROUND SERVICE (USA)

Call before you Overhead 563-6111 OVERHEAD SERVICE (USA)

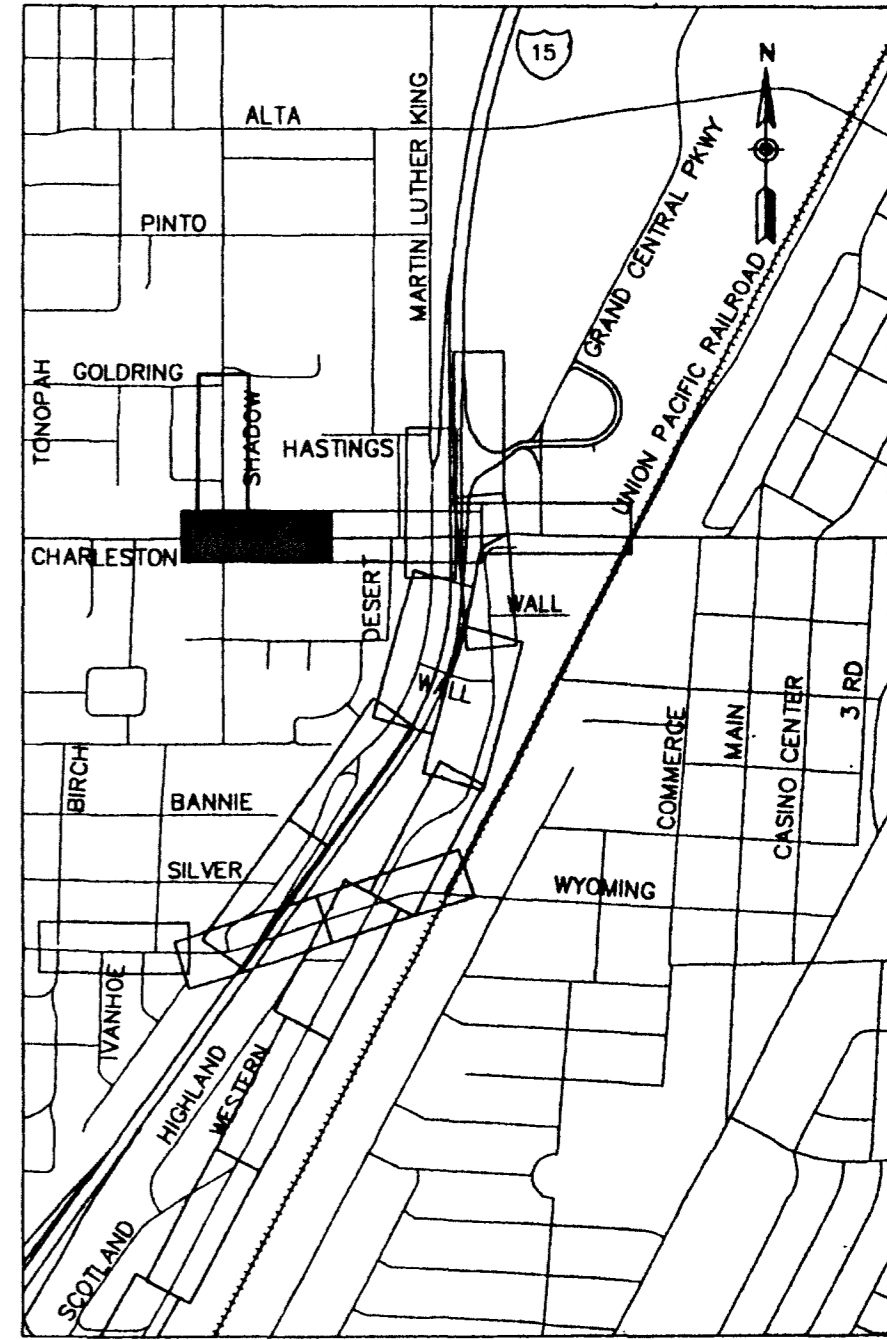

AS BUILT BY WESTERN ELECTRICAL 826-DE BTEXCEL

DATE		REVISIONS		PROJECT # 31604	
				SCALE (V) N/A	DATE DECEMBER 17, 1999
				SCALE (H) 1:200	DESIGN BY RPN
				F.L.D. BK. # N/A	

PARSONS BRINCKERHOFF
Las Vegas, NV

STATE OF NEVADA

DEPARTMENT OF PUBLIC WORKS

I-15 FREEWAY CHANNEL

SIGNALIZATION PLAN

CHARLESTON & SHADOW

STATE OF NEVADA

DRAWING No. T-13

52280

METRIC