


- LEGEND**
- ← SIGNAL HEAD
  - ← SIGNAL HEAD WITH BACKPLATE
  - ← MAST ARM OVERHEAD SIGNAL WITH BACKPLATE
  - SIGNAL STANDARD
  - No. 3 1/2 TRAFFIC SIGNAL PULL BOX
  - LOOP DETECTOR
  - CONDUIT

Call before you Dig.  
1-800-277-2800  
UNDERGROUND SERVICE (USA)

Call before you Overhead  
563-6111  
OVERHEAD SERVICE (USA)

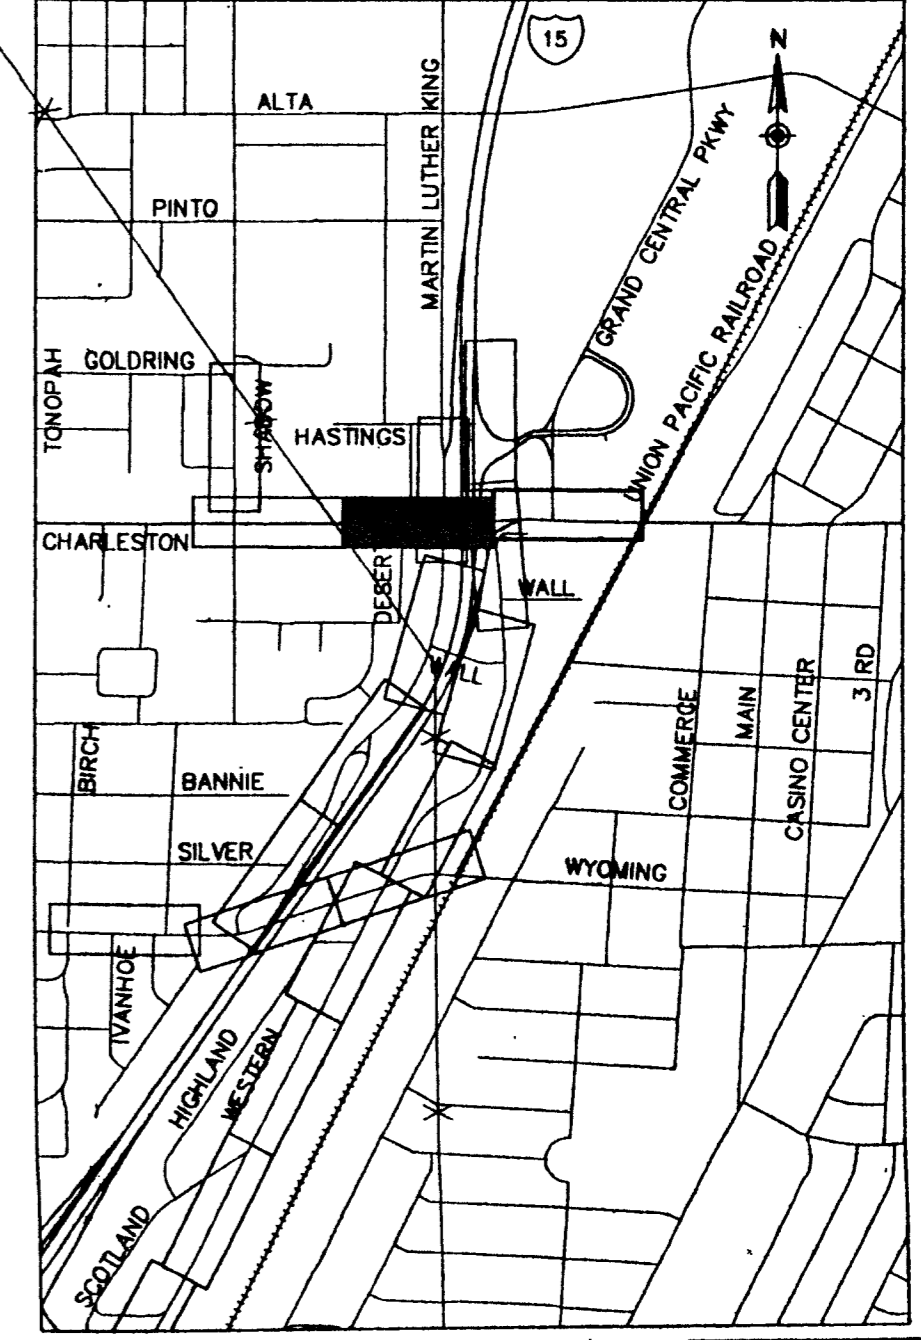

AS BUILT BY  
WESTERN DIVERSIFIED  
ELECTRIC  
1-26-02  
B. Traxer

DATE	REVISIONS	PROJECT # 31604	SCALE (V) N/A
		DATE DECEMBER 17, 1999	DESIGN BY KFN
<b>DEPARTMENT OF PUBLIC WORKS</b> I-15 FREEWAY CHANNELIZATION PLAN SIGNALIZATION PLAN CHARLESTON & MARTIN LUTHER KING			
		DRAWING No. T-14 238 241	

S:\SHTS\T-14.DWG KOECHLEY 12/22/99 18:25

52289

METRIC