

- REMOVAL ITEMS**
- [J] REMOVE AND RESTORE CHAIN LINK FENCE
 - [S] REMOVE BILLBOARD AND FOUNDATION
 - [T] REMOVE MH
- CONSTRUCTION ITEMS**
- ① "FC" 3+000.000 TO "FC" 3+150.000
 - ② "FC" 3+033.900, LT
 - ③ "FC" 3+100.000, 5.150m RT
"FC" 3+100.000, 5.150m LT
"FC" 3+103.600, 1.250m RT
 - ④ "FC" 3+029.323, 10.367m LT TO
"FC" 3+038.476, 10.348m LT

DATE	REVISIONS
3/30/00	
4/30/03	


ADDITION 2
RECORD DRAWING

PROJECT # 31604
DESIGN BY BPP

SCALE (V) 1:50
DATE DEC 17, 1999

SCALE (H) 1:250
F.L.D. BK. # N/A

PB PARSONS BRINCKERHOFF
Las Vegas, Nevada

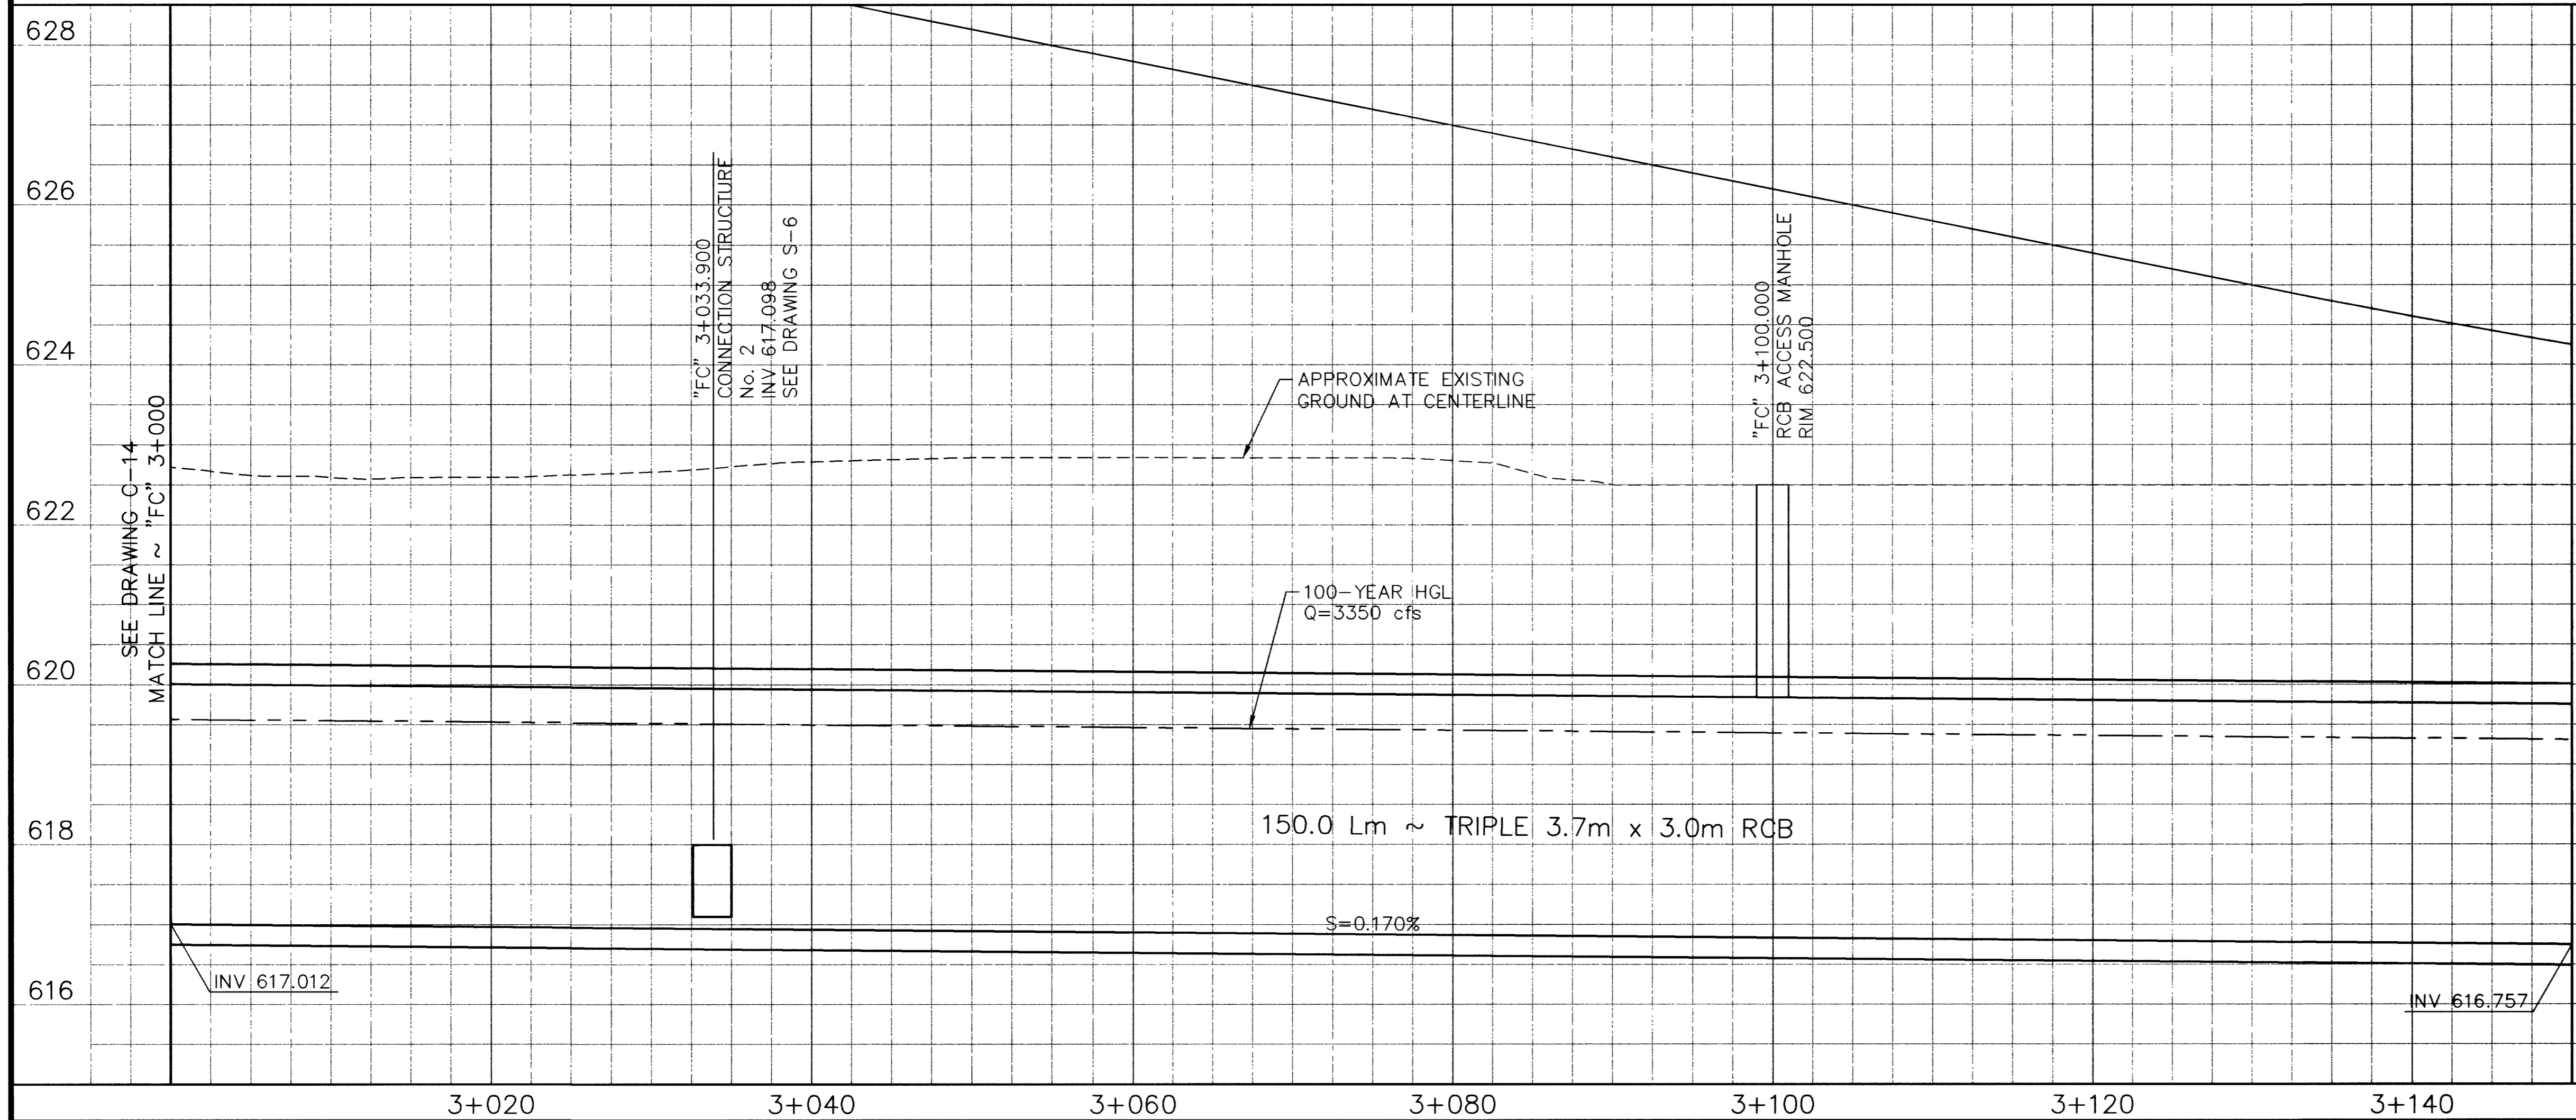


"FC" CURVE DATA

No.	Δ	R	L	T
FC6	07°48'05"	2024.000m	275.586m	138.006m


Call before you Dig.
1-800-277-2600
UNDERGROUND SERVICE (USA)

Call before you Overhead
563-6111
OVERHEAD SERVICE (USA)

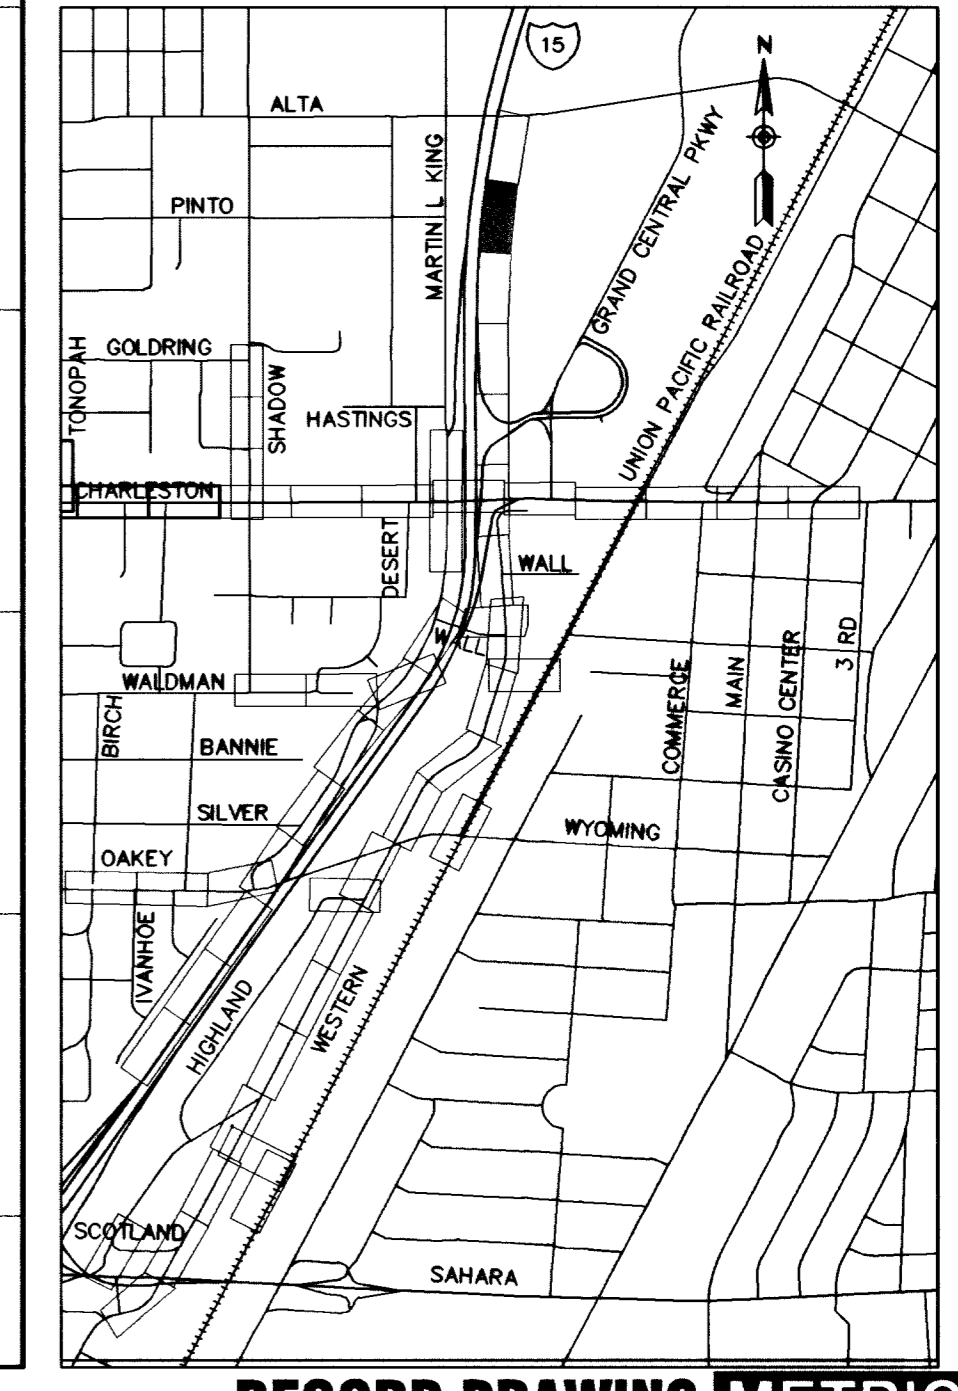

DEPARTMENT OF PUBLIC WORKS

I-15 FREEWAY CHANNEL
CONSTRUCTION PLAN AND PROFILE
"FC" 3+000 TO "FC" 3+150

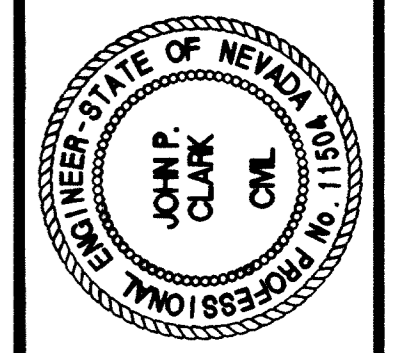

DRAWING No. 38
C-15
241