
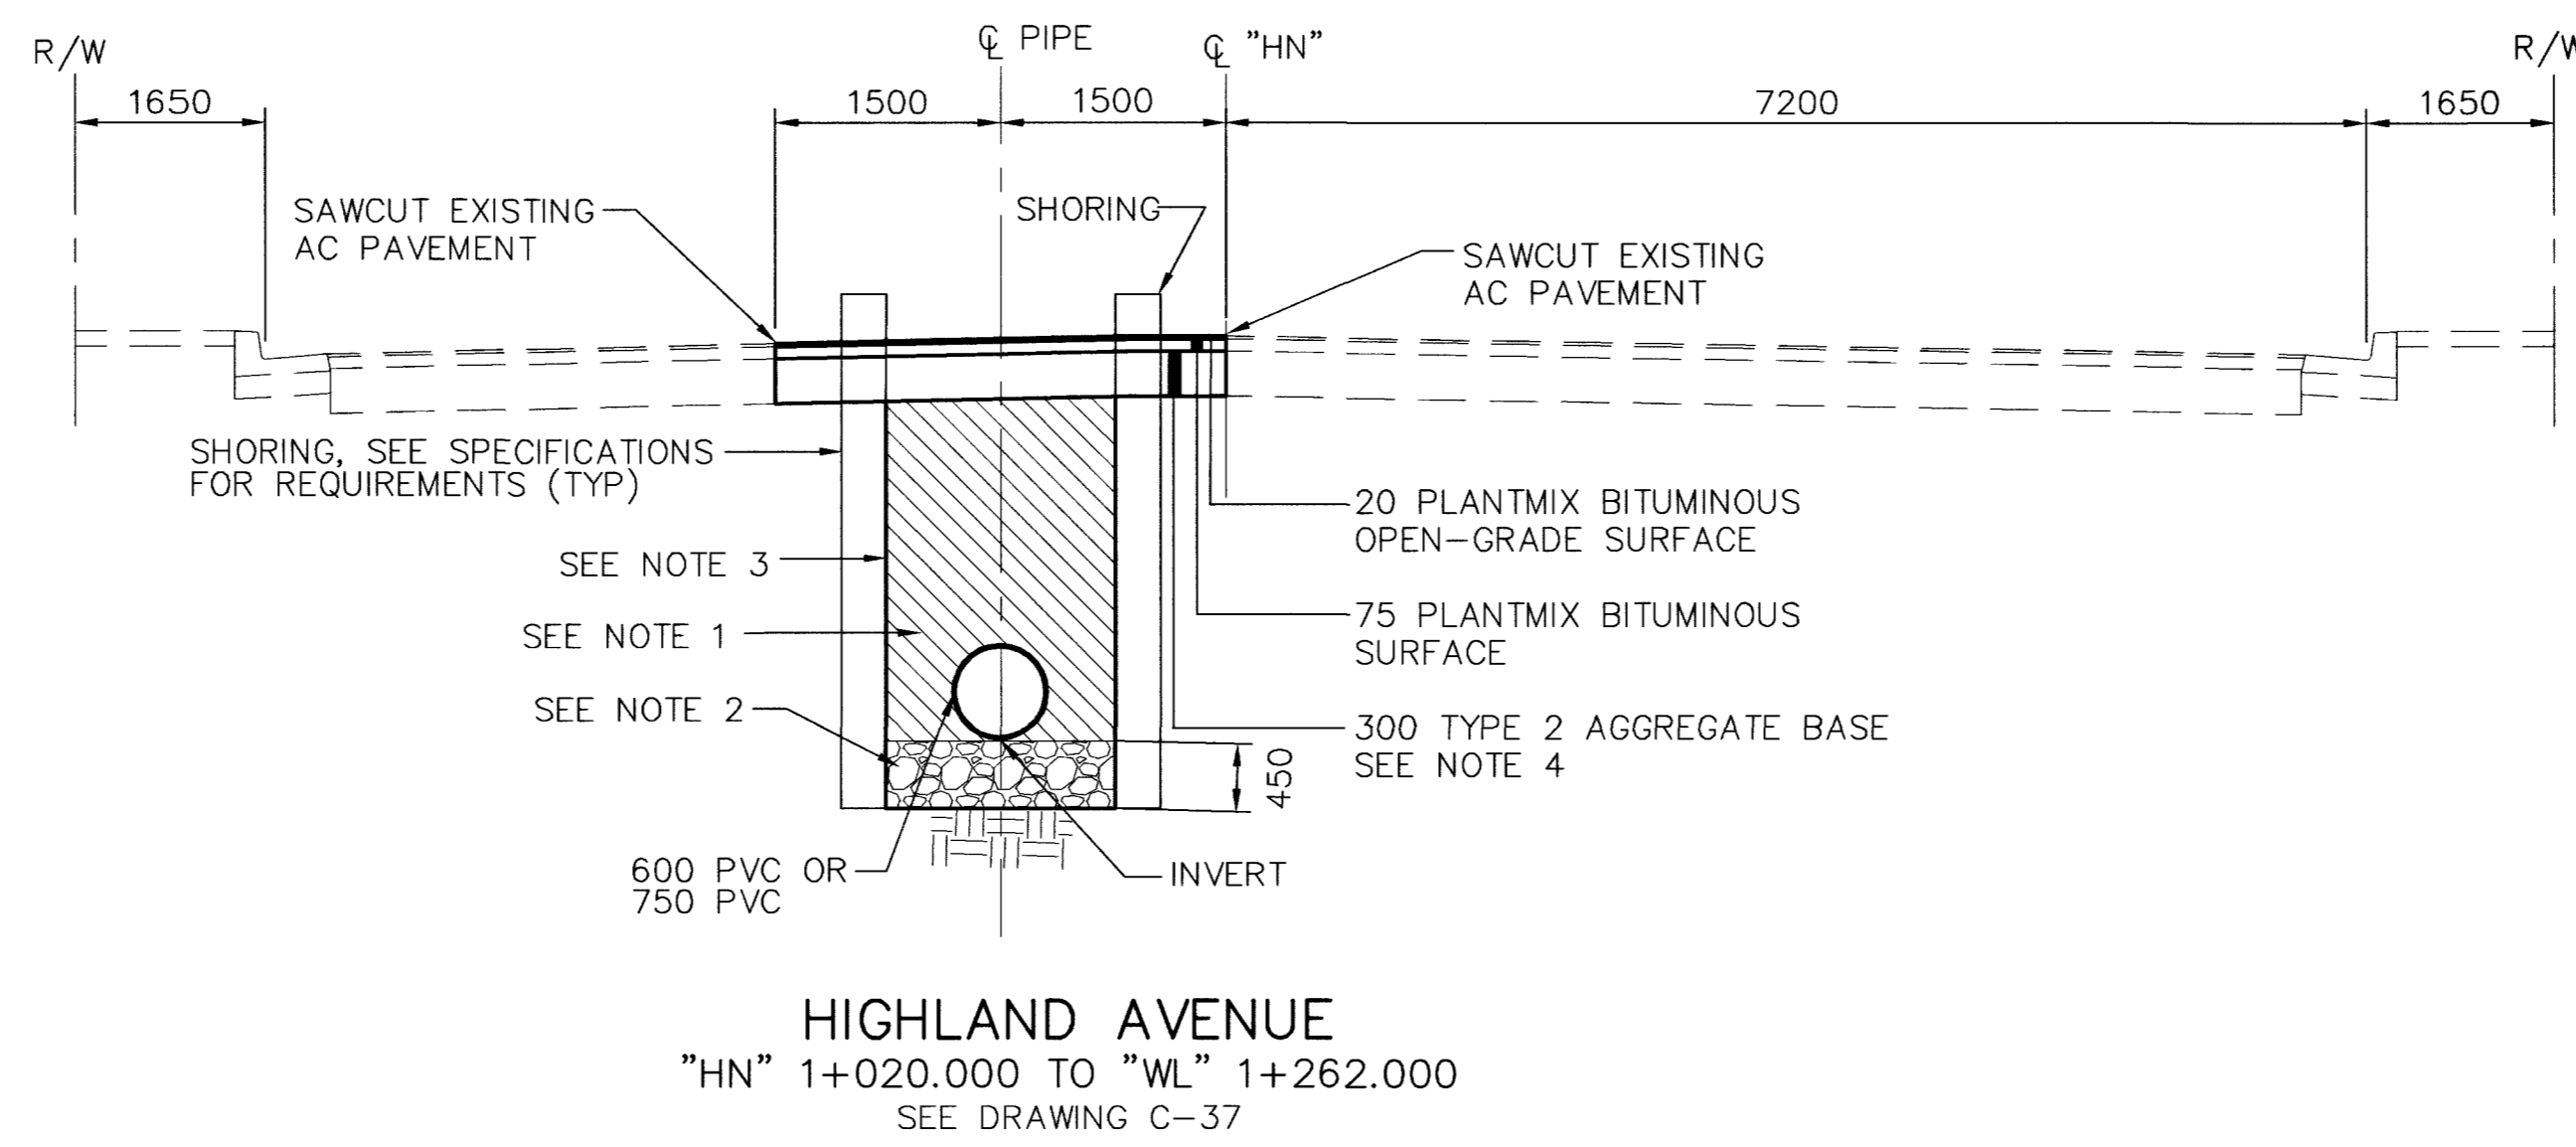


ALL DIMENSIONS ARE IN MILLIMETERS
UNLESS OTHERWISE NOTED.

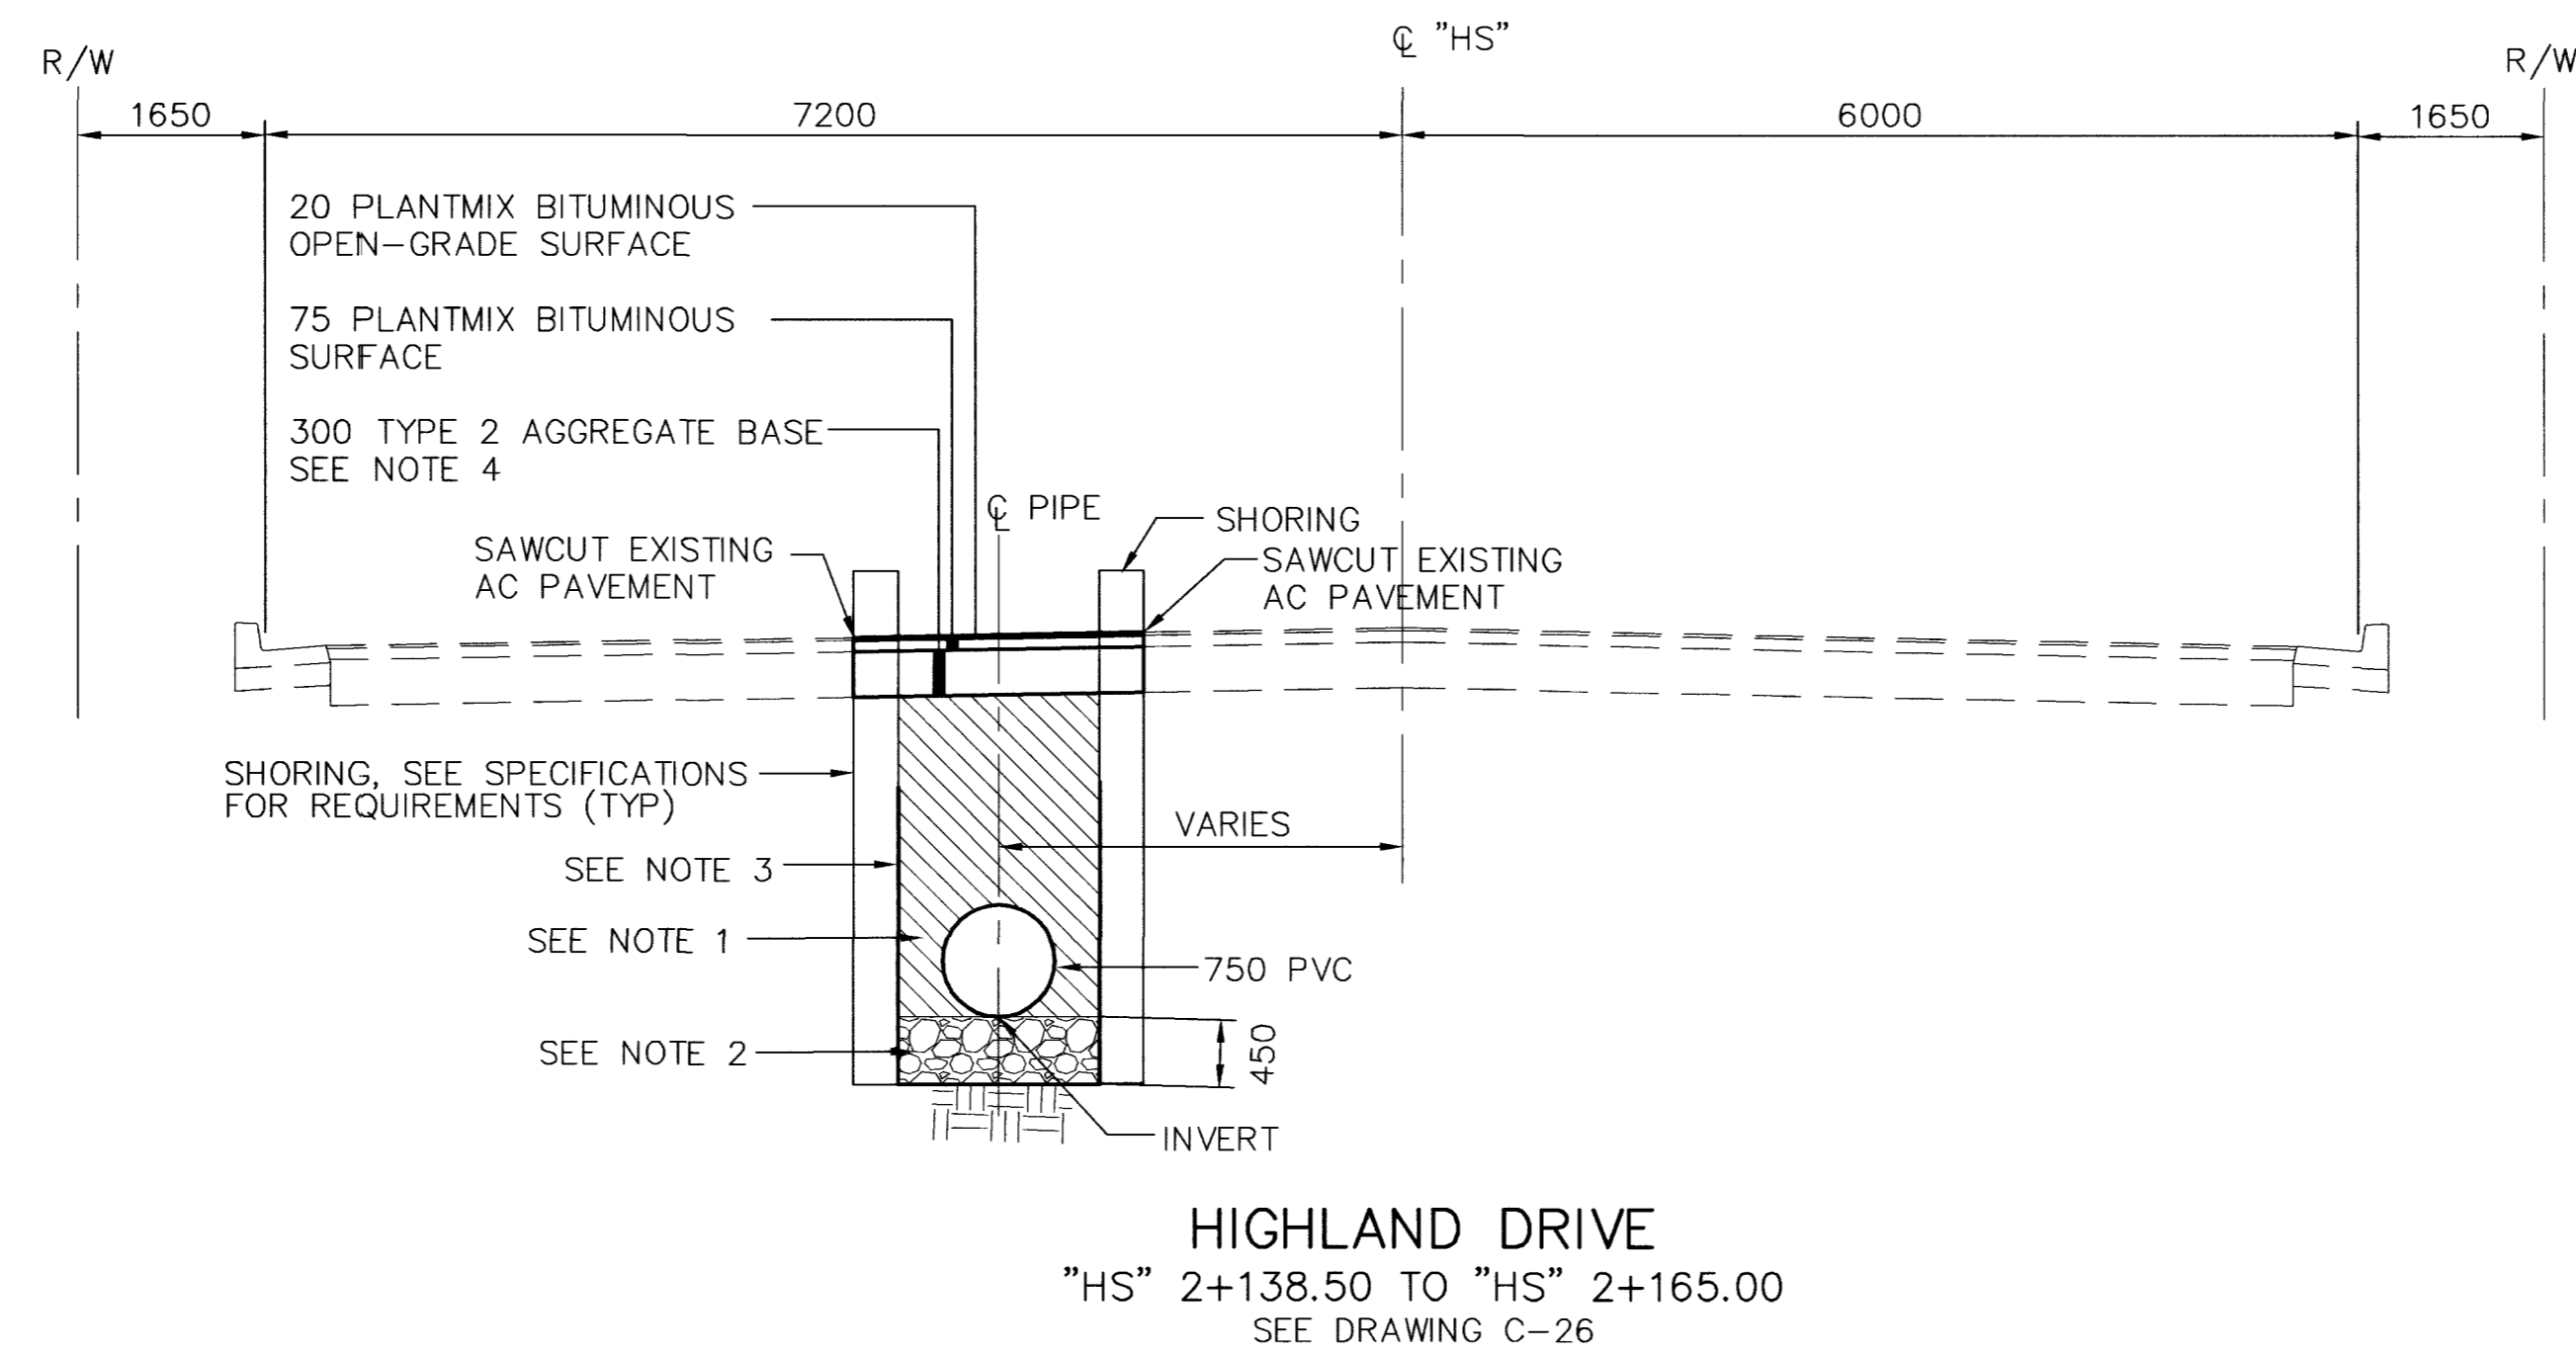

- NOTES:
- PVC GRANULAR BACKFILL. SEE SPECIFICATIONS FOR REQUIREMENTS
 - TYPE 2 BEDDING TO BE COMPACTED TO 95% PER ASTM D1557. SEE SPECIFICATIONS FOR REQUIREMENTS
 - SEE SPECIFICATIONS FOR GEOTEXTILE REQUIREMENTS
 - TYPE 2 AGGREGATE TO BE COMPACTED TO 95% PER ASTM D1557.
 - SEE USDOCA FOR PIPE BEDDING DETAILS.
 - GEOTEXTILE FILTER FABRIC MAY BE OMITTED ADJACENT TO READY-MIX FLOWABLE FILL WHERE THIS MATERIAL IS USED AS A BACKFILL.

REVISIONS	DATE
ADDENDUM 3	4/12/03
RECORD DRAWING	4/30/03


PROJECT # 31804
DESIGN BY DSP
DATE DEC 17, 1999

SCALE (V) N/A
SCALE (H) N/A
FLD. BK. # N/A

PARSONS BRINCKERHOFF
Las Vegas, Nevada



DEPARTMENT OF PUBLIC WORKS
I-15 FREEWAY CHANNEL
TYPICAL SECTIONS

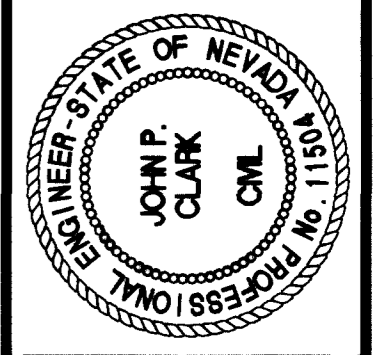

DRAWING No. 14
TS-9
241

52465

RECORD DRAWING METRIC

327-V254