


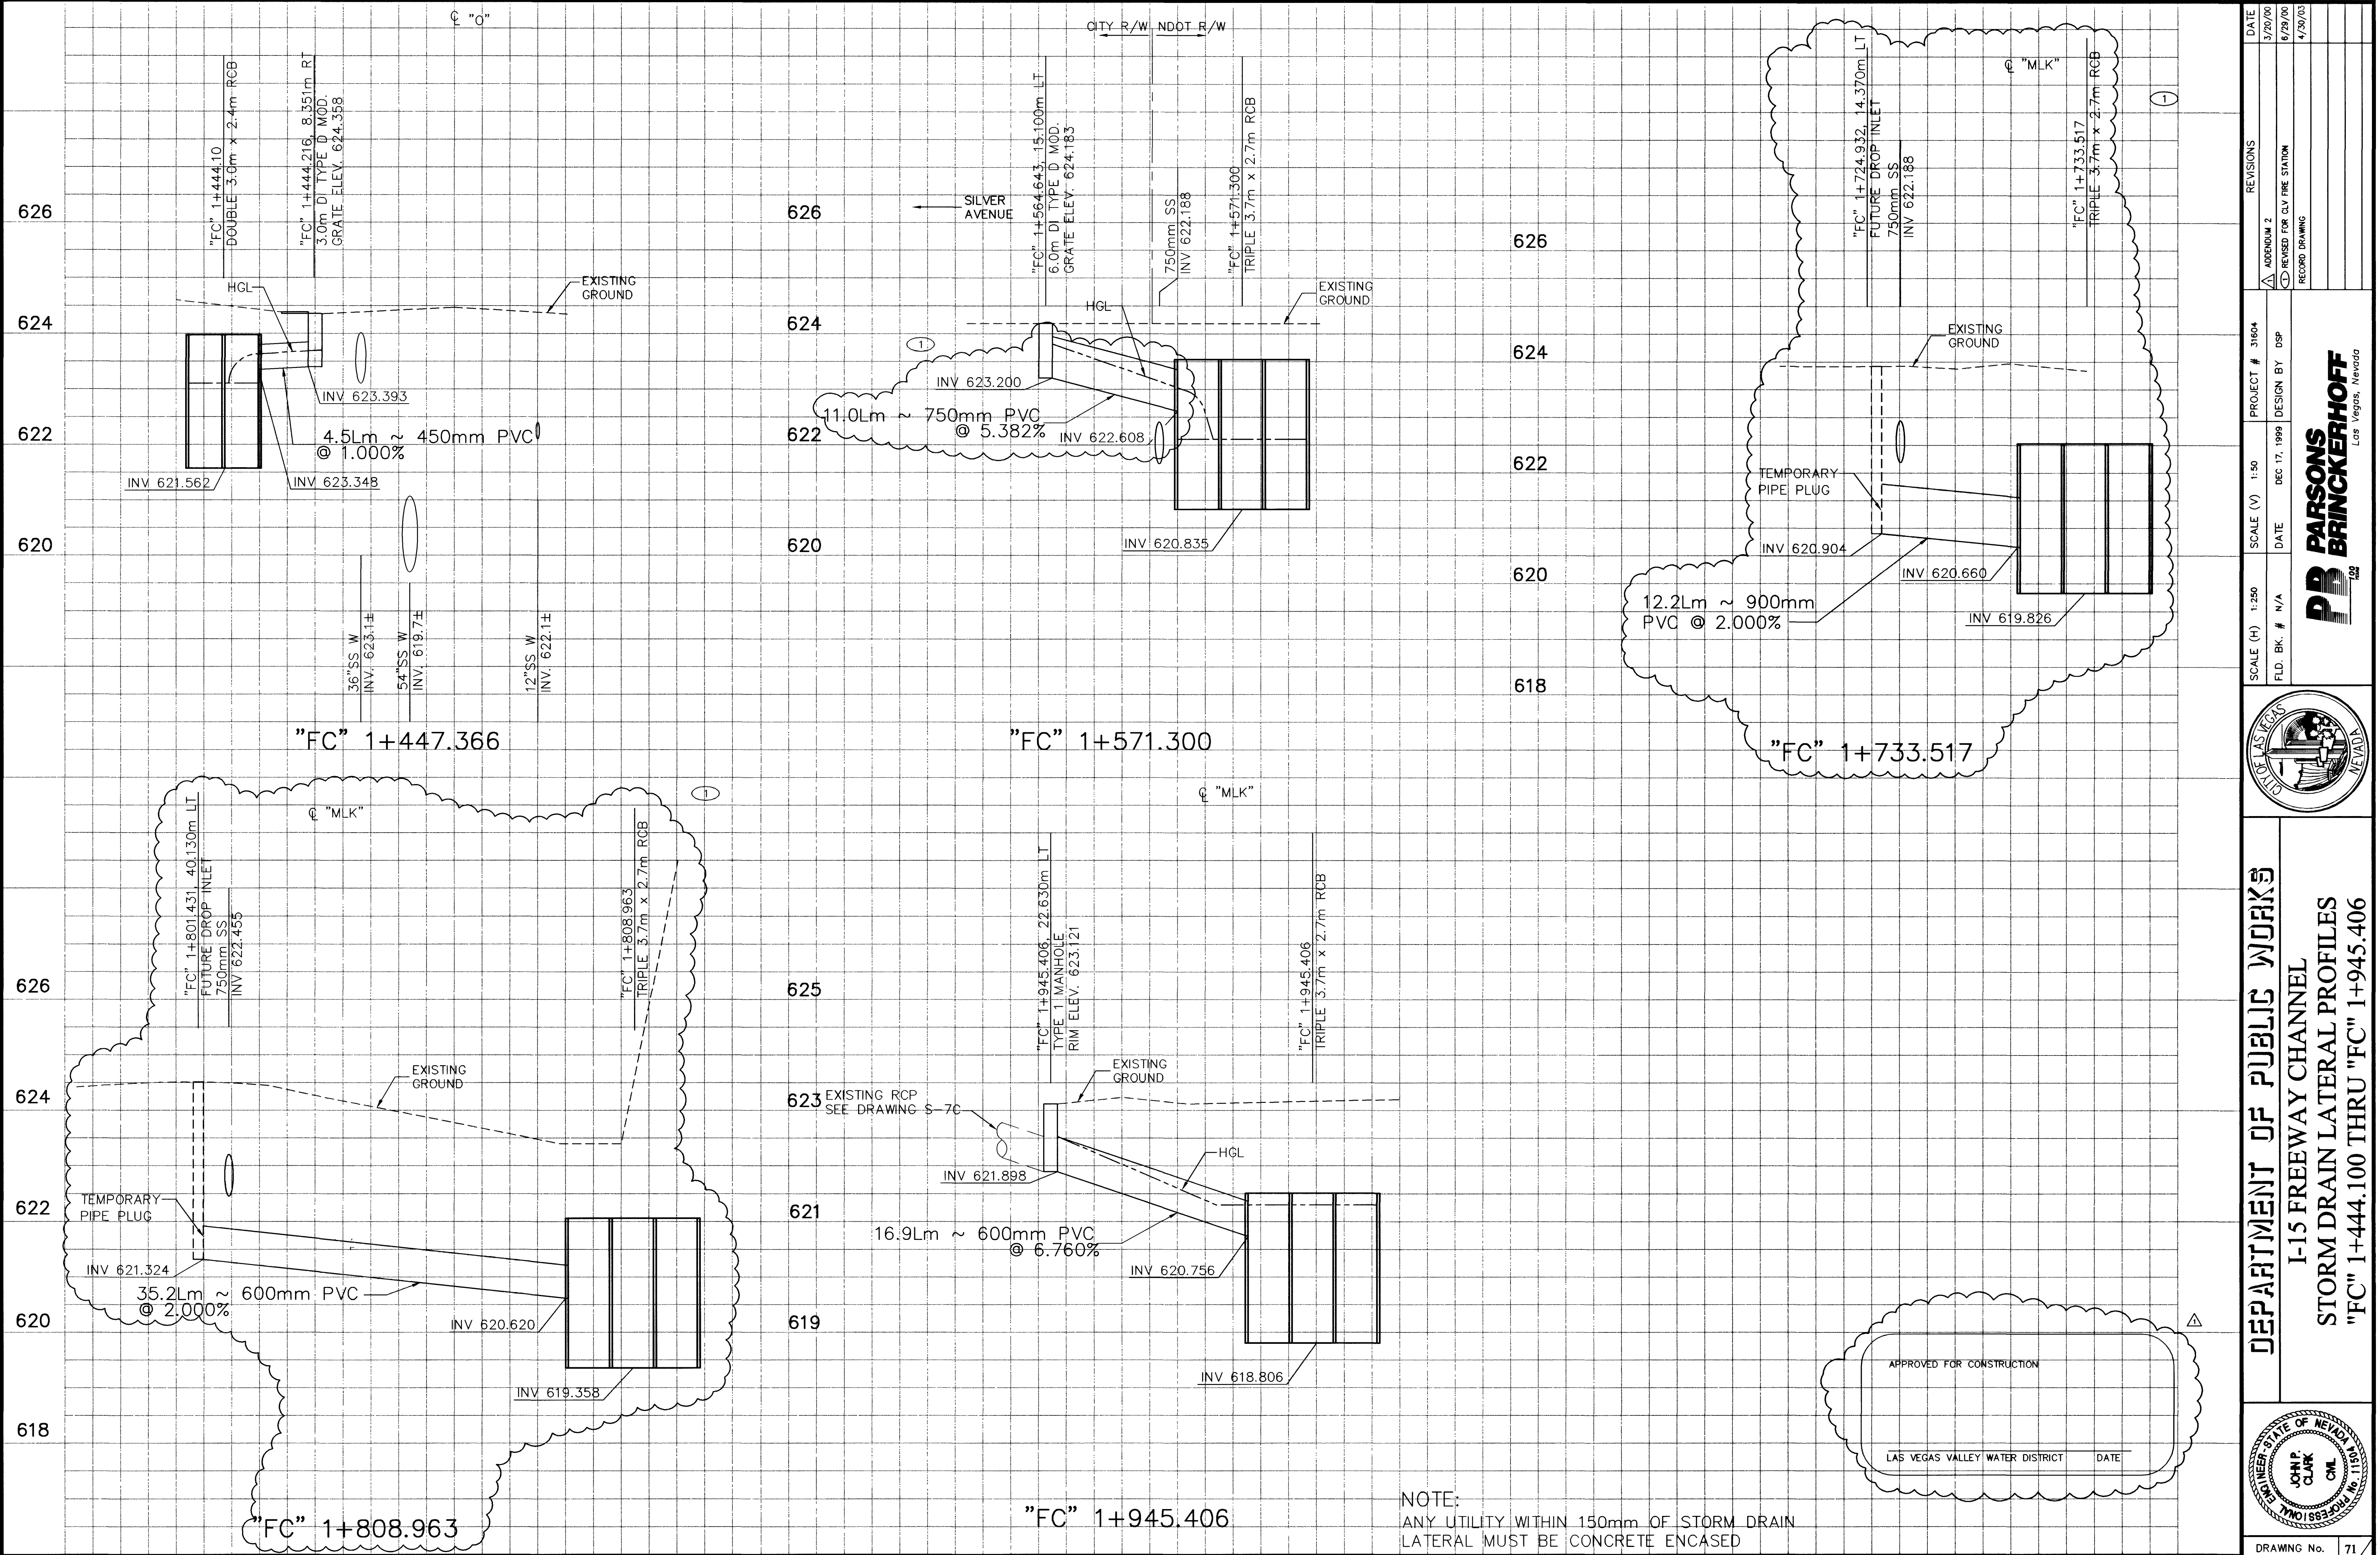

REVISIONS		PROJECT #	DESIGN BY	SCALE (V)	DATE	SCALE (H)	FLD. BK. #	DATE	DATE
DATE	3/20/00	31604	DSP	1:50	DEC 17, 1999	1:250	N/A		
ADDITION 2	6/29/00								
REVISOR FOR QV FIRE STATION	1/20/03								
RECORD DRAWING									

PARSONS
BRINCKERHOFF
Las Vegas, Nevada

STATE OF NEVADA
ENGINEER
JOHN P. CLARK
CML
11518

DEPARTMENT OF PUBLIC WORKS
I-15 FREEWAY CHANNEL
STORM DRAIN LATERAL PROFILES
"FC" 1+444.100 THRU "FC" 1+945.406

APPROVED FOR CONSTRUCTION
LAS VEGAS VALLEY WATER DISTRICT
DATE

DRAWING No. 71
SD-1