


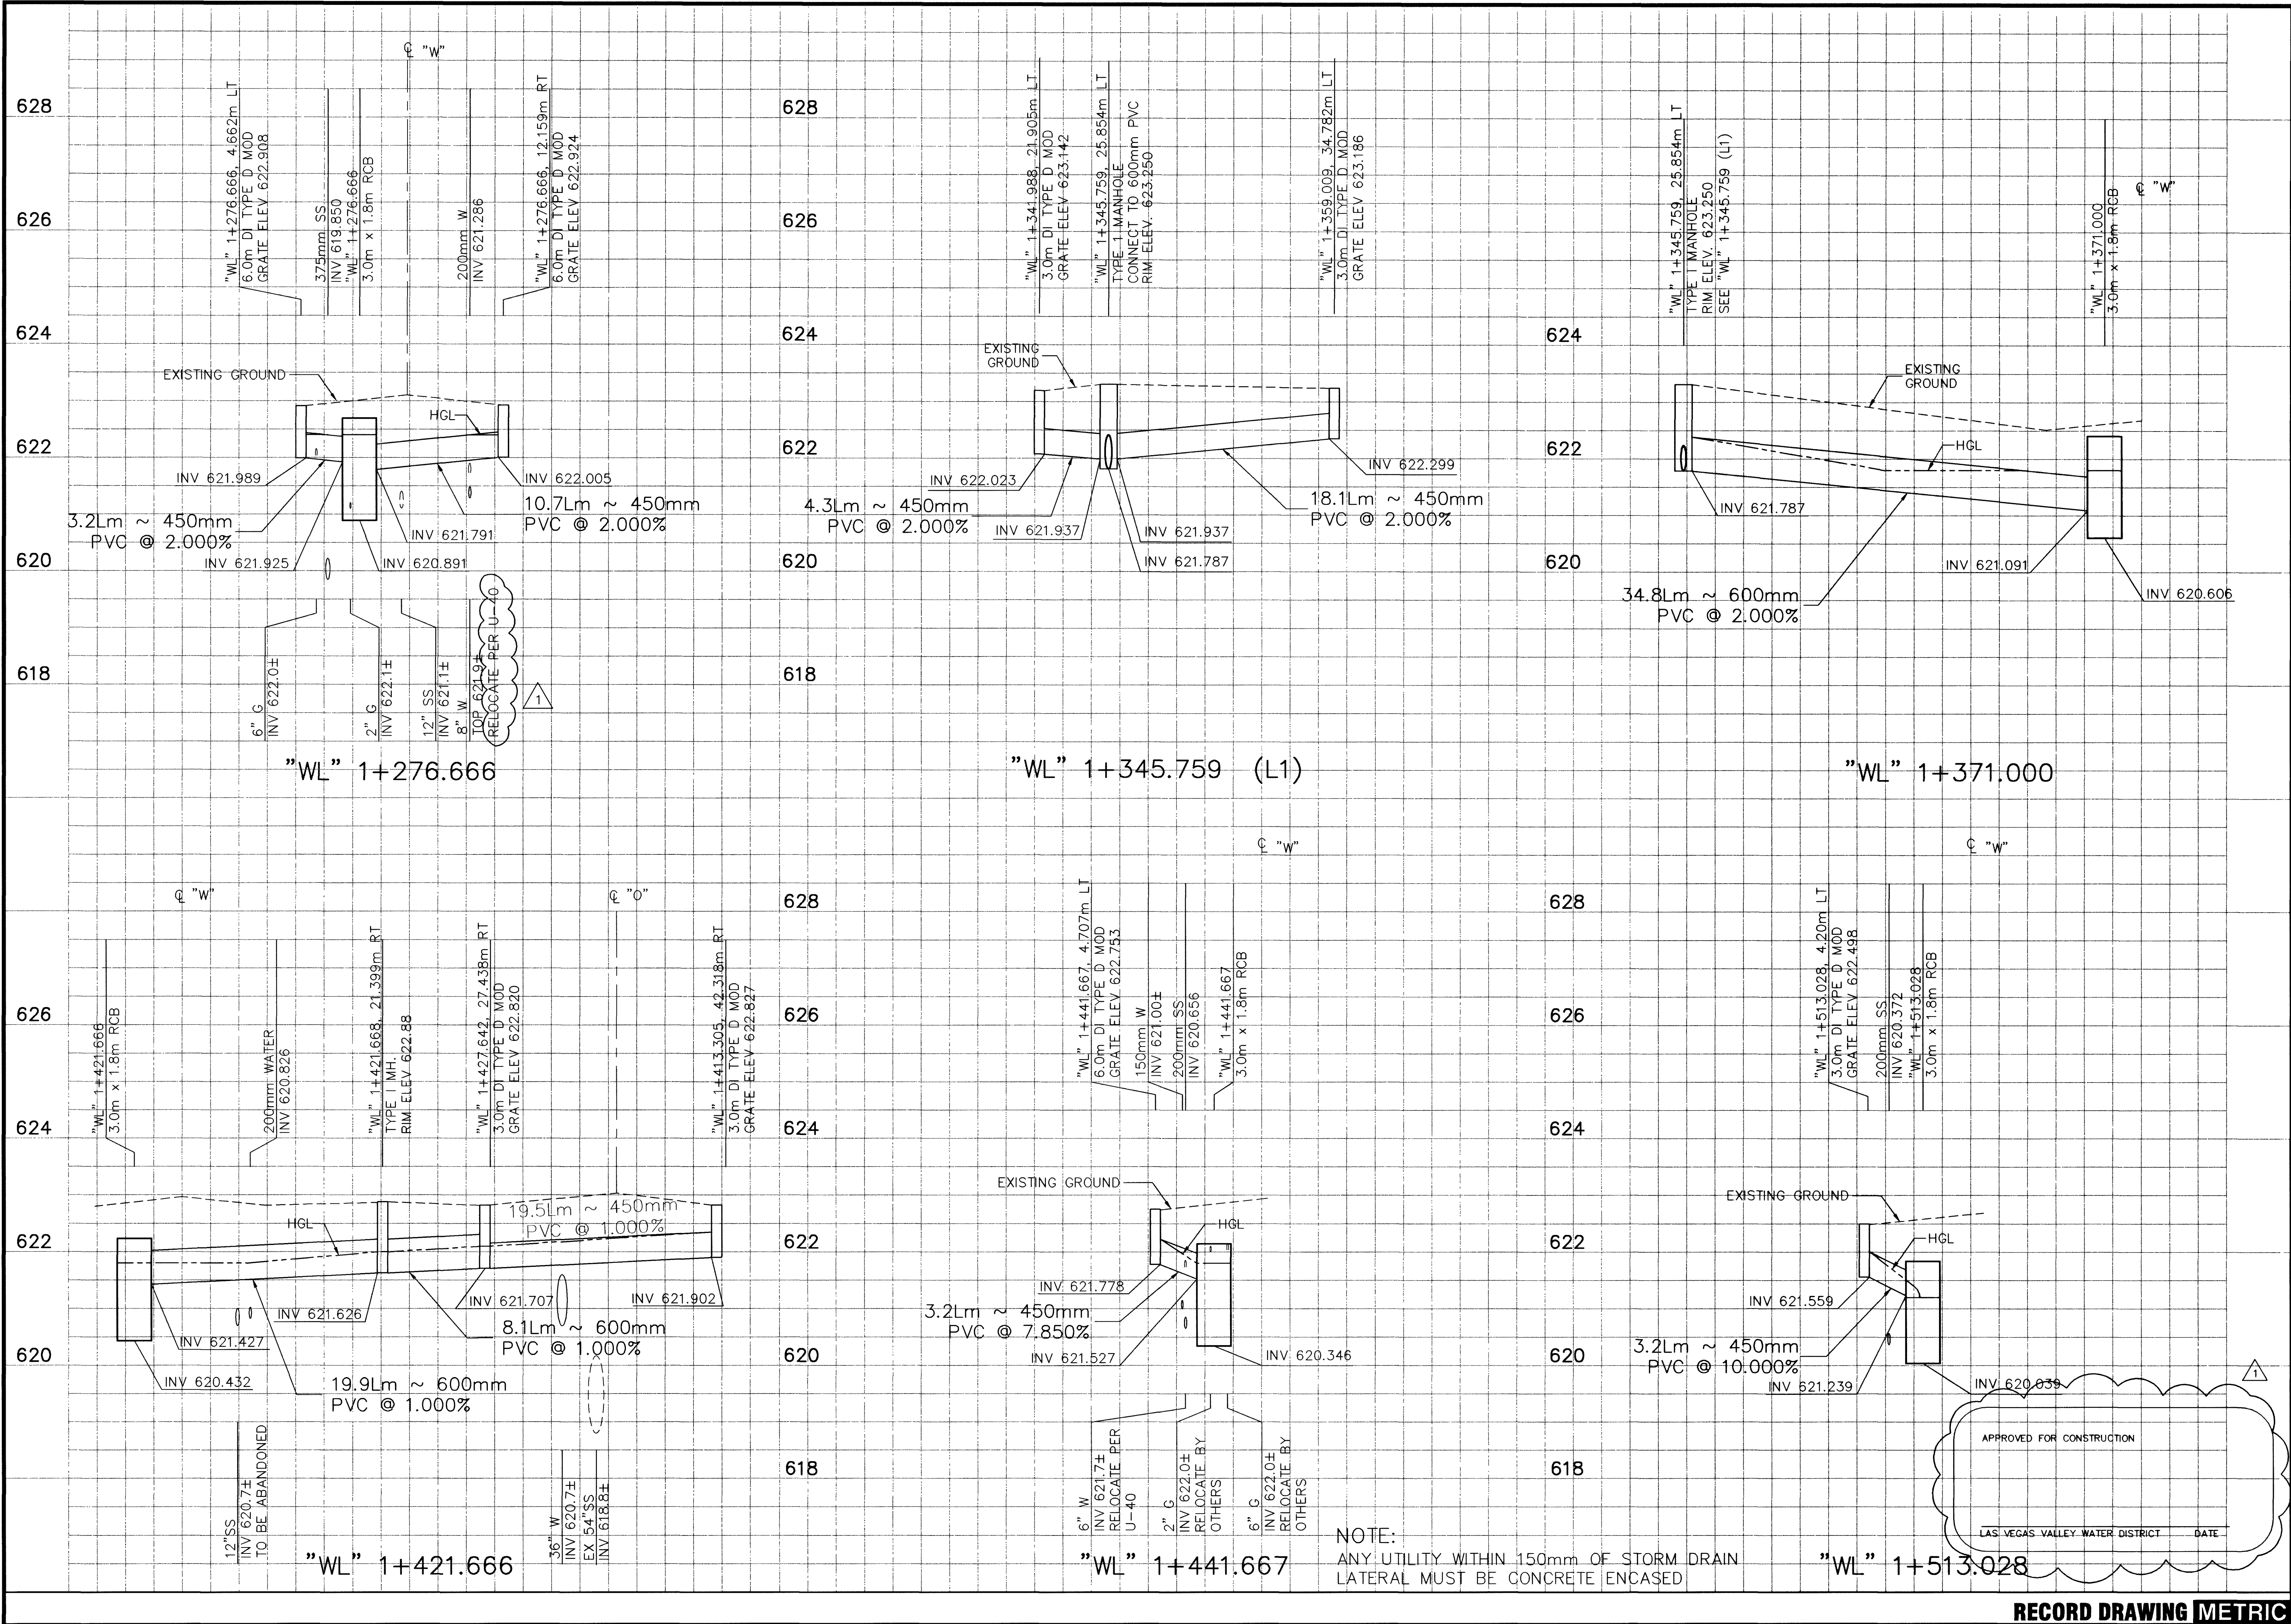

DATE	REVISIONS	PROJECT #	SCALE (V)	SCALE (H)	F.L.D. BK. #	DATE	DESIGN BY	OK
3/30/00		31004	1:50	1:250	N/A	DEC 17, 1998		
4/30/03								

ADDITIONAL 2
RECORD DRAWING

PB PARSONS BRINCKERHOFF
Las Vegas, Nevada

DEPARTMENT OF PUBLIC WORKS
I-15 FREEWAY CHANNEL
STORM DRAIN LATERAL PROFILES
"WL" 1+276.666 THRU "WL" 1+513.028

APPROVED FOR CONSTRUCTION
LAS VEGAS VALLEY WATER DISTRICT
DATE

DRAWING No. 83
SD-13
241