


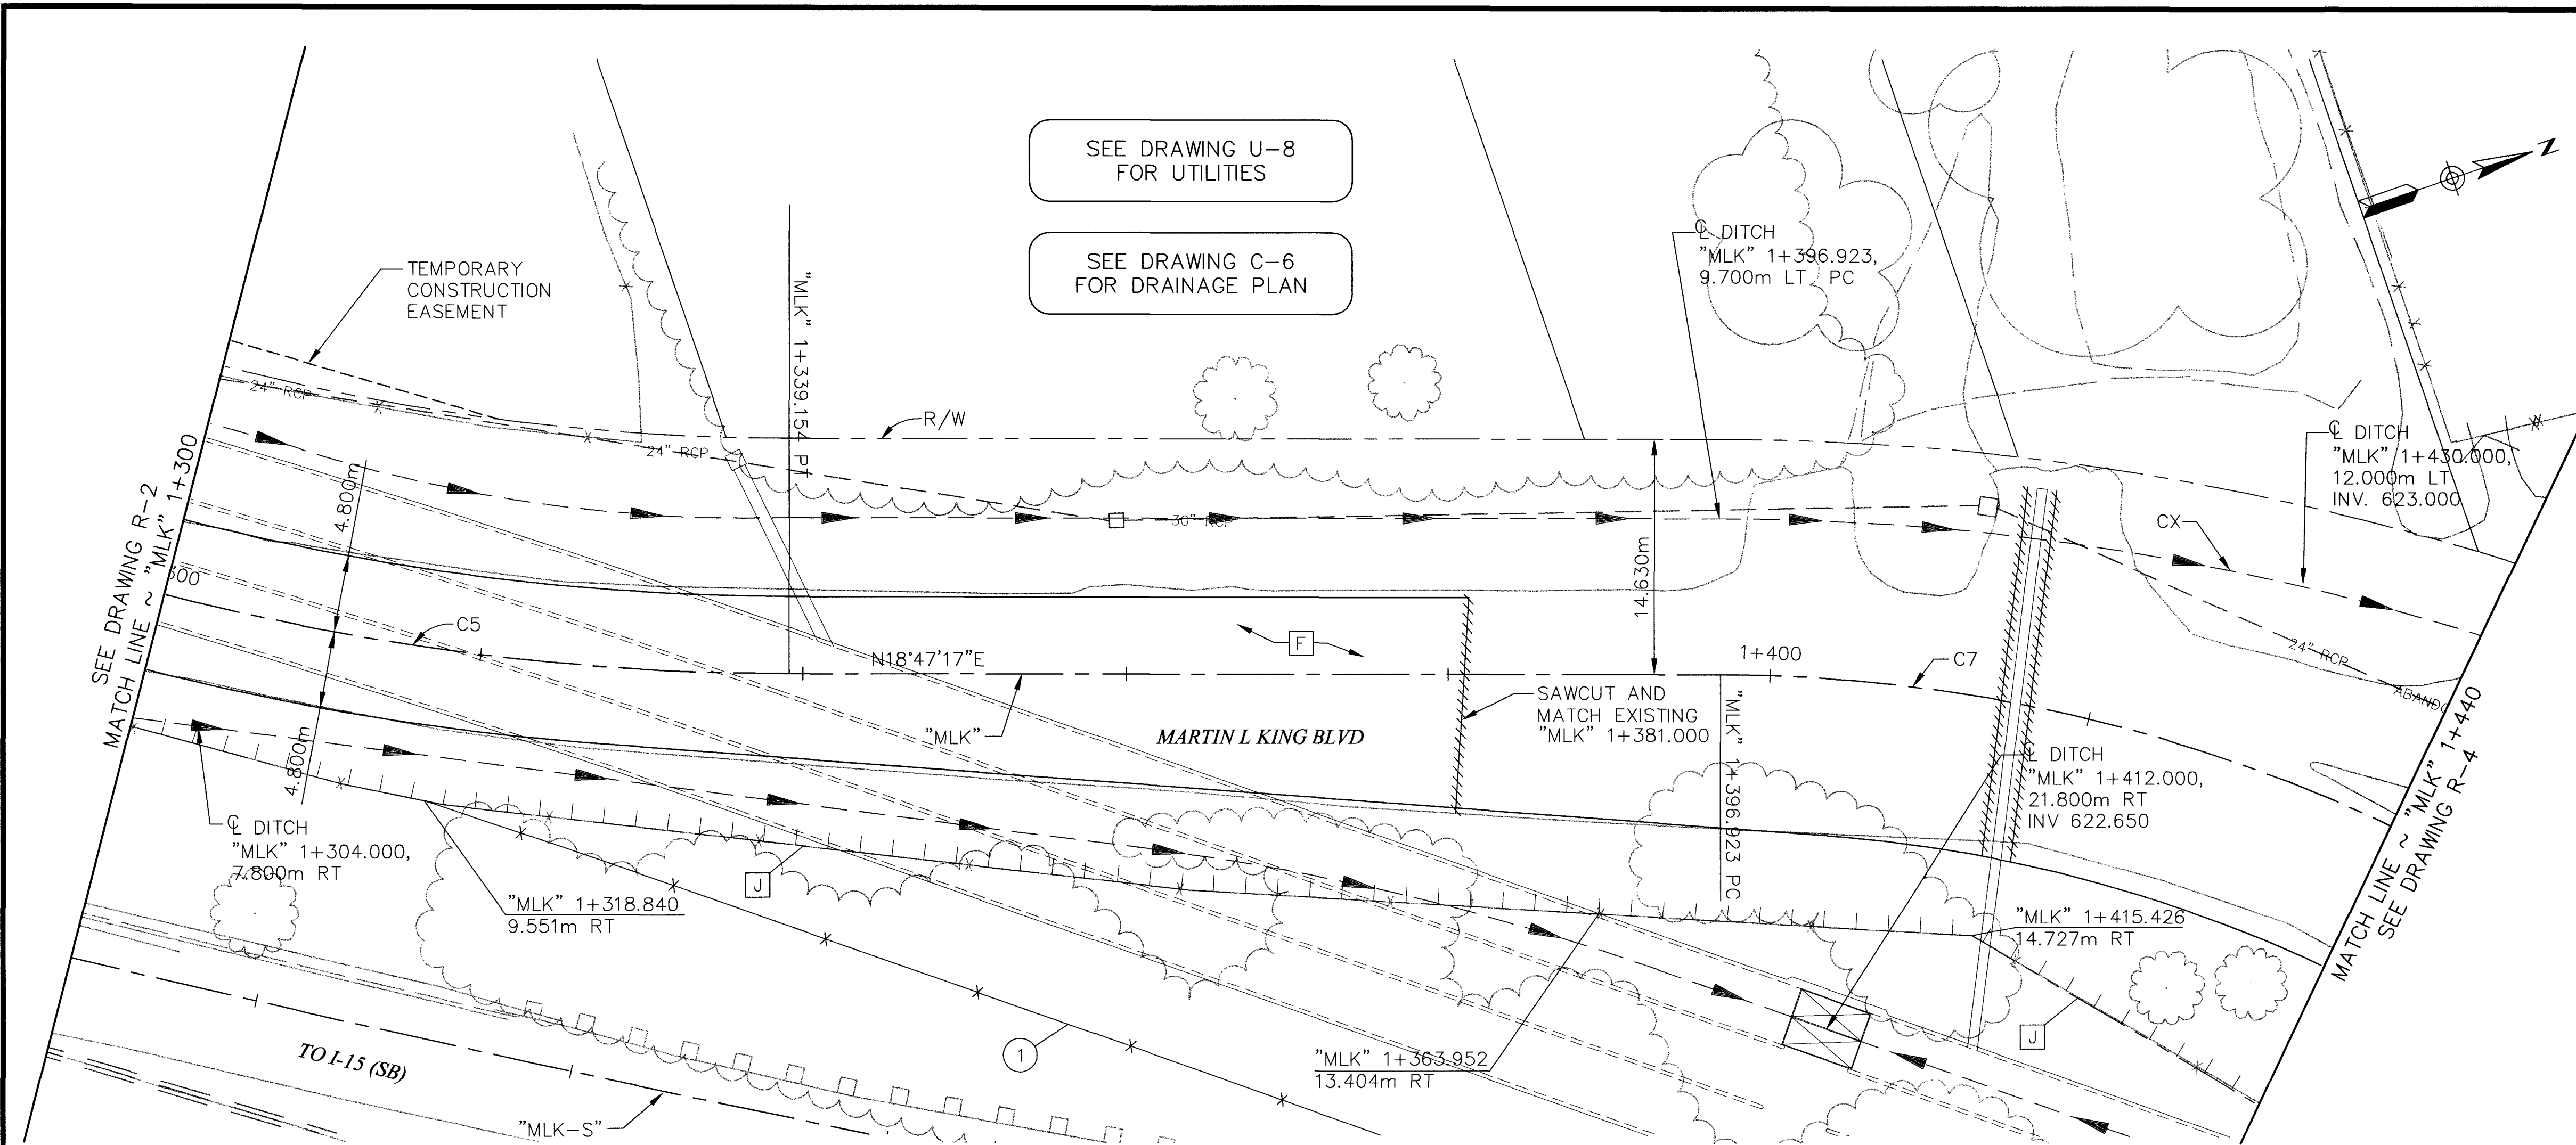

- REMOVAL ITEMS
- [F] REMOVE AC PAVEMENT
 - [J] REMOVE AND RESTORE CHAIN LINK FENCE

- CONSTRUCTION ITEMS
- ① "MLK" 1+317.750, 9.472m RT TO CONSTRUCT TEMPORARY CHAIN LINK FENCE
 - "MLK" 1+440.000, 39.309m RT

"MLK" CURVE DATA

No.	Δ	R	L	T
C5	16°30'00"	156.058m	44.941m	22.627m
C7	31°00'00"	97.527m	52.767m	27.047m
CX	28°44'52"	158.442m	79.497m	40.604m

Call before you Dig.


1-800-227-2800

UNDERGROUND SERVICE (USA)

Call before you Overhead

563-6111

OVERHEAD SERVICE (USA)

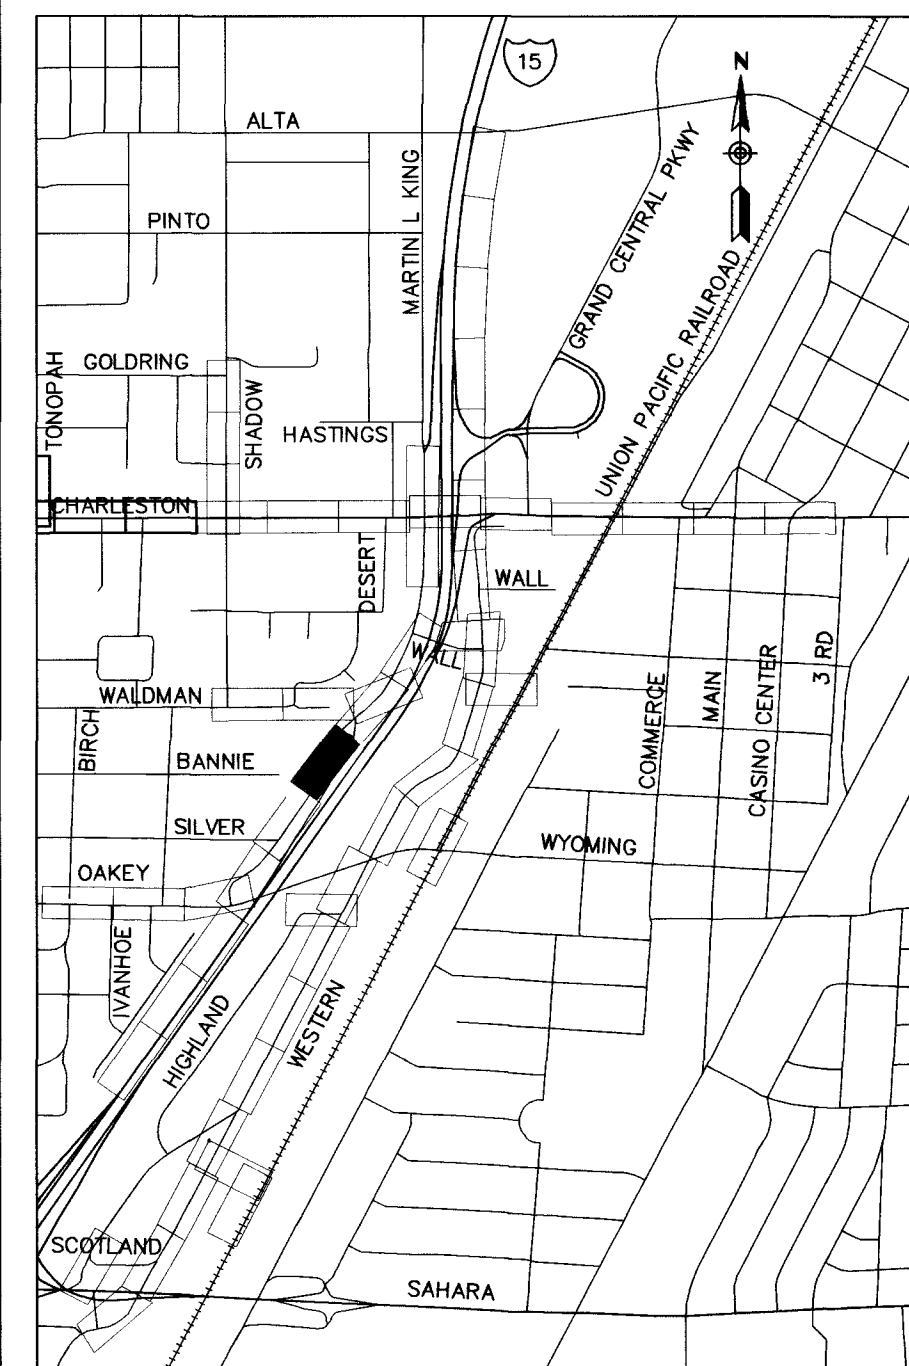

DATE: 6/29/00

REVISIONS:

① REVISED FOR CIVIL FIRE STATION

RECORD DRAWING

PROJECT # 31604

DESIGN BY KFN

SCALE (V) 1:50

DATE DEC 17, 1999

SCALE (H) 1:250

F.D. BK. # N/A

PARSONS
BRINCKERHOFF

Los Vegas, Nevada

CLAS LAS VEGAS

NEVADA

DEPARTMENT OF PUBLIC WORKS

I-15 FREEWAY CHANNEL

CONSTRUCTION PLAN AND PROFILE

"MLK" 1+300 TO "MLK" 1+440

REGISTERED PROFESSIONAL ENGINEER

JOHN P. CLARK

CIVIL

NO. 11150

EXPIRATION DATE 11/15/05

DRAWING No. 99

R-3

241