


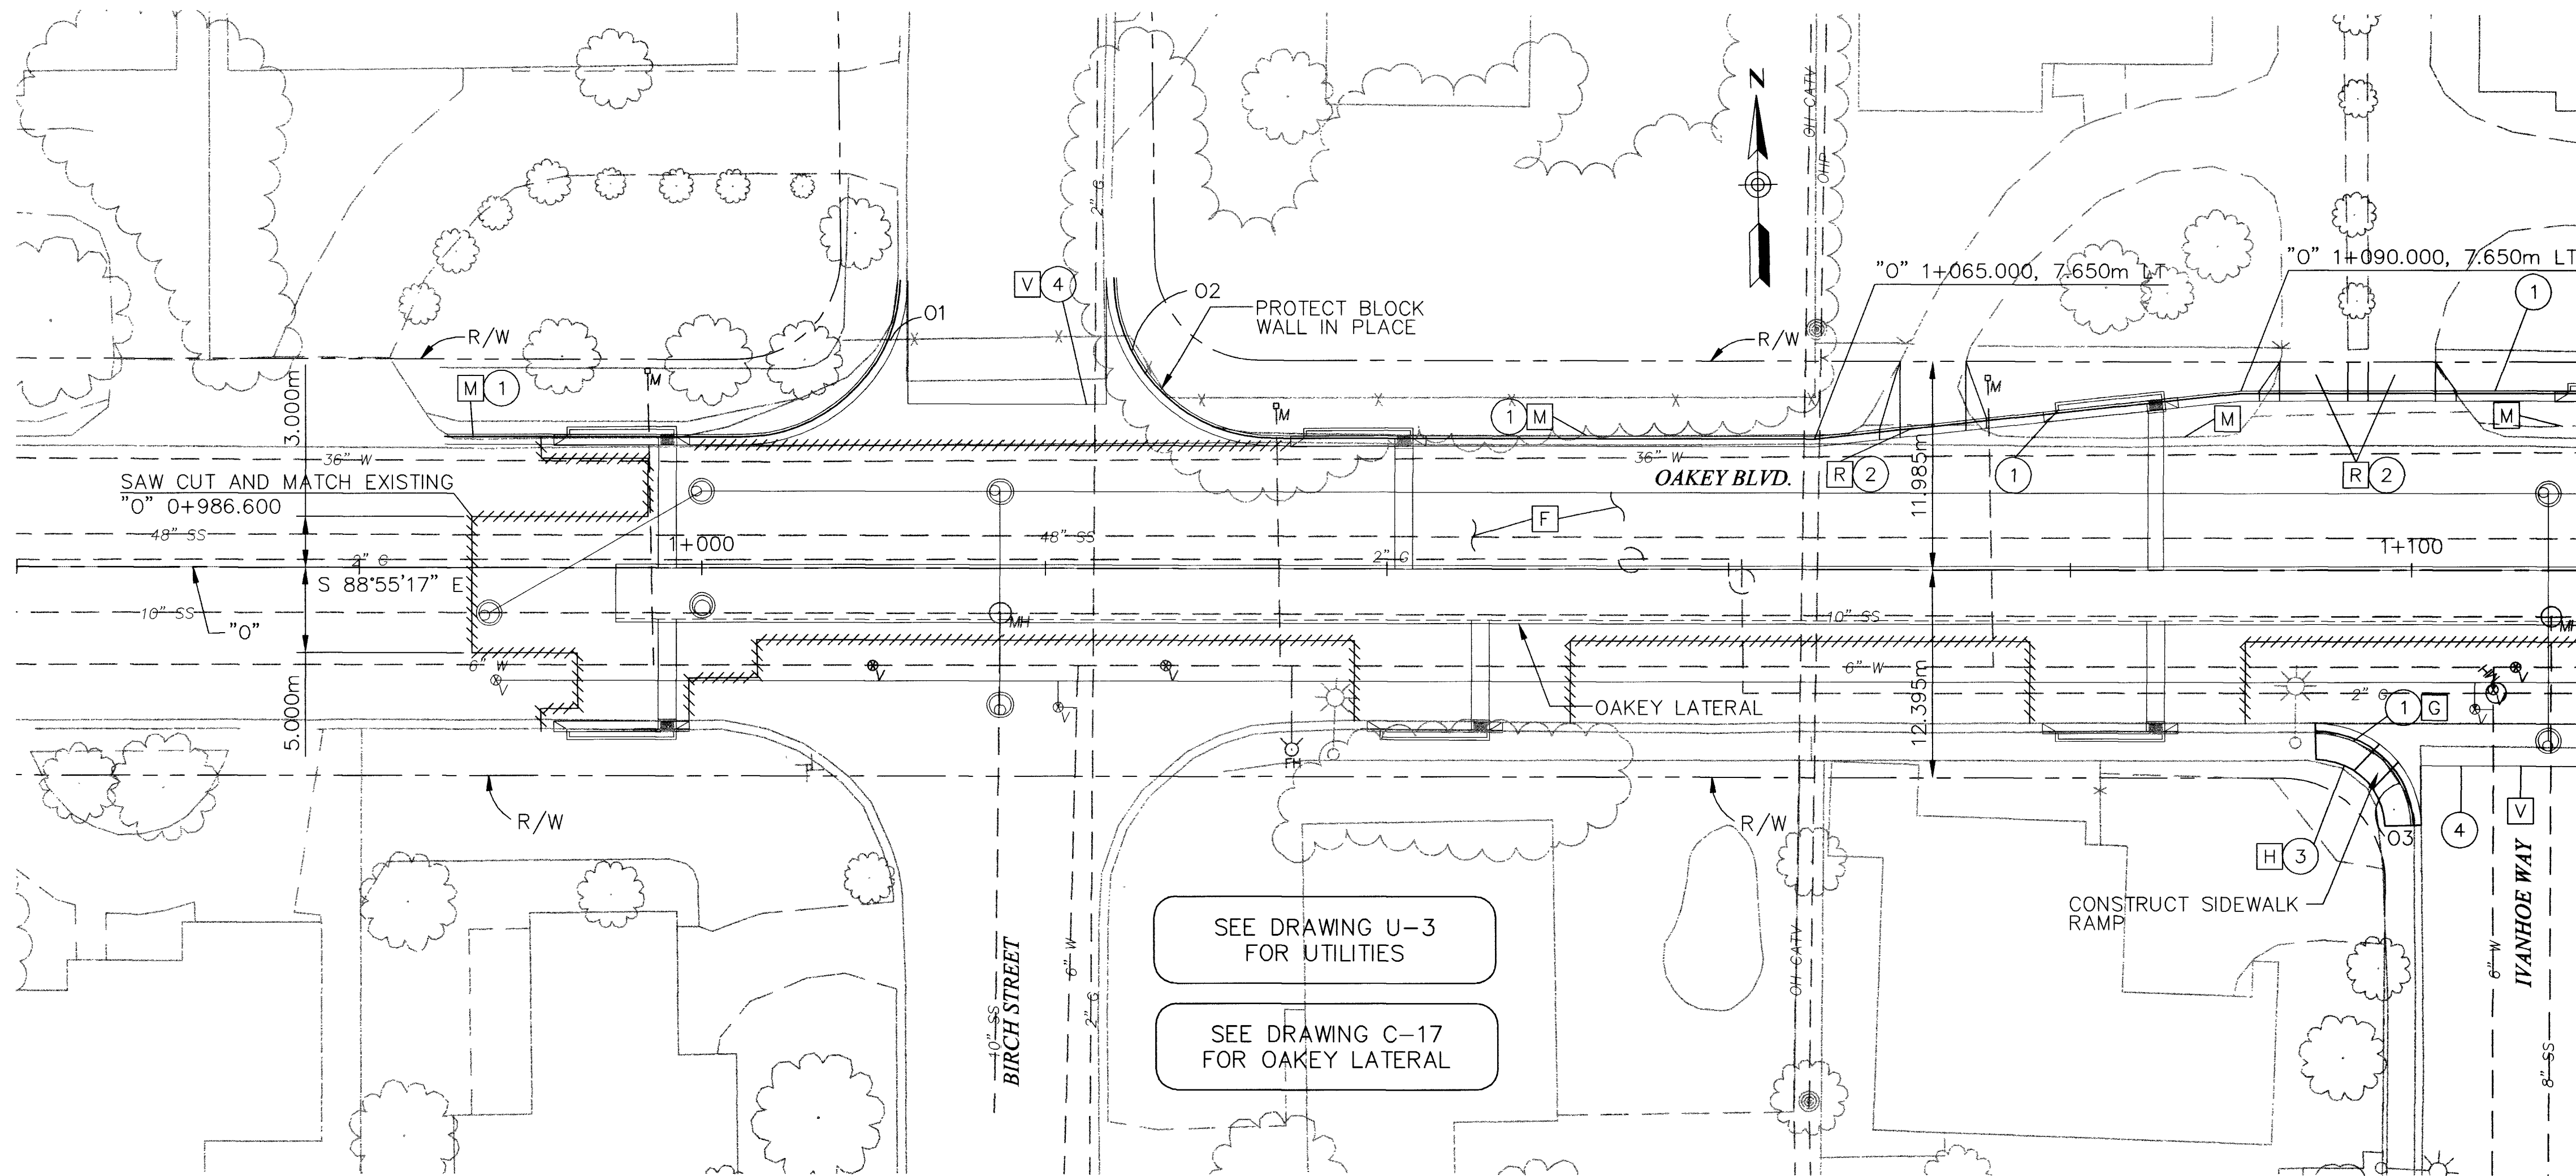

- REMOVAL ITEMS**
- [F] REMOVE AC PAVEMENT
 - [M] REMOVE ASPHALT CURB
 - [R] REMOVE DRIVEWAY
 - [G] REMOVE CURB AND GUTTER
 - [H] REMOVE SIDEWALK
 - [V] REMOVE CROSS DRAIN
- CONSTRUCTION ITEMS**
- ① "O" 0+985.000, 7.650m LT TO 1+111.590, 16.840m LT
 "O" 1+024.040, 17.018m LT TO 1+068.810, 8.060m LT
 "O" 1+075.070, 8.740m LT TO 1+091.070, 10.350m LT
 "O" 1+094.370, 9.450m RT TO 1+100.120, 14.984m RT
 "O" 1+102.590, 10.350m LT TO 1+110.000, 10.350m LT
 CONSTRUCT TYPE "L" CURB AND GUTTER
 - ② "O" 1+068.810, 8.060m LT TO 1+075.070, 8.740m LT
 "O" 1+091.070, 10.350m LT TO 1+096.860, 10.350m LT
 "O" 1+096.860, 10.350m LT TO 1+102.590, 10.350m LT
 CONSTRUCT CONCRETE DRIVEWAY
 - ③ "O" 1+094.400, 11.120m RT TO 1+098.440, 15.020m RT
 CONSTRUCT CONCRETE SIDEWALK
 - ④ "O" 1+002.300, 7.200m LT TO 1+033.340, 7.200m LT
 "O" 1+094.360, 9.000m RT TO 1+118.320, 9.020m RT
 CONSTRUCT CONCRETE CROSS GUTTER

"O" CURVE TABLE

No.	Δ	R	L	T
01	89°20'18"	9.300m	14.501m	9.193m
02	90°25'18"	9.300m	14.677m	9.369m
03	90°00'00"	5.646m	8.869m	5.646m

Call before you Dig.


1-800-277-2600

UNDERGROUND SERVICE (USA)

Call before you Overhead

563-6111

OVERHEAD SERVICE (USA)

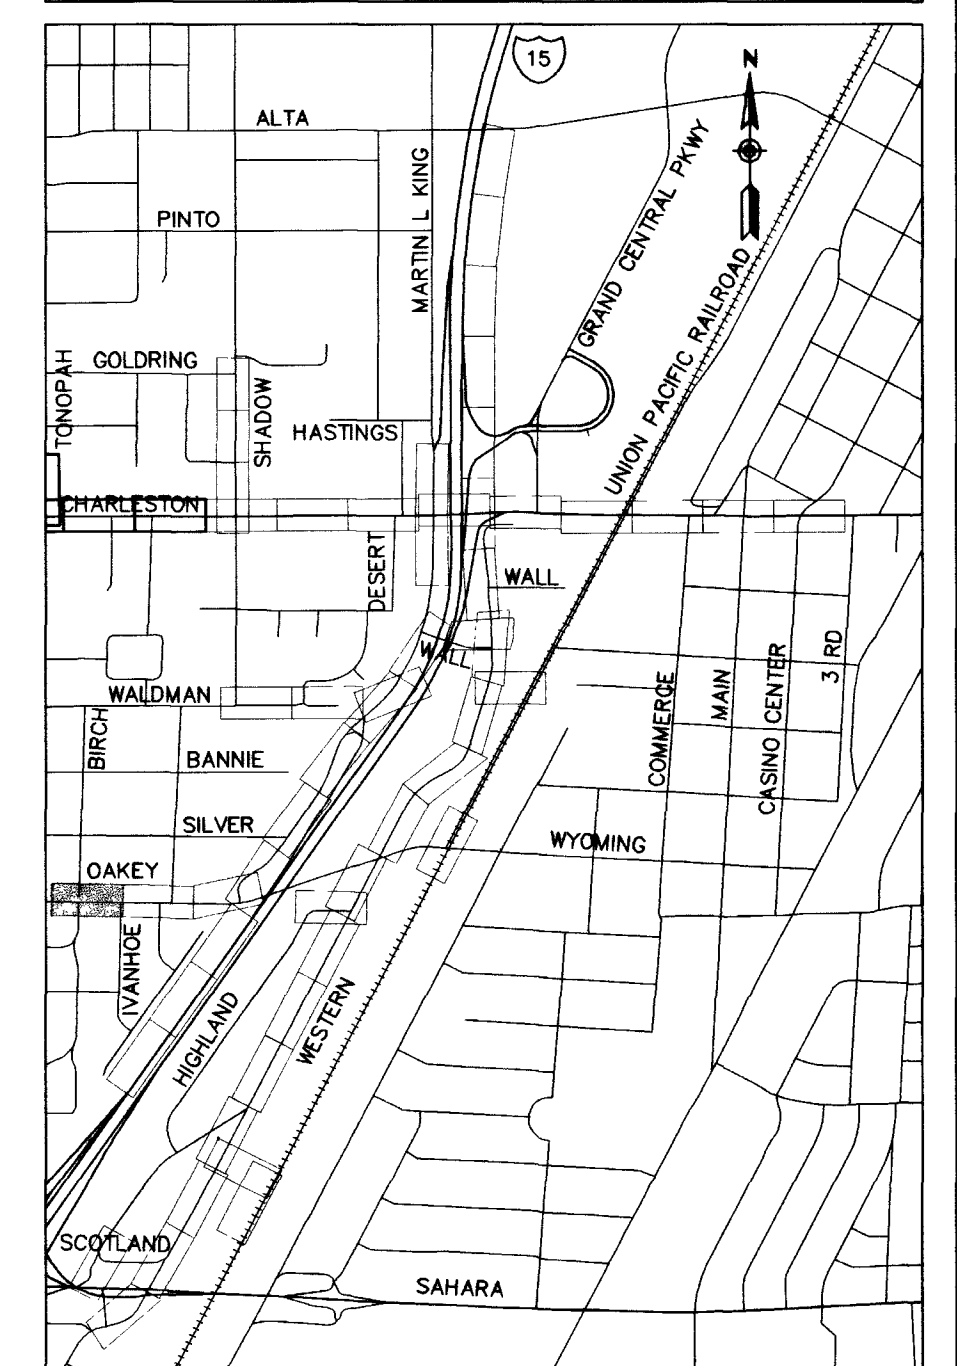

DATE: 4/29/23

REVISIONS:

RECORD DRAWING

PROJECT # 31604

DESIGN BY BPP

DATE DEC 17, 1999

SCALE (H) 1:250

SCALE (V) 1:50

F.L.D. BK. # N/A

PARSONS BRINCKERHOFF

Las Vegas, Nevada

DEPARTMENT OF PUBLIC WORKS

I-15 FREEWAY CHANNEL

CONSTRUCTION PLAN

"O" 0+986.600 TO "O" 1+110

RECORD DRAWING METRIC

R-11

107

241