



NOTE:
ANY UTILITY WITHIN 150mm OF STORM DRAIN
LATERAL MUST BE CONCRETE ENCASED

REVISIONS	DATE
ADDITION 2	3/30/00
ADDITION 3	4/12/00
RECORD DRAWING	4/30/03

SCALE (H) 1:250
SCALE (V) 1:50
PROJECT # 31604
DATE DEC 17, 1998
DESIGN BY OK
F.L.D. BK. # N/A

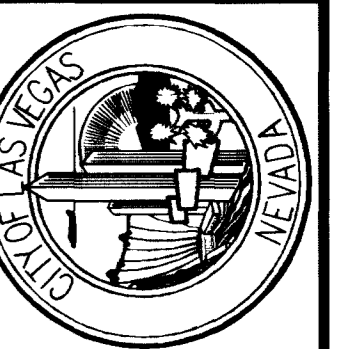

DEPARTMENT OF PUBLIC WORKS
I-15 FREEWAY CHANNEL
STORM DRAIN LATERAL PROFILES
"MLK" 1+398.000 THRU "MLK" 1+936.000

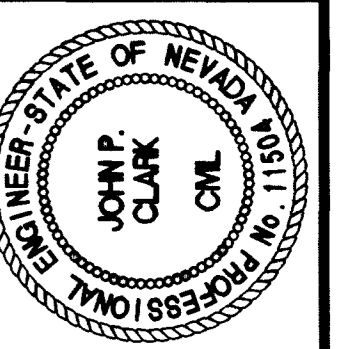

DRAWING No. 94
SD-24

RECORD DRAWING METRIC