


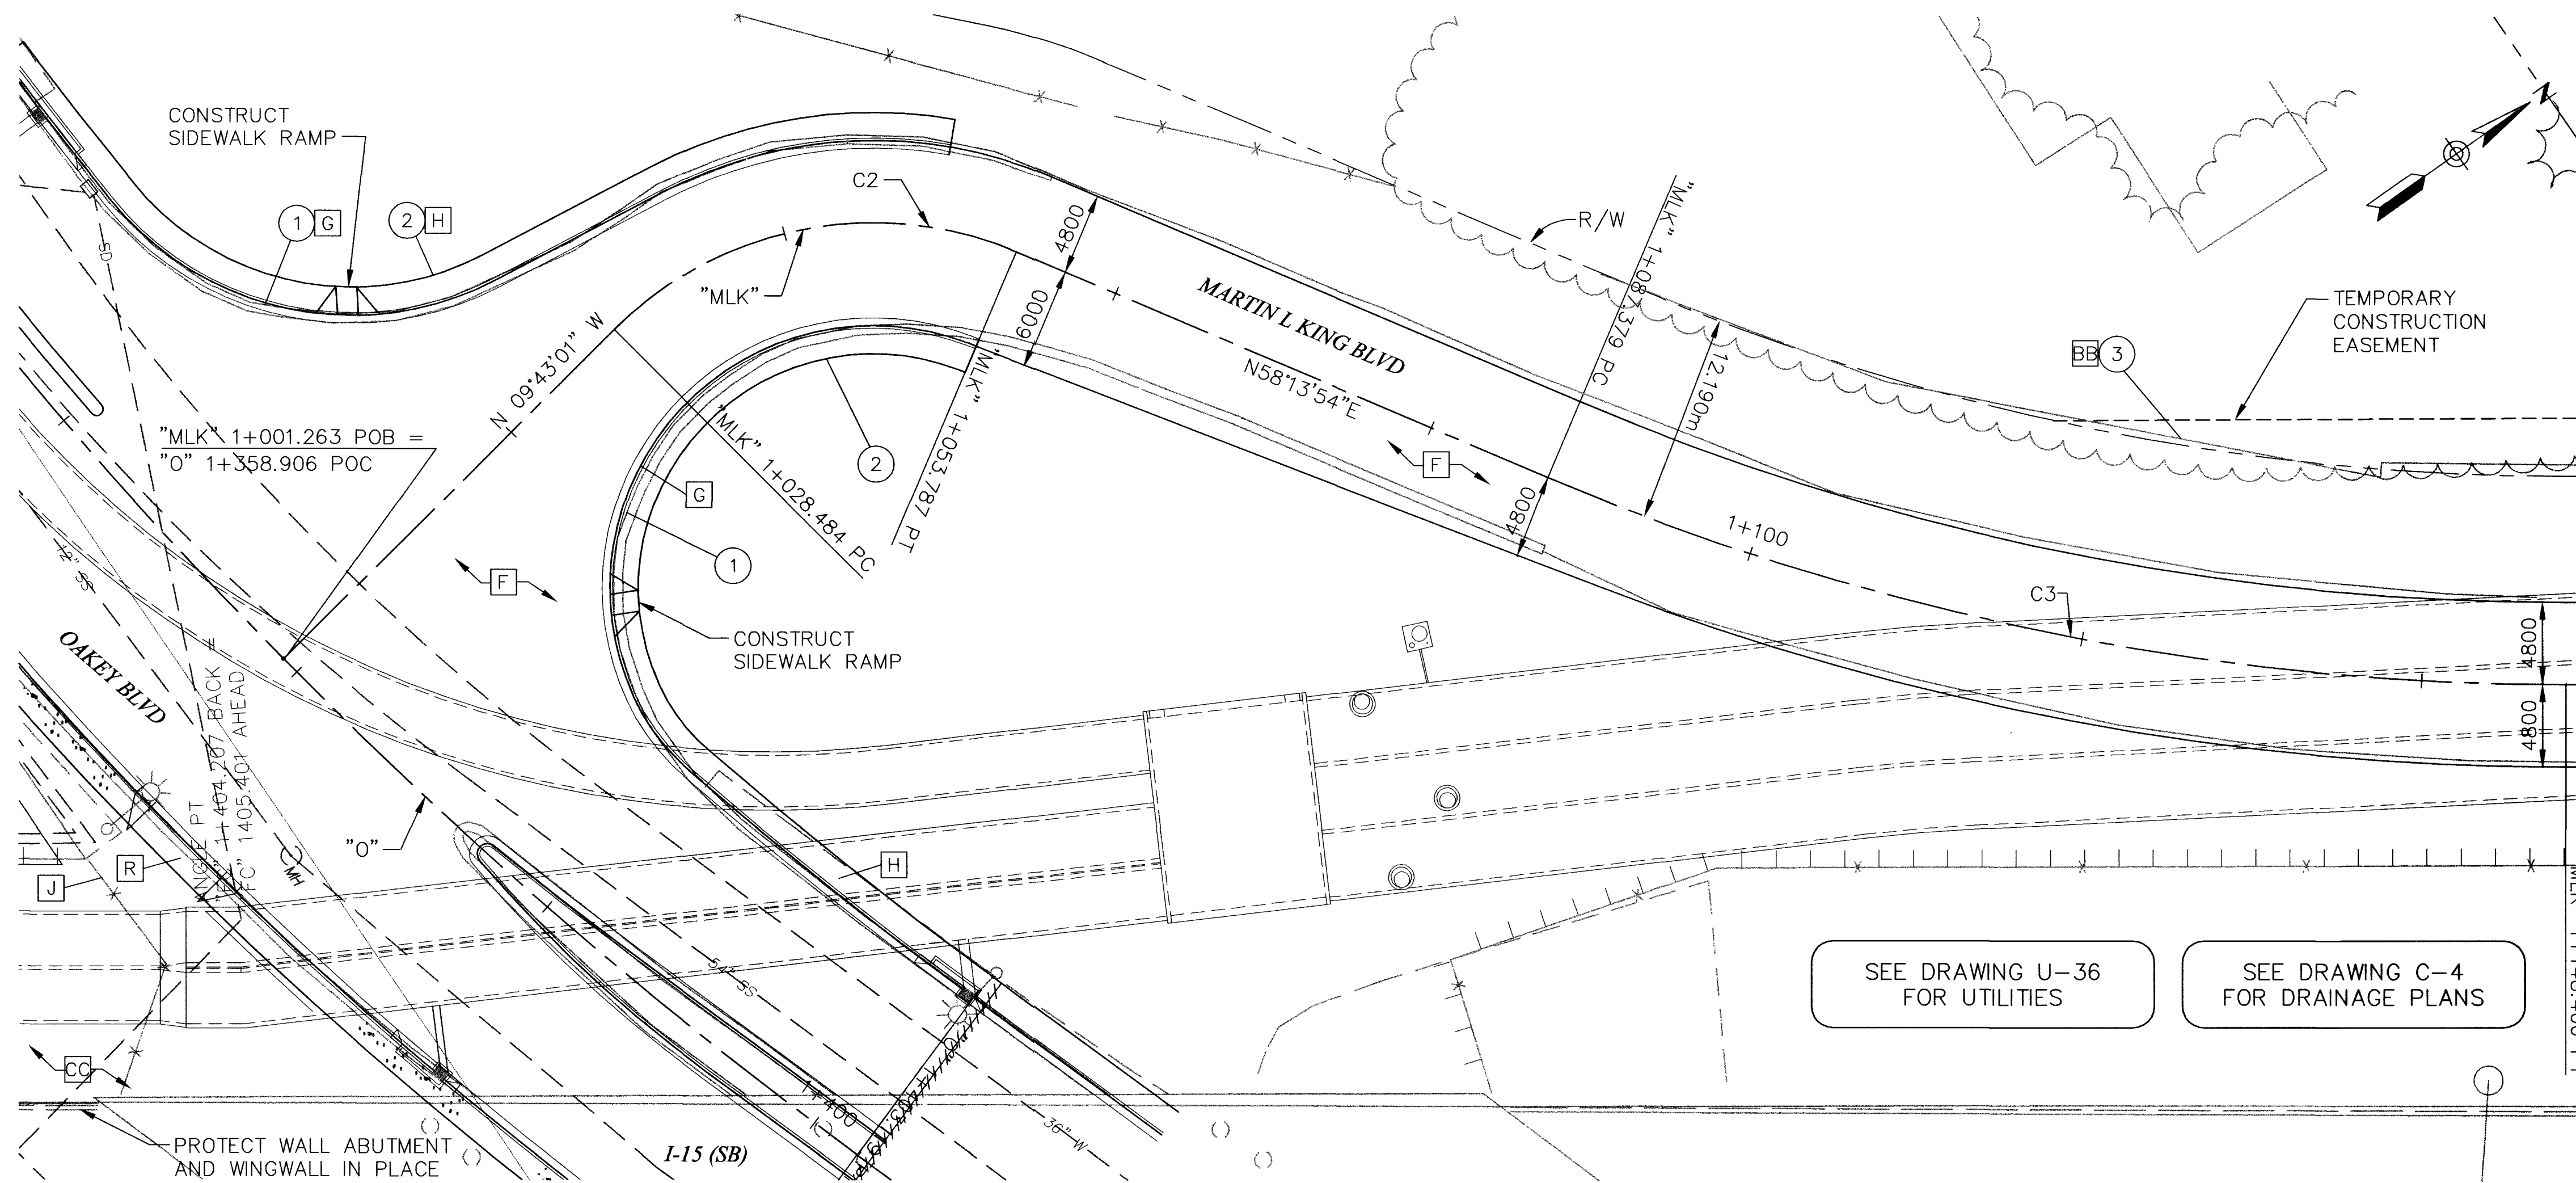

- REMOVAL ITEMS**
- [F] REMOVE AC PAVEMENT
 - [G] REMOVE CURB AND GUTTER
 - [H] REMOVE SIDEWALK
 - [L] REMOVE AND RESTORE CHAIN LINK FENCE
 - [R] REMOVE DRIVEWAY
 - [BB] REMOVE BLOCK WALL
 - [CC] REMOVE CONCRETE SLOPE PAVING AND REPLACE PER NDOT STD DRAWING B-26.1.1

- CONSTRUCTION ITEMS**
- ① "MLK" 1+013.060, 25.970m LT CONSTRUCT TYPE "L" CURB AND GUTTER
 "MLK" 1+053.790, 4.800m LT
 "MLK" 1+013.400, 21.540m RT TO
 "MLK" 1+053.790, 6.000m RT
 - ② "MLK" 1+014.700, 25.800m LT CONSTRUCT CONCRETE SIDEWALK
 "MLK" 1+053.790, 6.450m LT
 "MLK" 1+015.040, 21.420m RT TO
 "MLK" 1+053.790, 7.640m RT
 - ③ "MLK" 1+115.636, 12.191m LT CONSTRUCT BLOCK WALL
 "MLK" 1+150.000, 12.837m LT


SEE DRAWING U-36 FOR UTILITIES

SEE DRAWING C-4 FOR DRAINAGE PLANS

MATCH LINE ~ "MLK" 1+150
SEE DRAWING R-2


"MLK" CURVE DATA

No.	Δ	B	L	T
C2	67°56'55"	21.340m	25.339m	14.377m
C3	22°56'37"	152.400m	61.027m	30.928m

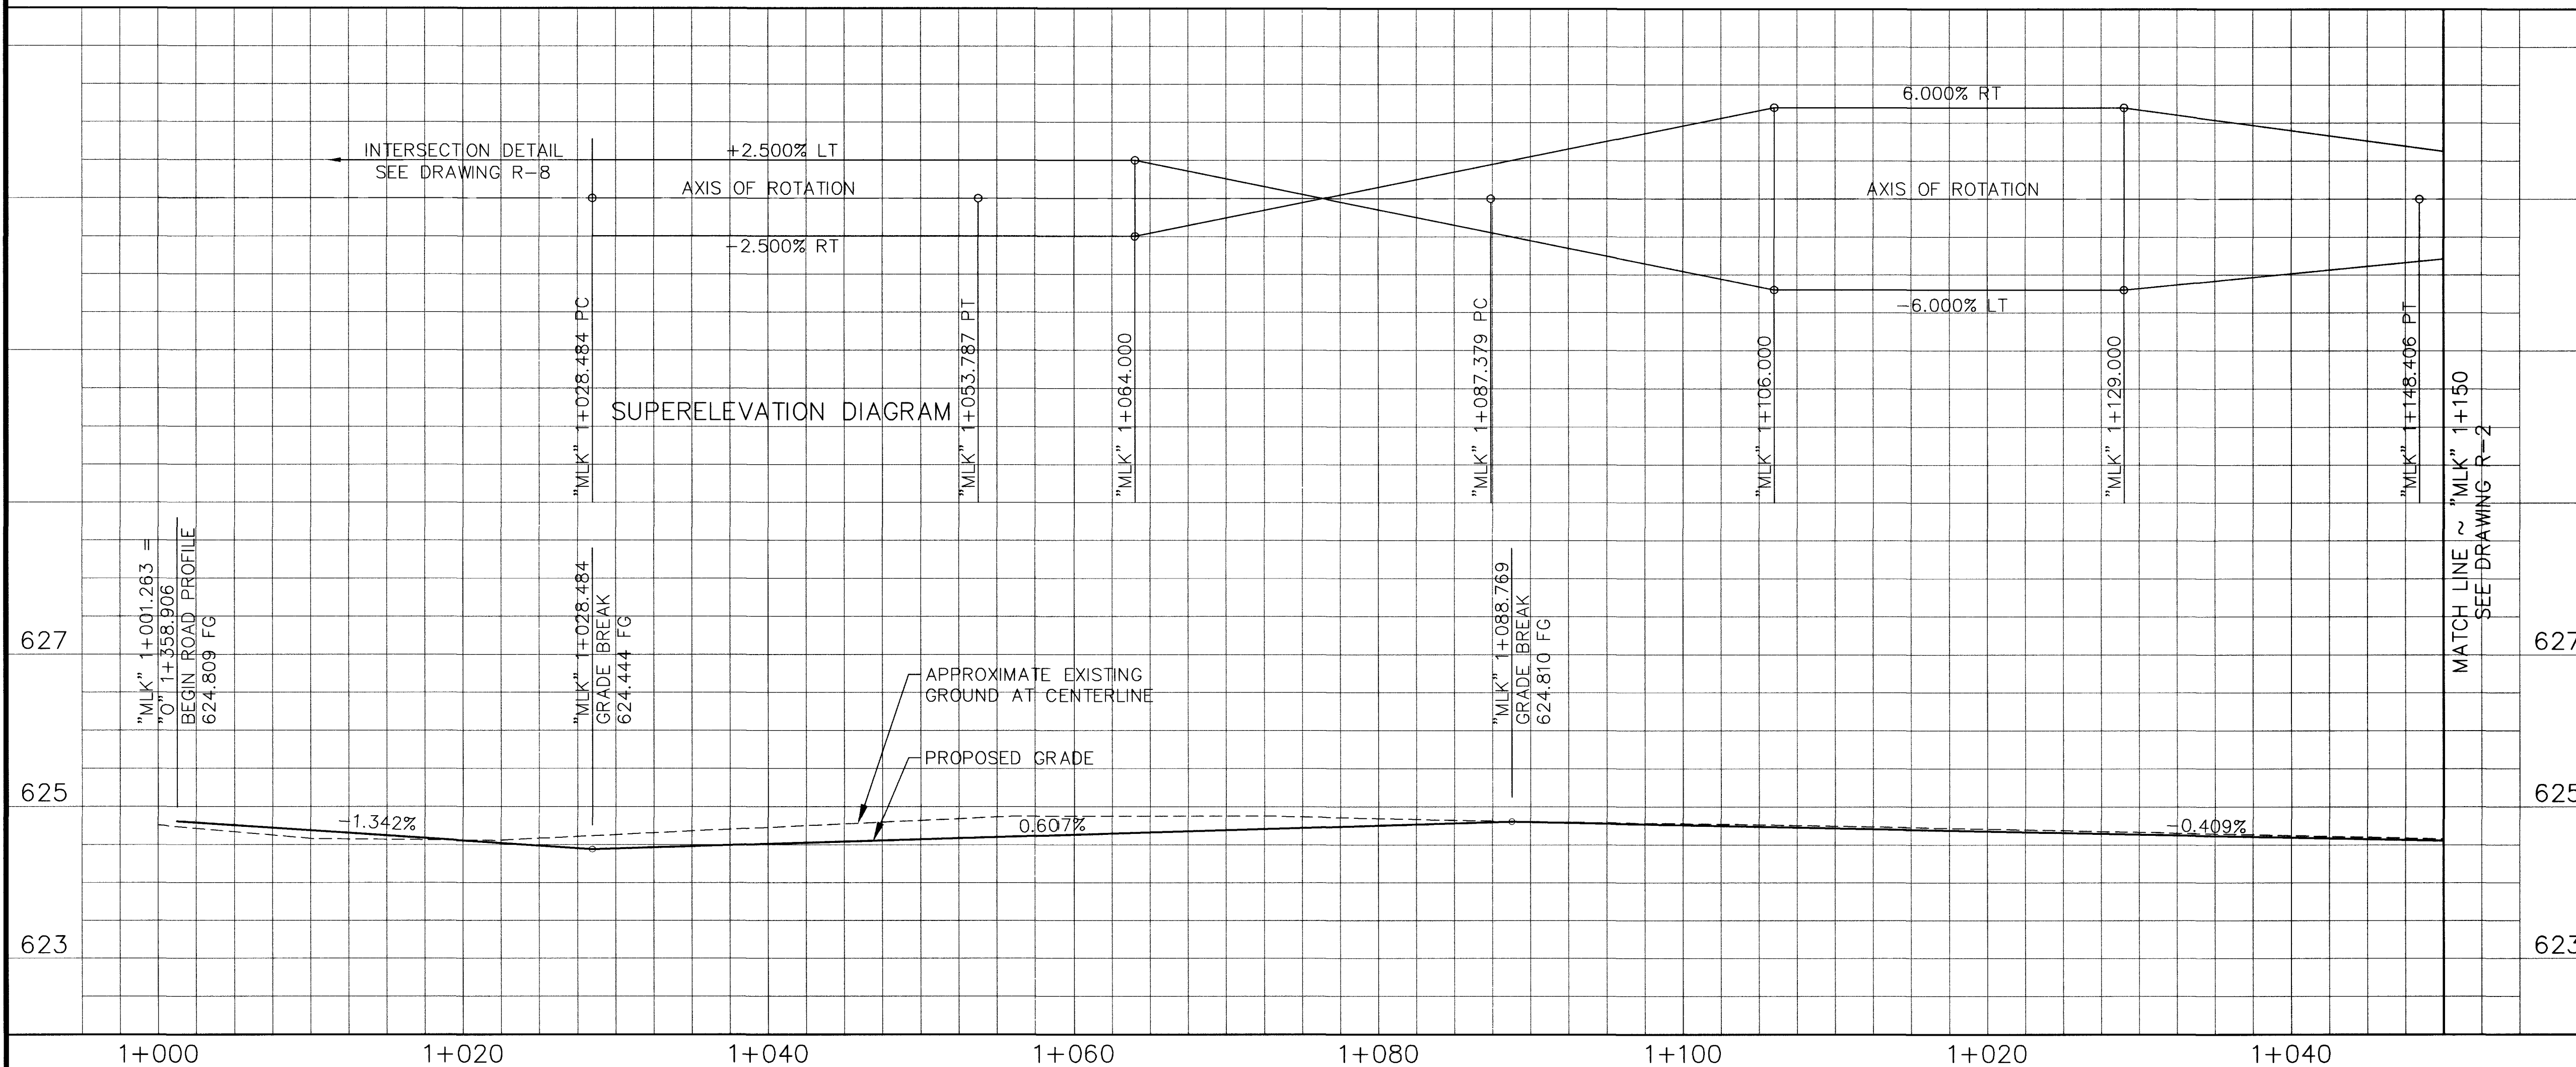

Call before you Dig.
1-800-277-2600
UNDERGROUND SERVICE (USA)

Call before you Overhead
563-6111
OVERHEAD SERVICE (USA)

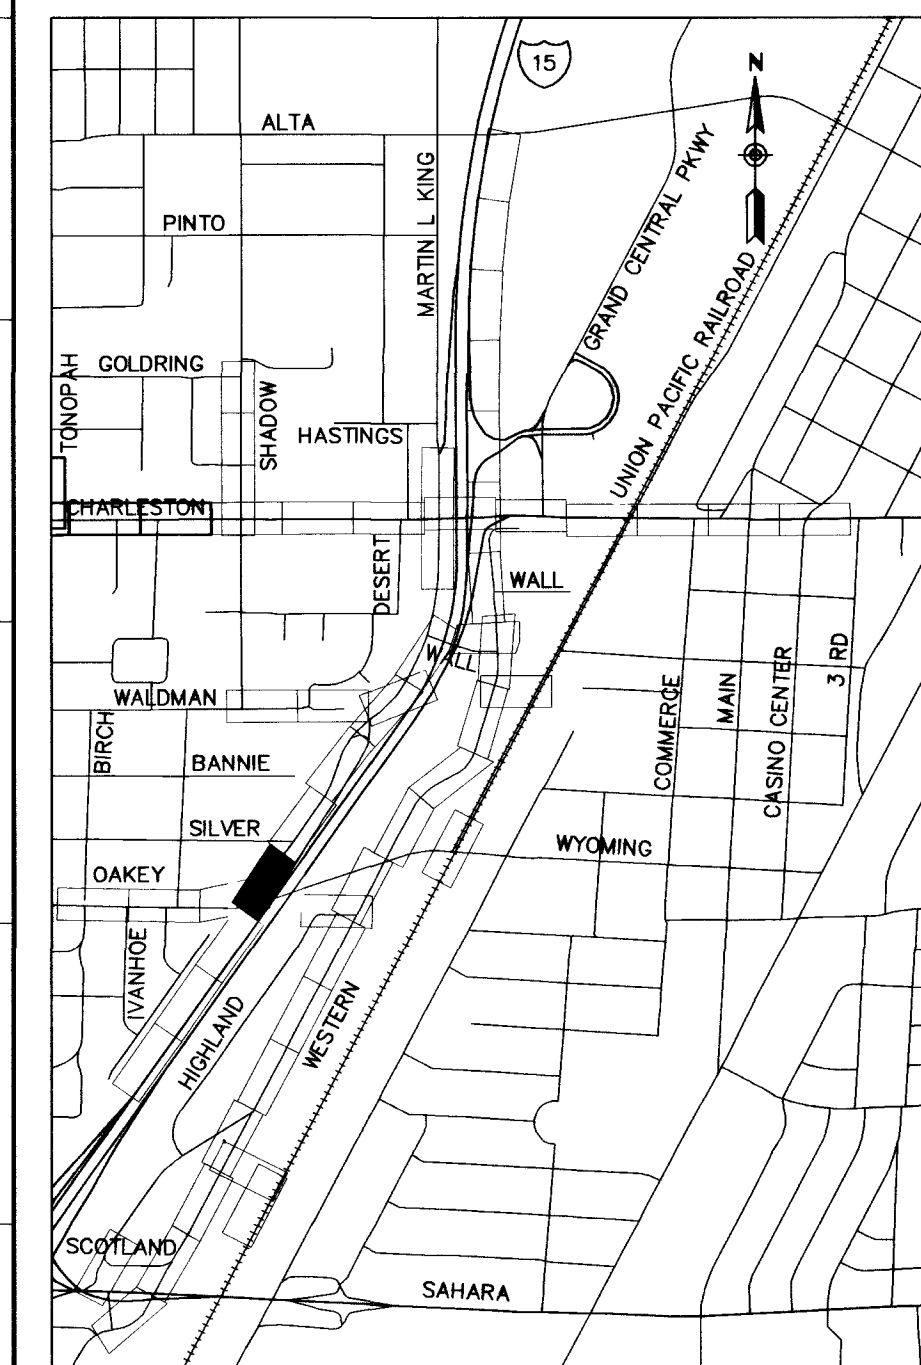

DATE: 9/30/00
REVISIONS: 4/30/03

ADDITIONAL 2
RECORD DRAWING

PROJECT # 31604
DESIGN BY KFN

SCALE (H) 1:250
SCALE (V) 1:50
DATE DEC 17, 1999

FLD. BK. # N/A

PARSONS BRINCKERHOFF
Los Vegas, Nevada

DEPARTMENT OF PUBLIC WORKS
I-15 FREEWAY CHANNEL
CONSTRUCTION PLAN AND PROFILE
"MLK" 1+001.263 TO "MLK" 1+150

ENGINEER STATE OF NEVADA
JOHN CLARK
PROFESSOR

DRAWING No. 97

R-1

241