


- CONSTRUCTION ITEMS**
- ① "WL" 0+490.000 TO 0+640.000 PRECAST RCB CONSTRUCT 2.4m x 1.2m PRECAST RCB
 - ② "WL" 0+541.635, 4.545m LT TYPE "D" MOD SEE DRAWING S-7 CONSTRUCT 3.0m DI
 - ③ "WL" 0+541.635, 4.545m LT TO 0+541.633, 1.200m LT CONSTRUCT 450mm PVC
 - ④ "WL" 0+601.748, 0.600m LT CONSTRUCT RCB ACCESS MH SEE DRAWING S-20

DATE	REVISIONS	PROJECT #	DESIGN BY
3/30/00		31604	BPP
4/30/03	ADENDUM 2		
	RECORD DRAWING		

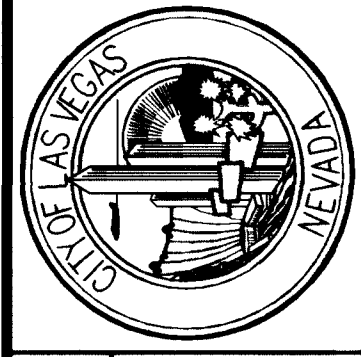


DEPARTMENT OF PUBLIC WORKS
I-15 FREEWAY CHANNEL
CONSTRUCTION PLAN AND PROFILE
"WL" 0+490 TO "WL" 0+640

SEE DRAWING R-18 FOR ROADWAY

SEE DRAWING U-11 FOR SANITARY SEWER

APPROVED FOR CONSTRUCTION

LAS VEGAS VALLEY WATER DISTRICT DATE

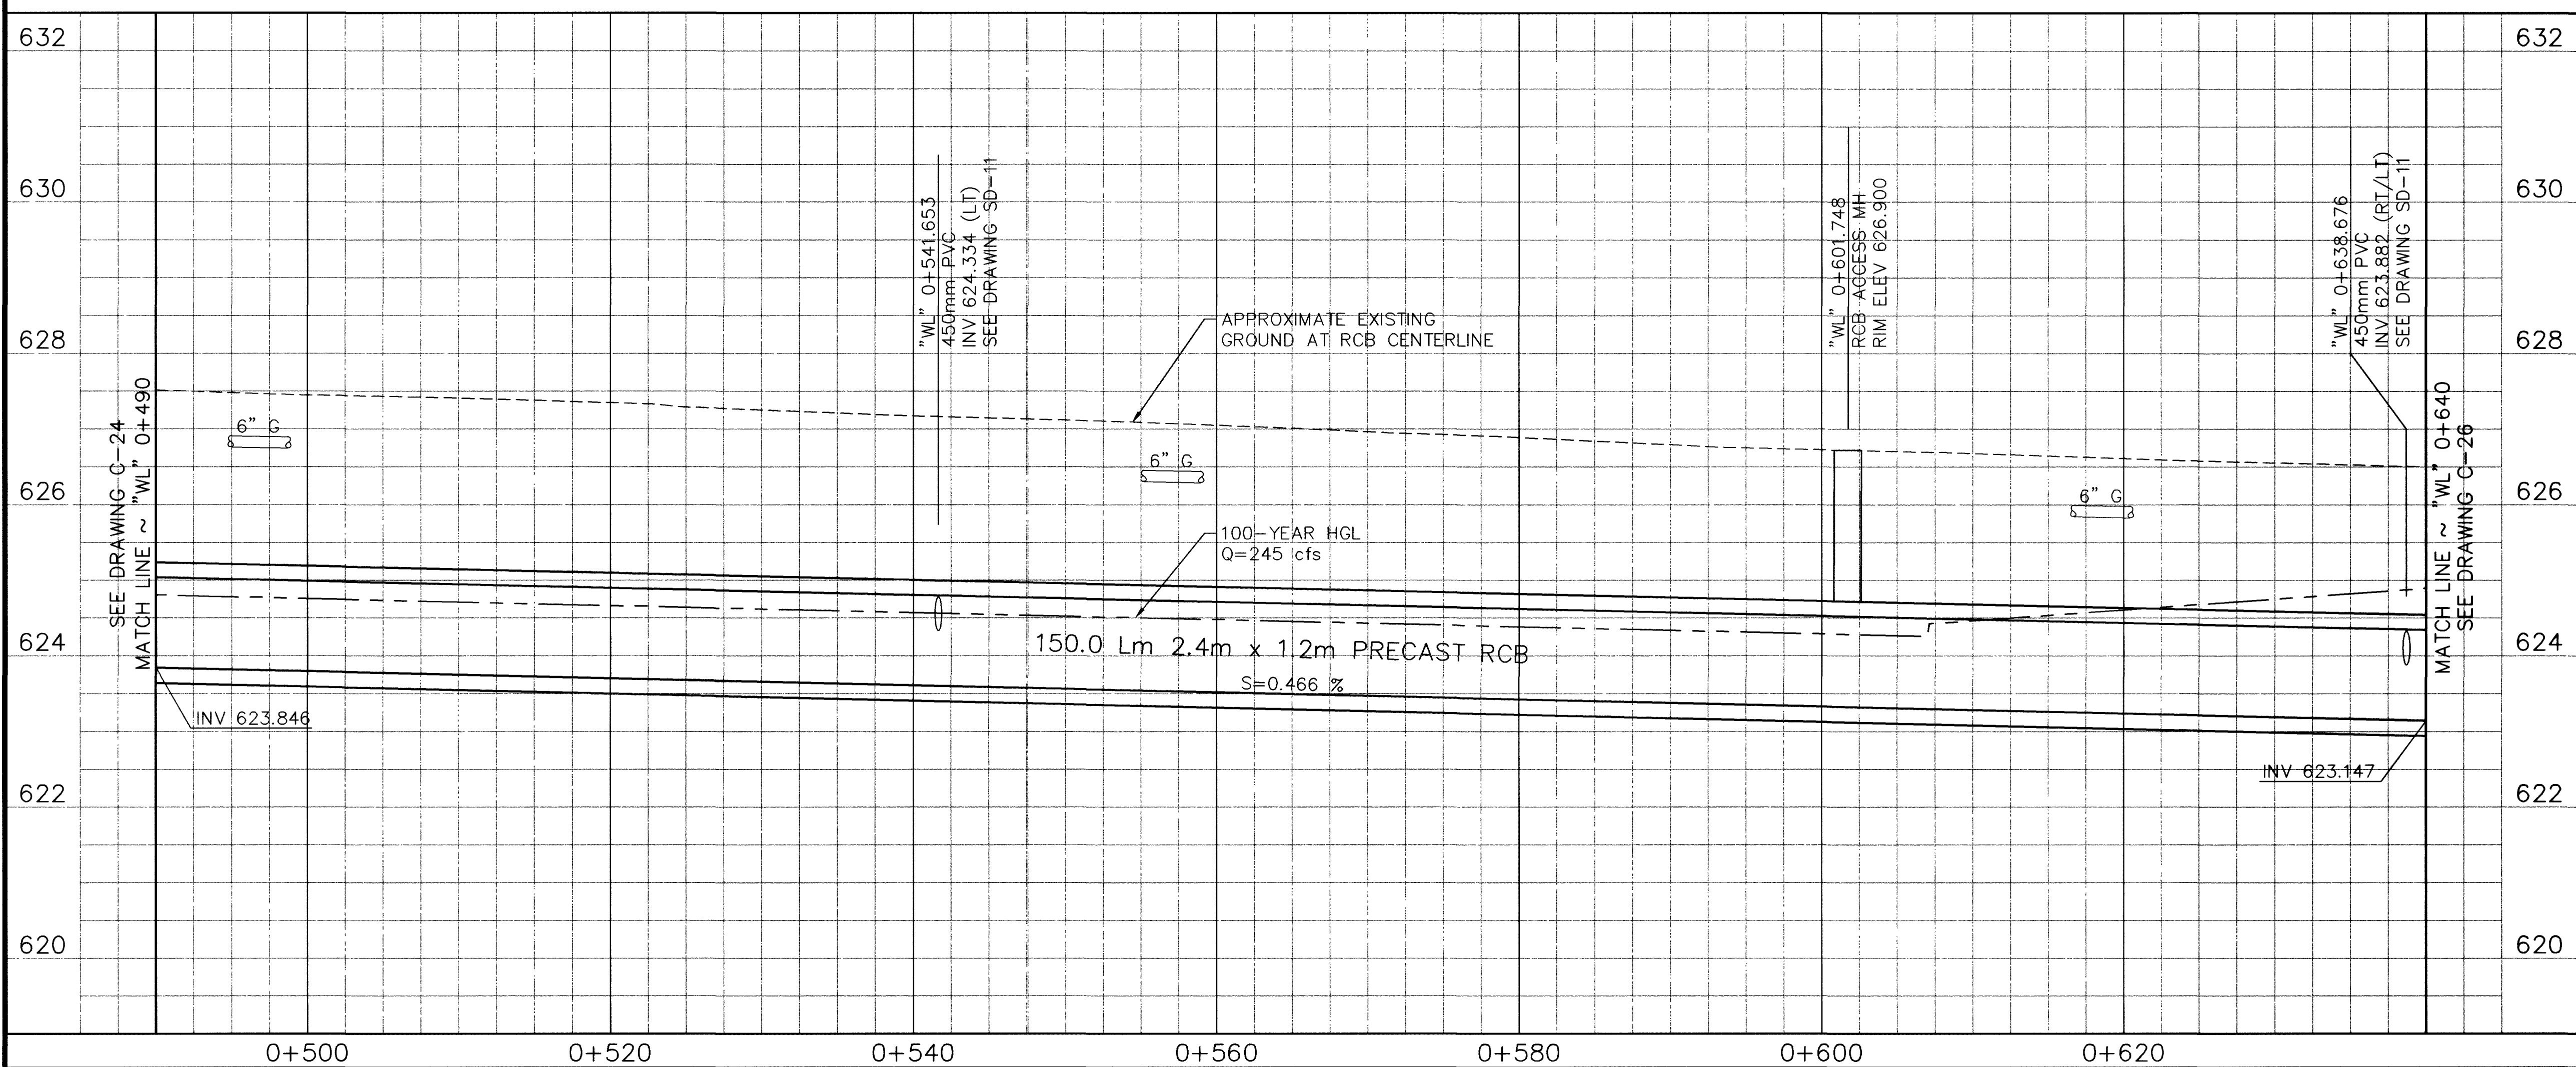

Call before you Dig.
1-800-277-2600
UNDERGROUND SERVICE (USA)

Call before you Overhead
563-8111
OVERHEAD SERVICE (USA)

