


SEE DRAWING G-1  
FOR CONSTRUCTION  
SHEET LAYOUT

SEE DRAWING G-3  
FOR UTILITY SHEET  
LAYOUT

ROADWAY SHEET LAYOUT

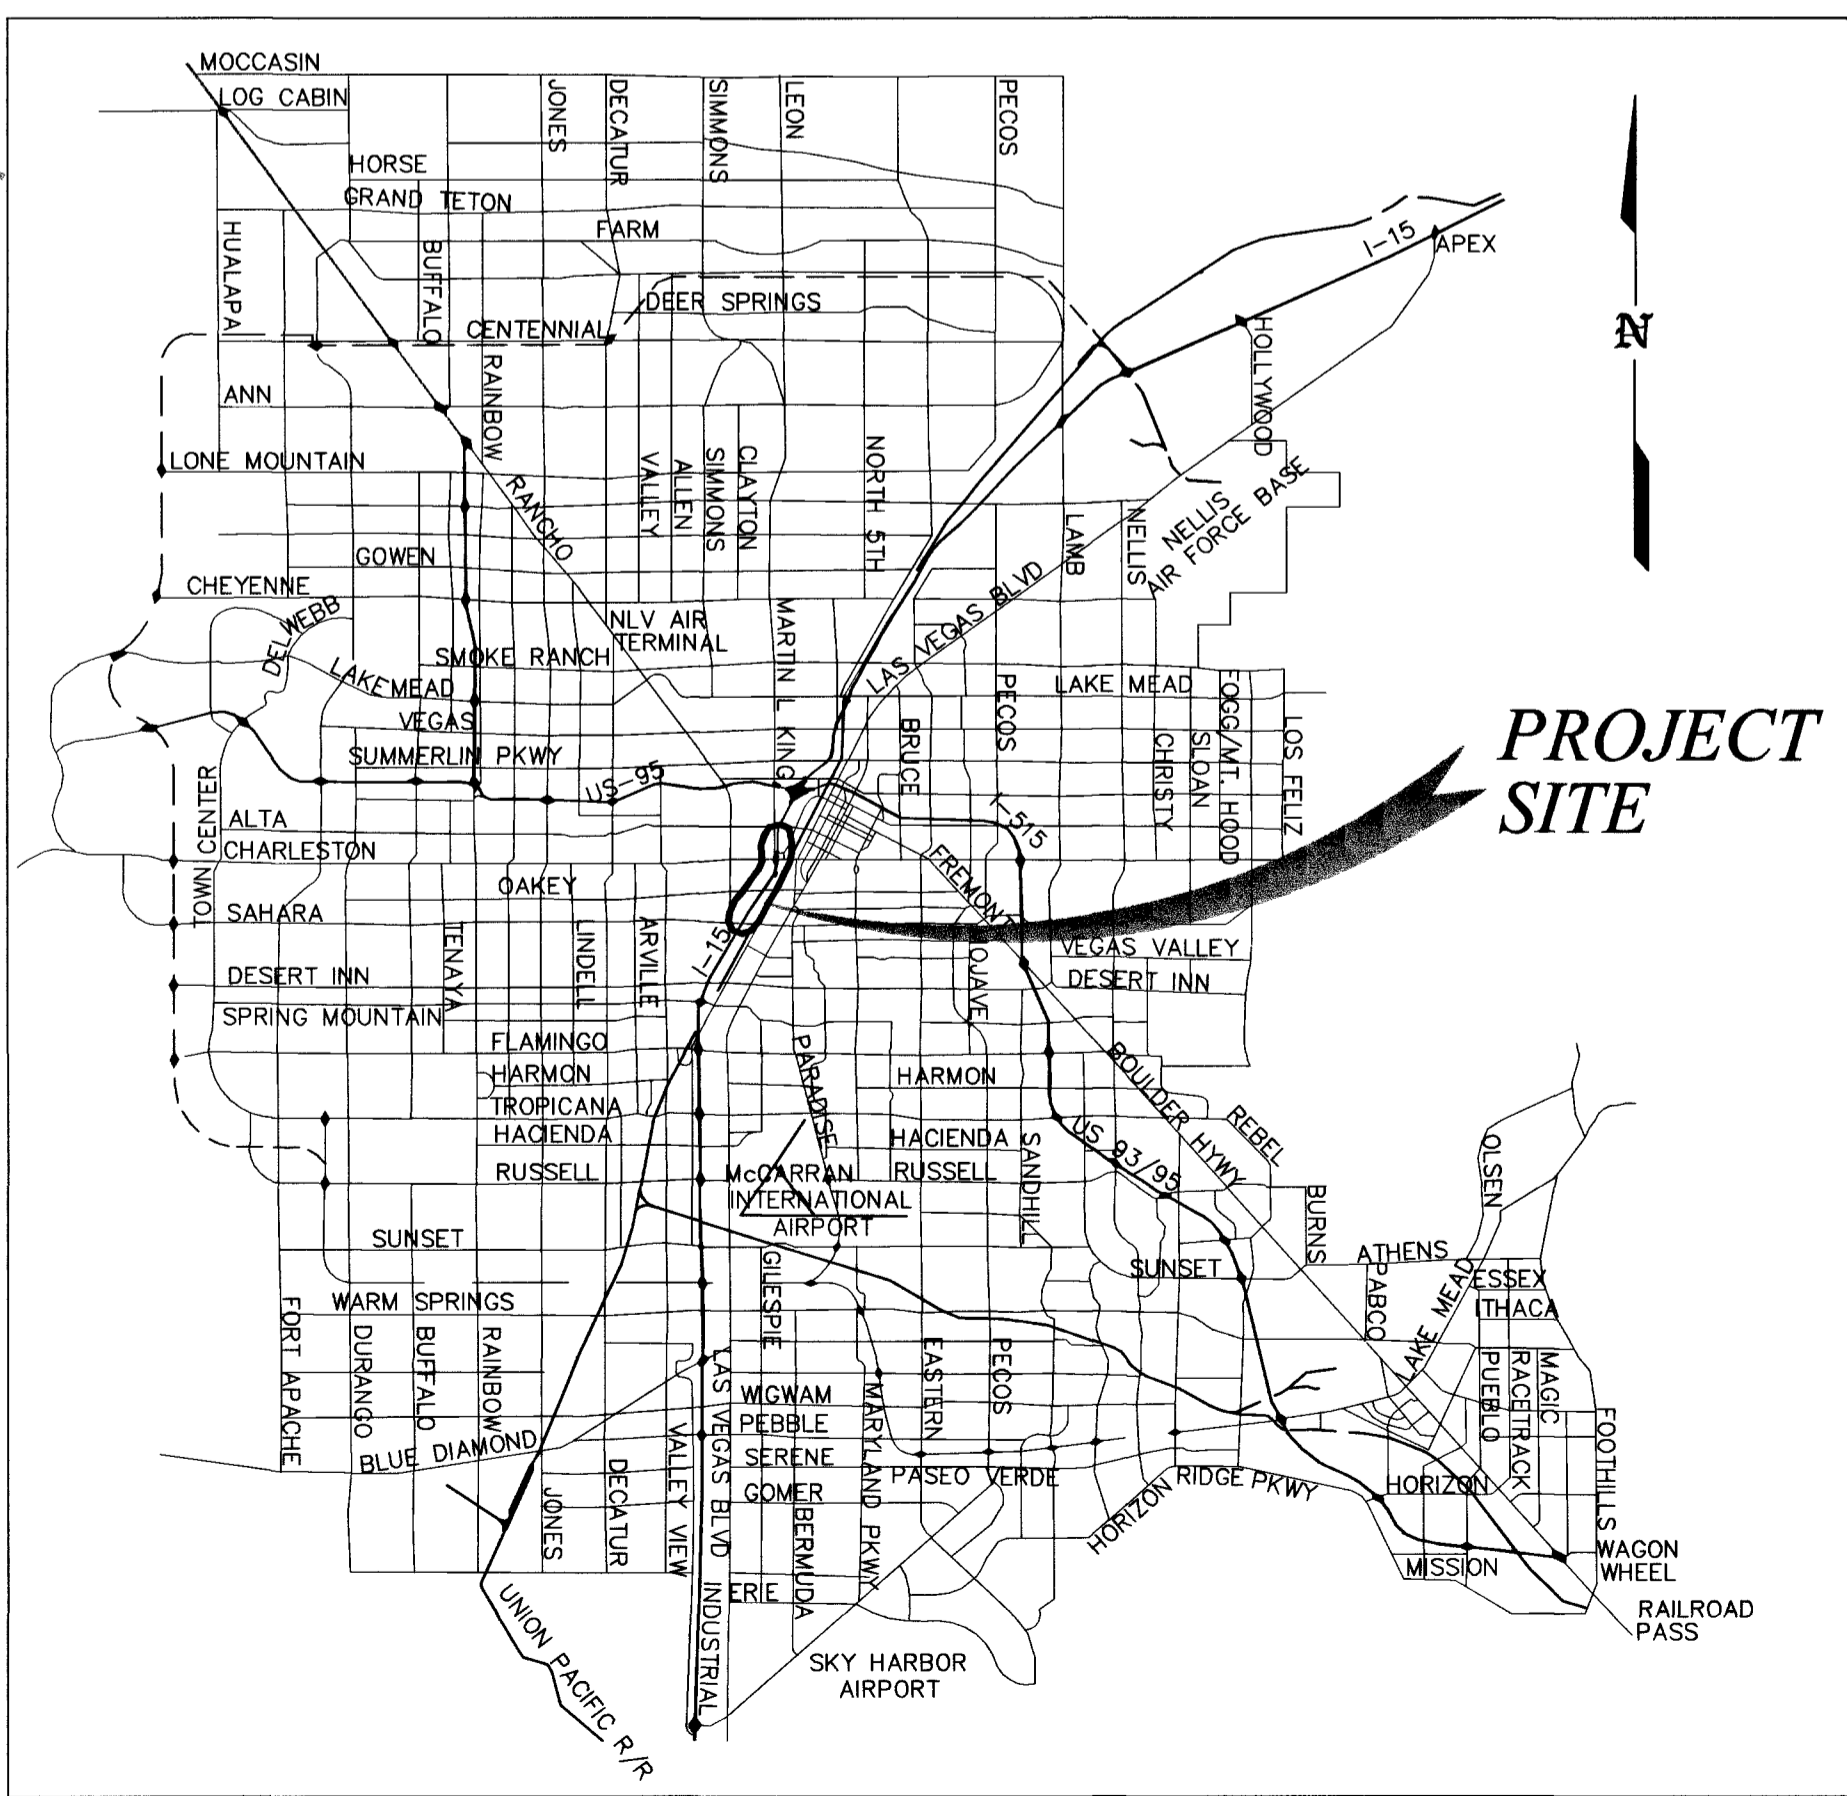

52454

RECORD DRAWING METRIC

DATE 4/20/03	
REVISIONS RECORD DRAWING	
PROJECT # 31604	SCALE (V) N/A
DESIGN BY ---	DATE DEC 17, 1999
 <b>PARSONS BRINCKERHOFF</b> Las Vegas, Nevada	
 <b>CITY OF LAS VEGAS</b> NEVADA	
<b>DEPARTMENT OF PUBLIC WORKS</b> <b>I-15 FREEWAY CHANNEL</b> <b>ROADWAY SHEET LAYOUT</b>	
 <b>JOHN P. CLARK</b> CIVIL ENGINEER	
DRAWING No. 3	241