


SEE DRAWING G-1  
FOR CONSTRUCTION  
SHEET LAYOUT

SEE DRAWING G-2  
FOR ROADWAY SHEET  
LAYOUT

UTILITY SHEET LAYOUT

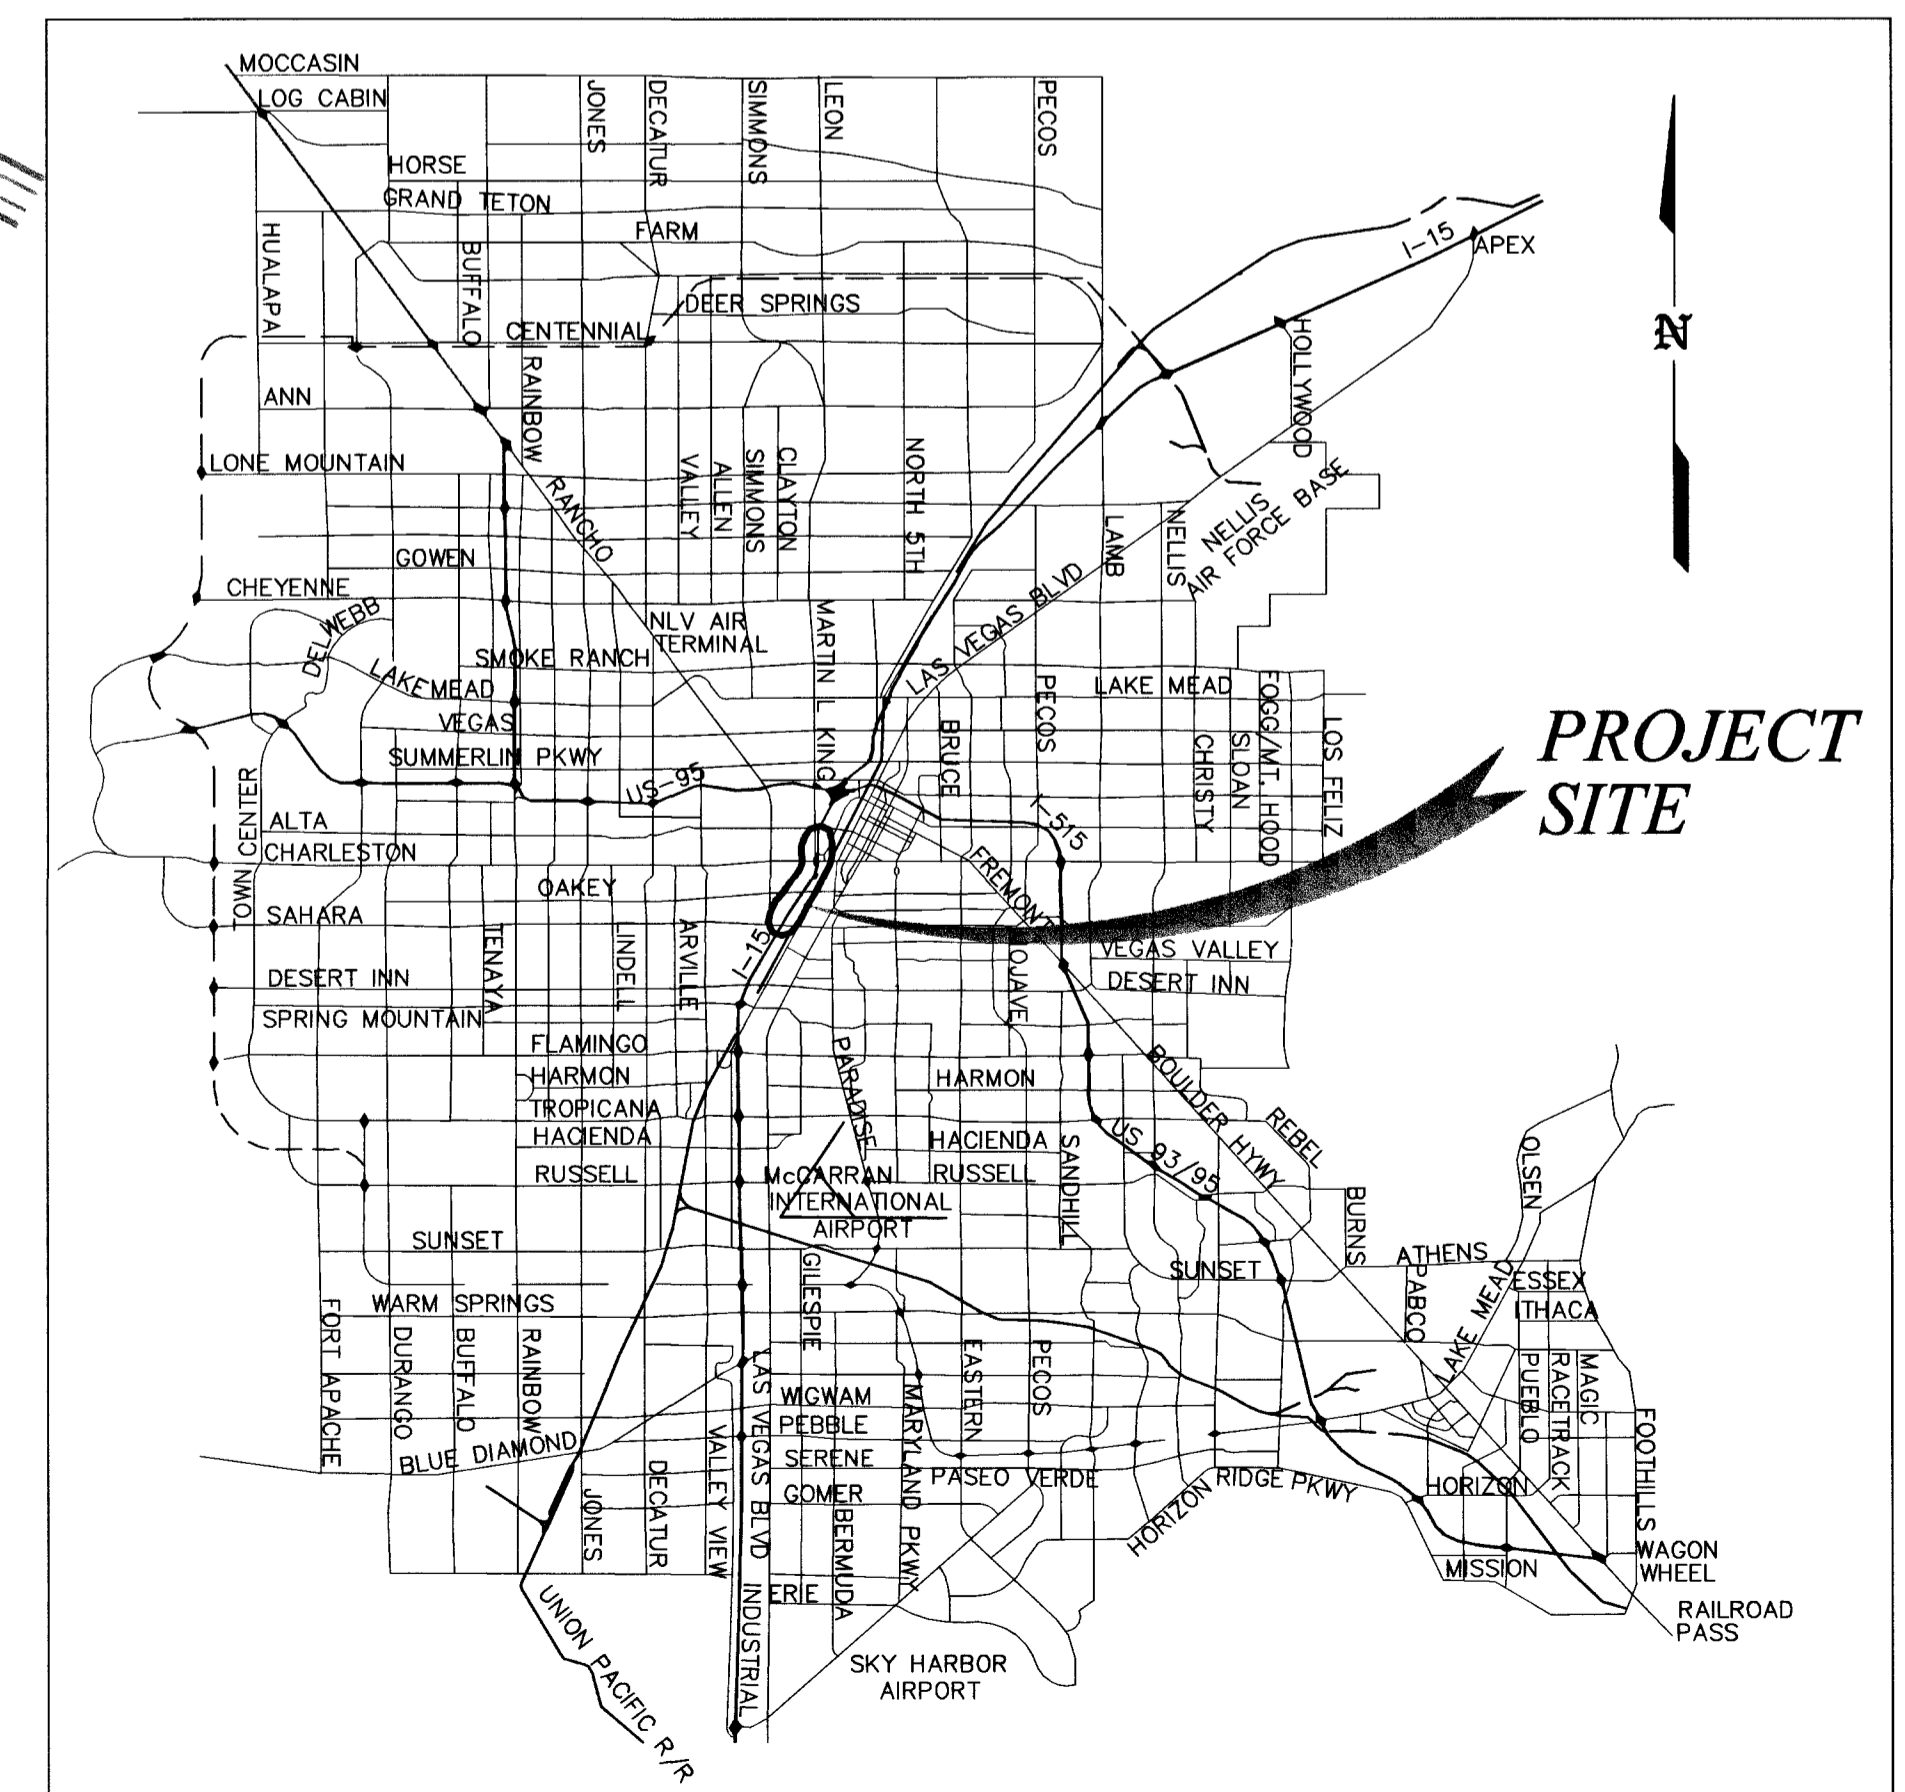


PROJECT SITE

DATE	4/20/03
REVISIONS	
RECORD DRAWING	
PROJECT #	31604
SCALE (V)	N/A
SCALE (H)	N/A
DATE	DEC 17, 1999
DESIGN BY	---
F.L.D. BK. #	N/A



DEPARTMENT OF PUBLIC WORKS

I-15 FREEWAY CHANNEL  
UTILITY SHEET LAYOUT

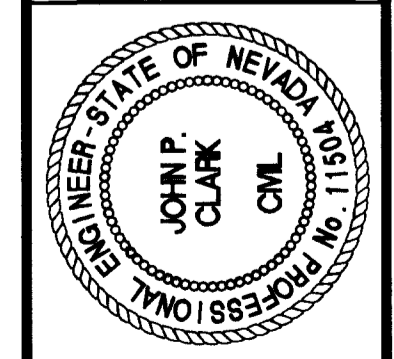

DRAWING No. 4  
G-3 241

52455

RECORD DRAWING METRIC