


- REMOVAL ITEMS**
- [F] REMOVE AC PAVEMENT
  - [M] REMOVE ASPHALT CURB
  - [R] REMOVE DRIVEWAY
  - [H] REMOVE SIDEWALK
  - [G] REMOVE CURB AND GUTTER
  - [V] REMOVE CROSS GUTTER
- CONSTRUCTION ITEMS**
- ① "O" 1+110.000, 10.350m LT TO 1+120.570, 10.350m LT TO 1+126.940, 10.350m LT TO 1+131.220, 10.350m LT TO 1+140.770, 10.350m LT TO 1+157.190, 10.350m LT TO 1+166.170, 10.350m LT TO 1+207.670, 16.060m LT TO 1+219.830, 15.870m LT TO 1+260.000, 10.350m LT TO 1+112.650, 15.290m RT TO 1+118.330, 9.470m RT TO 1+177.240, 9.440m RT TO 1+182.920, 15.300m RT TO 1+195.270, 15.300m RT TO 1+200.840, 9.580m RT
  - ② "O" 1+120.570, 10.350m LT TO 1+126.940, 10.350m LT TO 1+131.220, 10.350m LT TO 1+140.770, 10.350m LT TO 1+157.190, 10.350m LT TO 1+166.170, 10.350m LT
  - ③ "O" 1+114.330, 15.260m RT TO 1+118.360, 11.150m RT TO 1+177.270, 11.120m RT TO 1+181.250, 15.050m RT TO 1+196.950, 15.280m RT TO 1+200.860, 11.250m RT
  - ④ "O" 1+177.230, 8.990m RT TO 1+200.830, 9.130m RT TO 1+202.110, 9.890m LT TO 1+225.560, 9.900m LT

SEE DRAWING U-4 FOR UTILITIES

SEE DRAWING C-18 FOR OAKEY LATERAL


**"O" CURVE TABLE**

No.	Δ	R	L	T
04	88°37'38"	5.816m	8.996m	5.678m
05	89°50'25"	5.665m	8.883m	5.649m
06	90°00'00"	5.646m	8.869m	5.646m
07	90°00'00"	5.646m	8.869m	5.646m
08	90°19'09"	5.608m	8.841m	5.640m

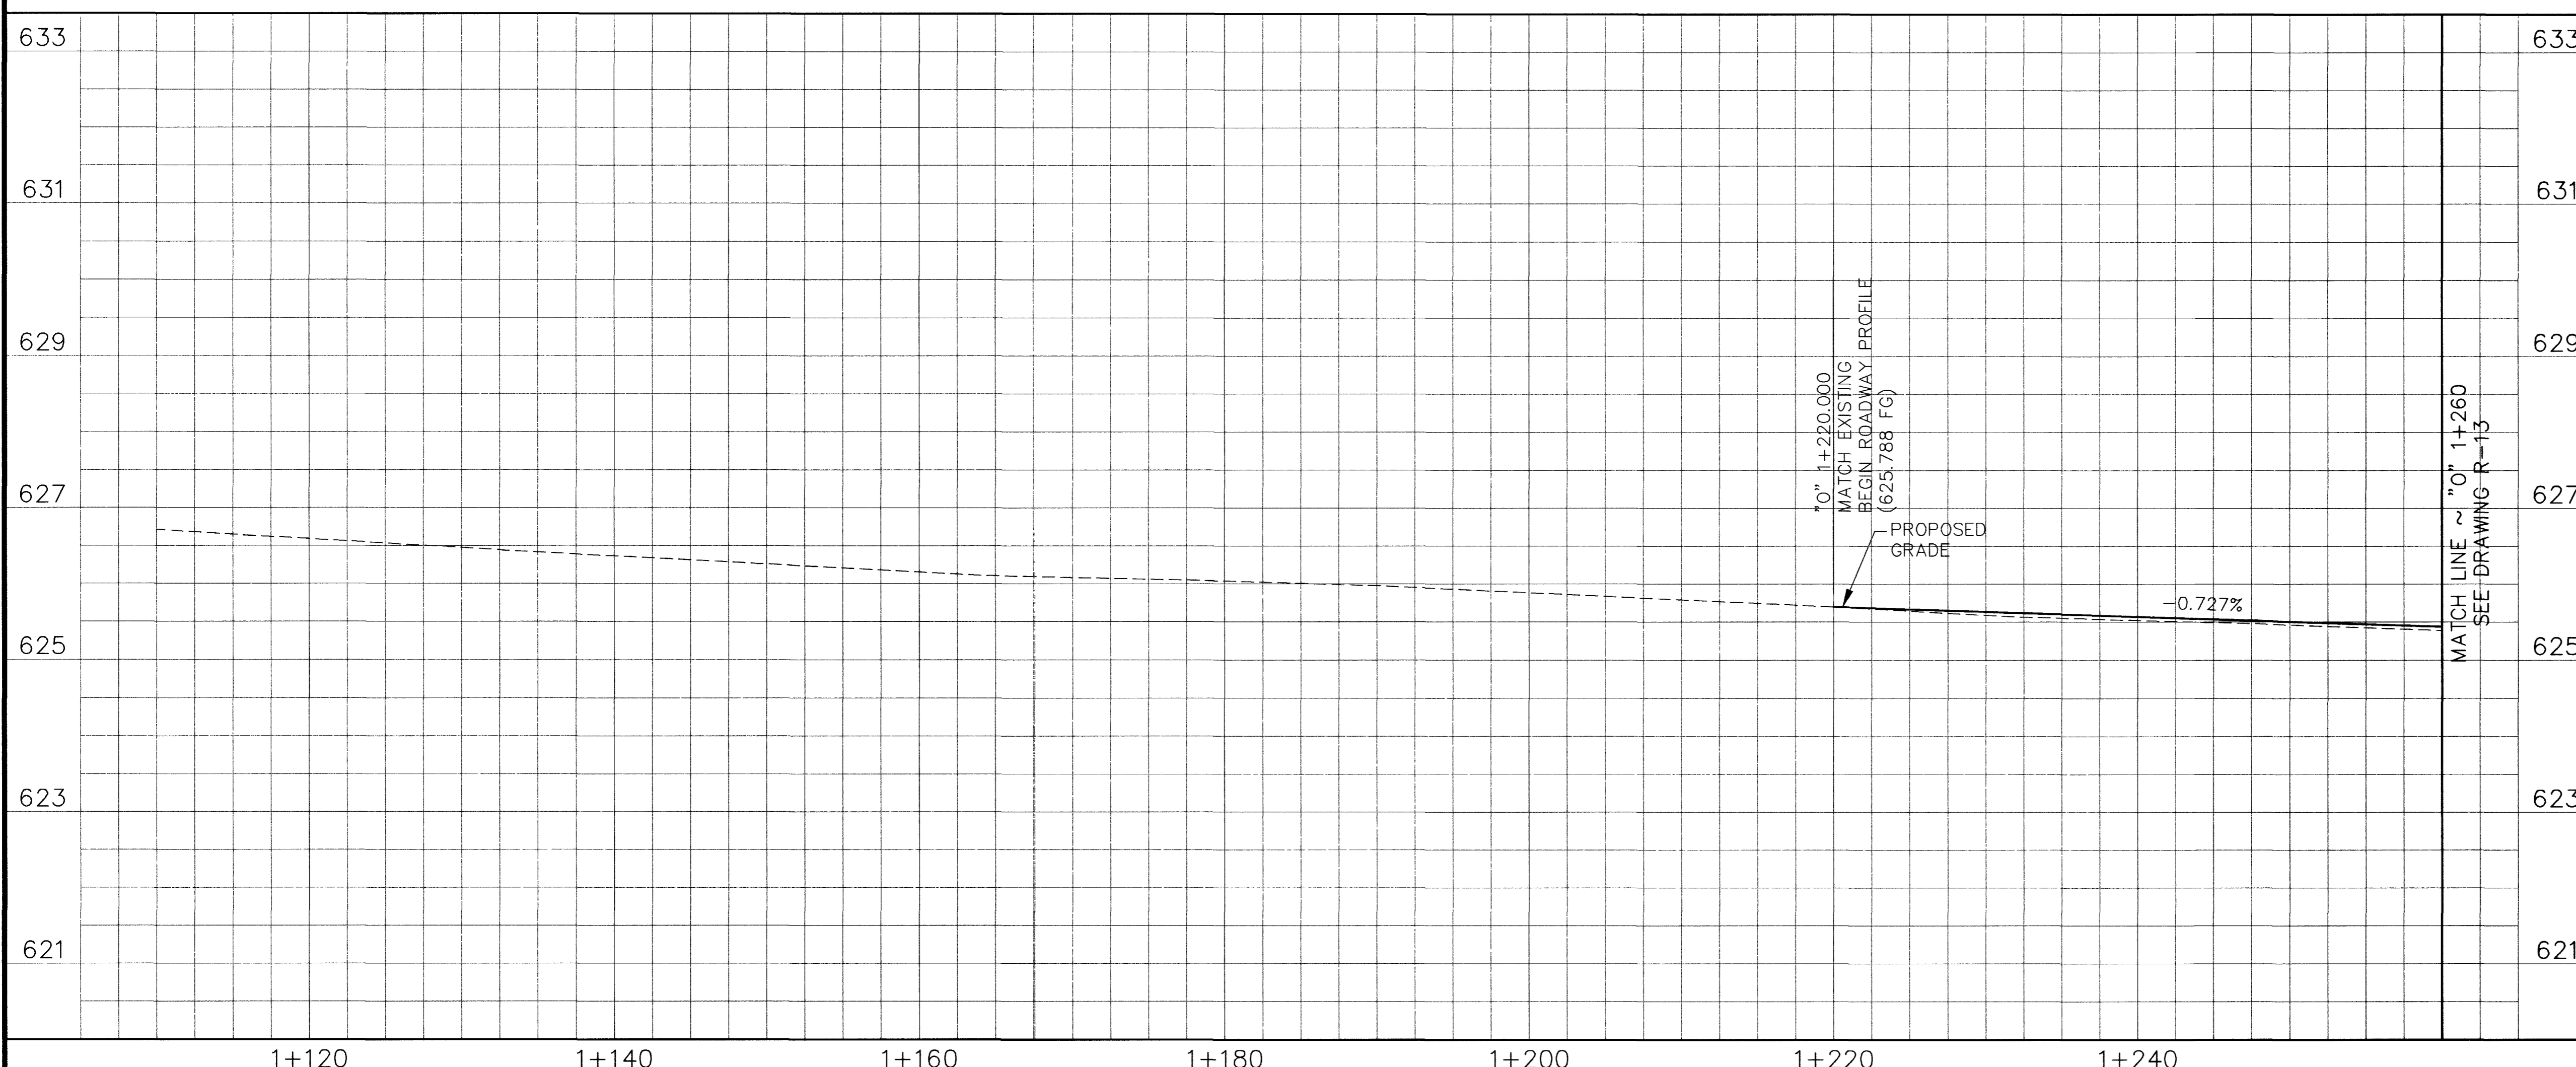

**Call before you Dig.**  
1-800-277-2600  
UNDERGROUND SERVICE (USA)

**Call before you Overhead.**  
563-6111  
OVERHEAD SERVICE (USA)

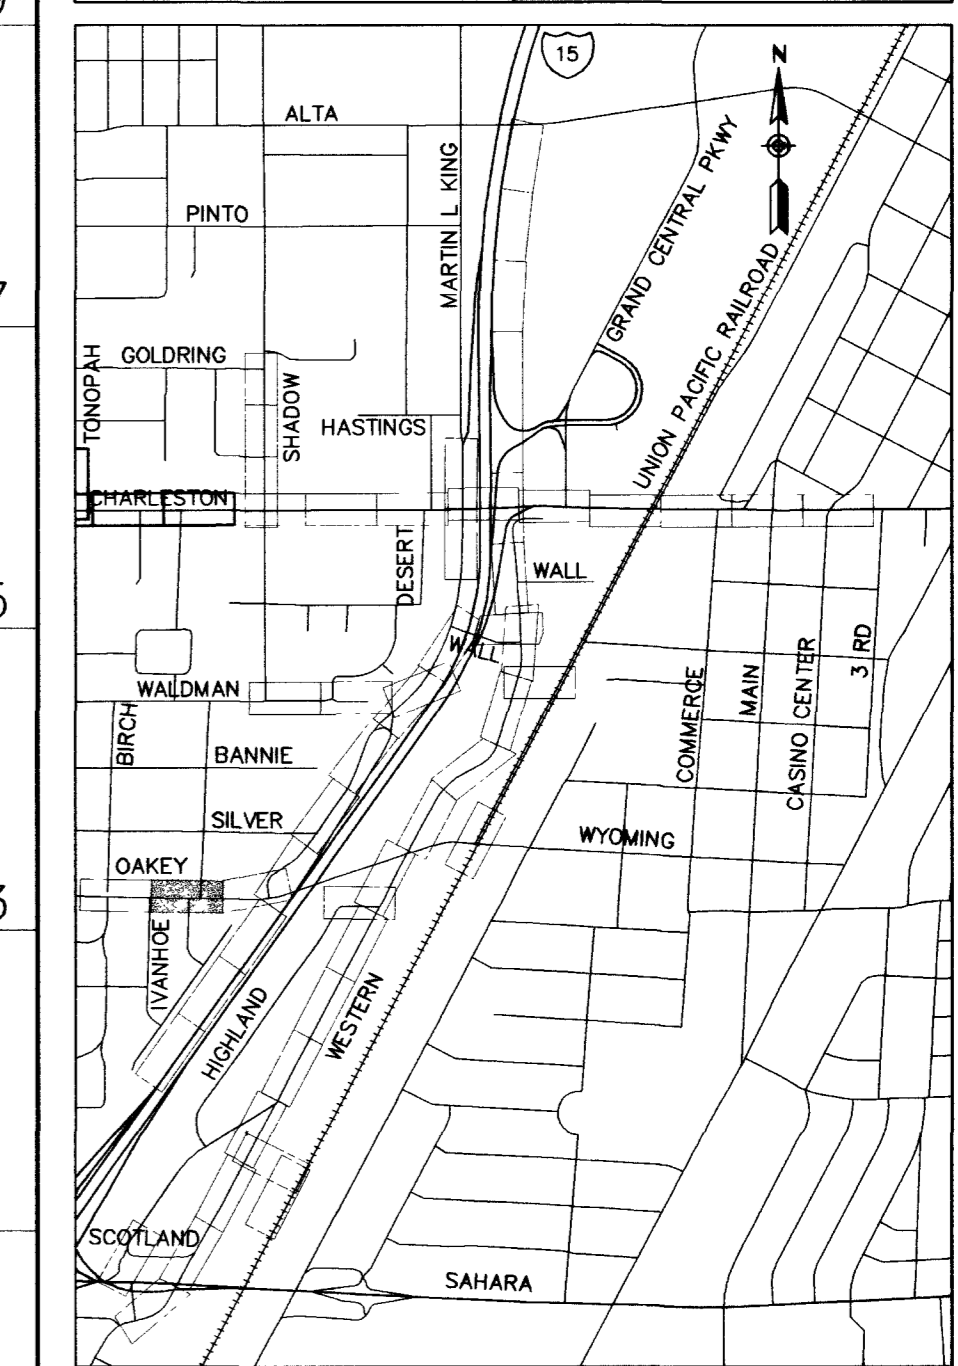

DATE: 4/26/03

REVISIONS:

PROJECT # 31604

DESIGN BY: BPP

SCALE (V): 1:50

DATE: DEC 17, 1999

SCALE (H): 1:250

F.L.D. BK. # N/A

**PARSONS BRINCKERHOFF**  
Las Vegas, Nevada

**DEPARTMENT OF PUBLIC WORKS**

**I-15 FREEWAY CHANNEL CONSTRUCTION PLAN**

**"O" 1+110 TO "O" 1+260**

DRAWING No. 108

**R-12**

241

RECORD DRAWING METRIC

JOHN CLARK  
CIVIL ENGINEER  
PROFESSIONAL NO. 11903