


REMOVAL ITEMS
 [F] REMOVE AC PAVEMENT

SEE DRAWING R-14
 MATCH LINE ~ "WD" 1+200


APN#
 162-04-601-001

APN#
 162-04-601-002

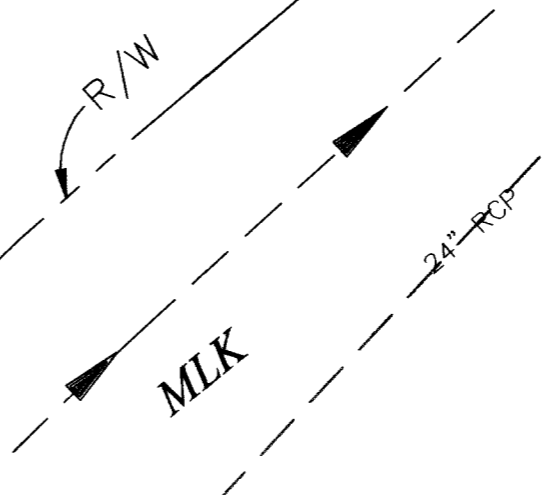

Call before you Dig.
 1-800-277-2600
UNDERGROUND SERVICE (USA)

Call before you Overhead
 563-6111
OVERHEAD SERVICE (USA)

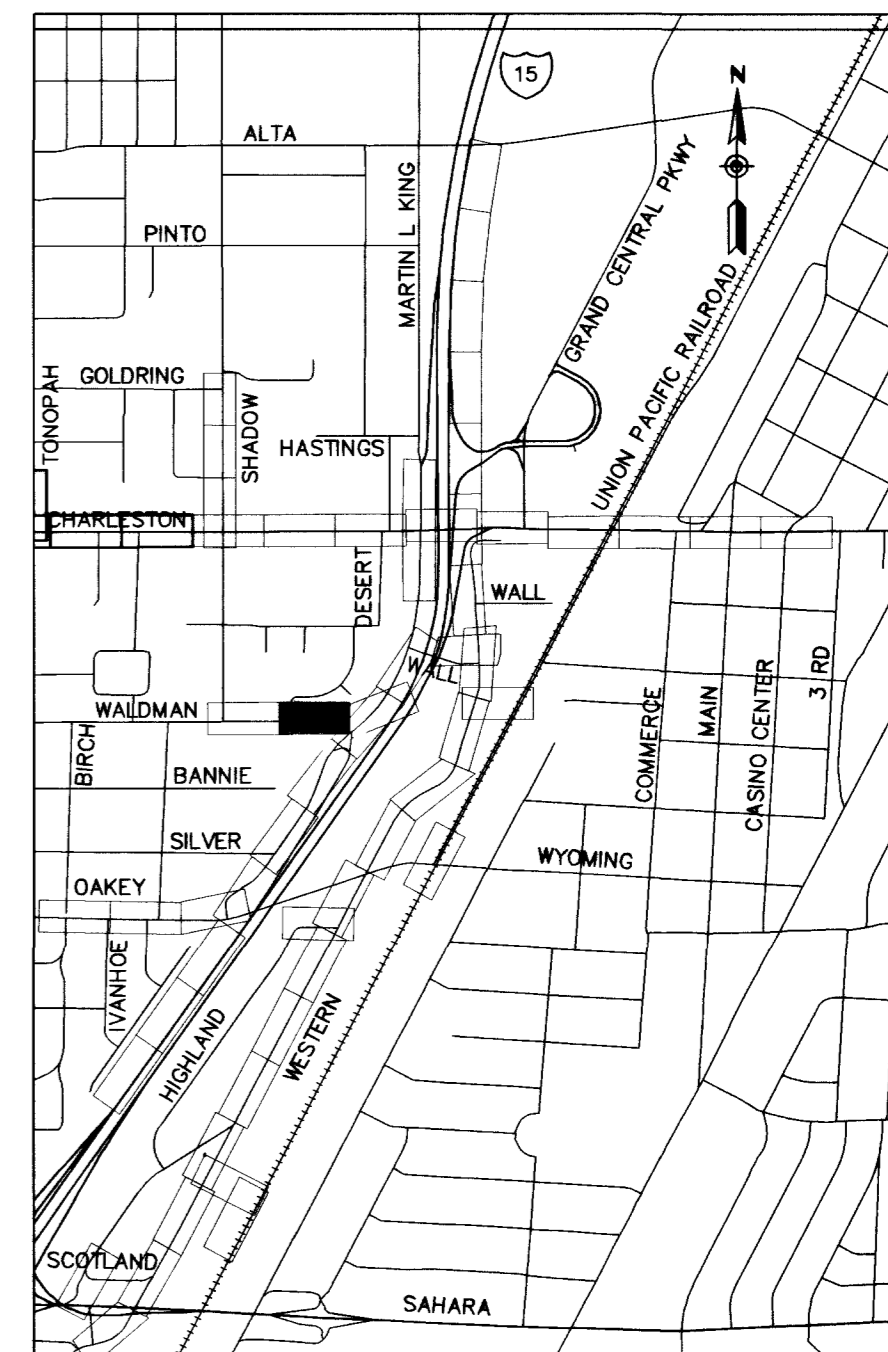


DATE	REVISIONS
4/30/03	RECORD DRAWING

SCALE (H)	SCALE (V)	PROJECT #
1:250	1:50	31604
FLD. BK. #	DATE	DESIGN BY
N/A	DEC 17, 1999	BPP



DEPARTMENT OF PUBLIC WORKS
I-15 FREEWAY CHANNEL
CONSTRUCTION PLAN
"WD" 1+200 TO "WD" 1+340

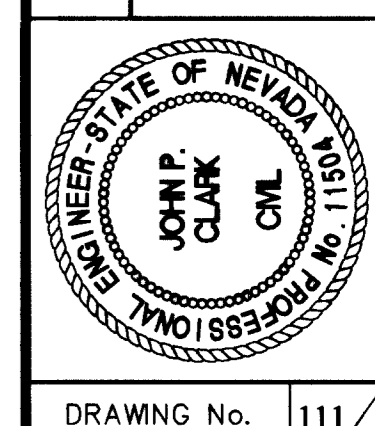

DRAWING No. 111
R-15
 241

RECORD DRAWING METRIC