

REMOVAL ITEMS
 [F] REMOVE AC PAVEMENT

SEE DRAWING C-31
 FOR DRAINAGE PLAN


SEE DRAWINGS U-17
 AND U-18 FOR
 SANITARY SEWER

LEGEND

[Hatched Box] AC PAVEMENT REMOVAL/
 [Solid Box] NEW AC PAVEMENT

Call before you Dig.
 1-800-277-2600
 UNDERGROUND SERVICE (USA)

Call before you Overhead
 563-6111
 OVERHEAD SERVICE (USA)

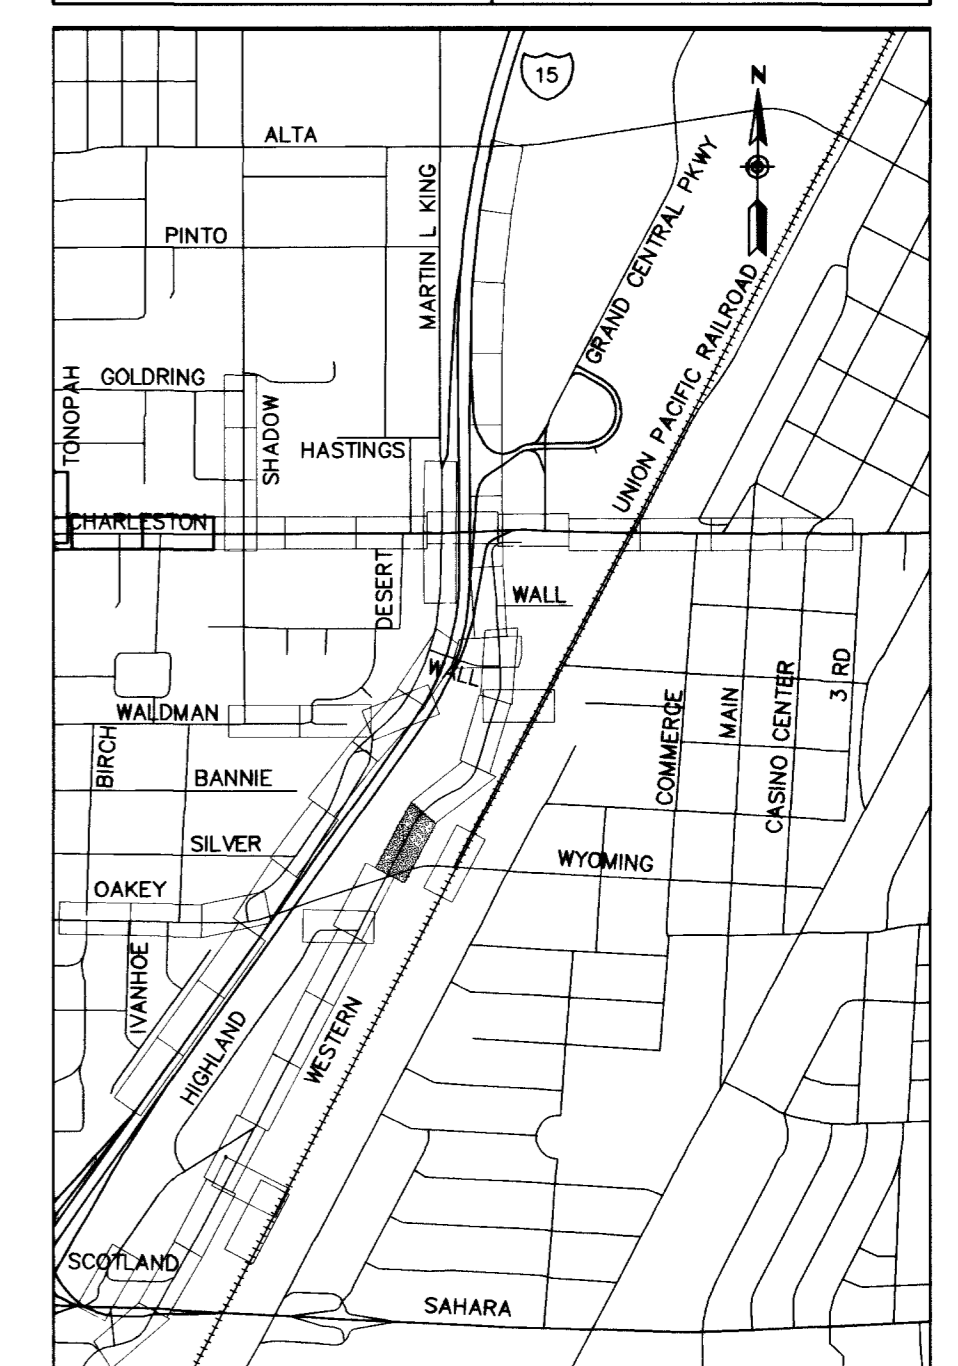


REVISIONS	DATE
REVISE DURING CONSTRUCTION	10/26/01
RECORD DRAWING	4/30/03


PROJECT # 31604
 DESIGN BY BPP
 DATE DEC 17, 1999

SCALE (H) 1:250
 SCALE (V) 1:50

F.L.D. BK. # N/A

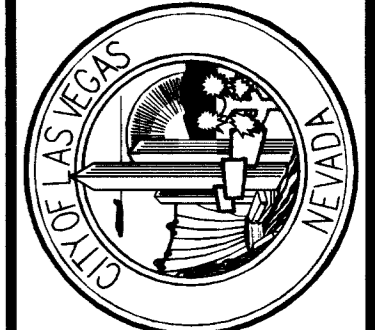

DEPARTMENT OF PUBLIC WORKS
 I-15 FREEWAY CHANNEL
 CONSTRUCTION PLAN
 "W" 1+390 TO "W" 1+540

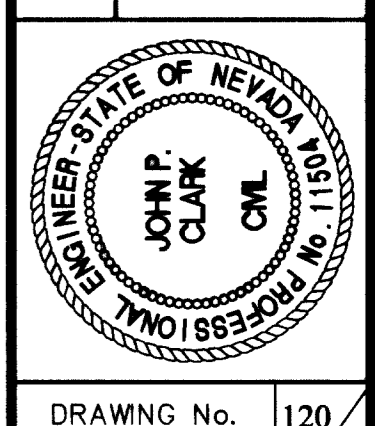

DRAWING No. R-24
 120
 241