



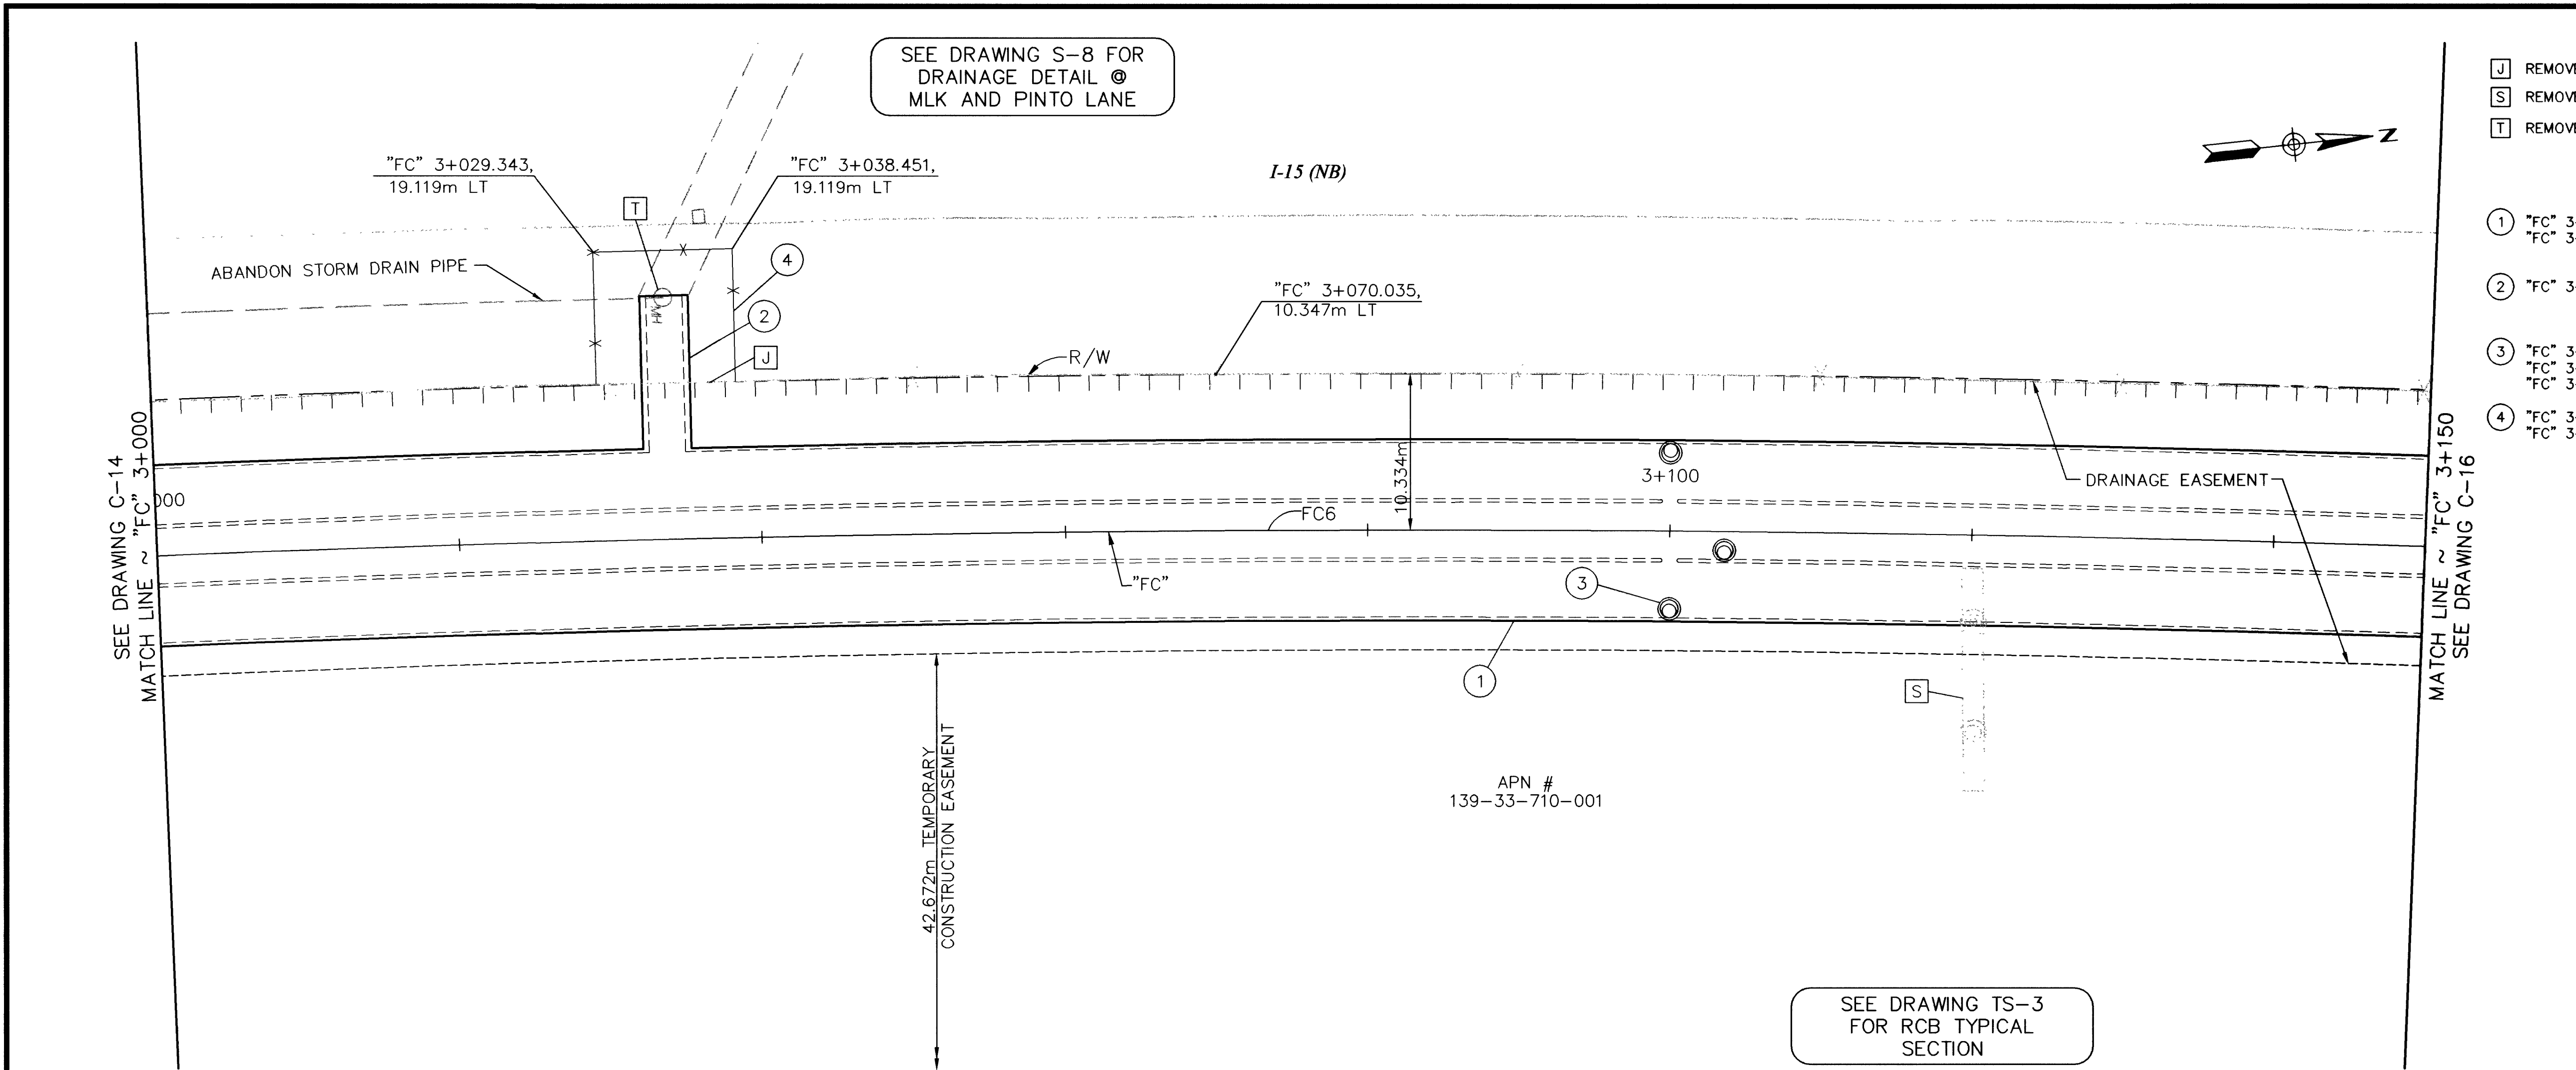

- REMOVAL ITEMS**
- 1 REMOVE AND RESTORE CHAIN LINK FENCE
 - 2 REMOVE BILLBOARD AND FOUNDATION
 - 3 REMOVE MH
- CONSTRUCTION ITEMS**
- 1 "FC" 3+000.000 TO "FC" 3+150.000
 - 2 "FC" 3+033.900, LT
 - 3 "FC" 3+100.000, 5.150m RT
"FC" 3+100.000, 5.150m LT
"FC" 3+103.600, 1.250m RT
 - 4 "FC" 3+029.323, 10.367m LT TO "FC" 3+038.476, 10.348m LT
- CONSTRUCTION ITEMS**
- CONSTRUCT TRIPLE 3.7m x 3.0m RCB SEE DRAWING S-2
 - CONSTRUCT CONNECTION STRUCTURE No. 2 SEE DRAWING S-6
 - CONSTRUCT RCB ACCESS MH SEE DRAWING S-19
 - CONSTRUCT TEMPORARY 1.8m CHAIN LINK FENCE

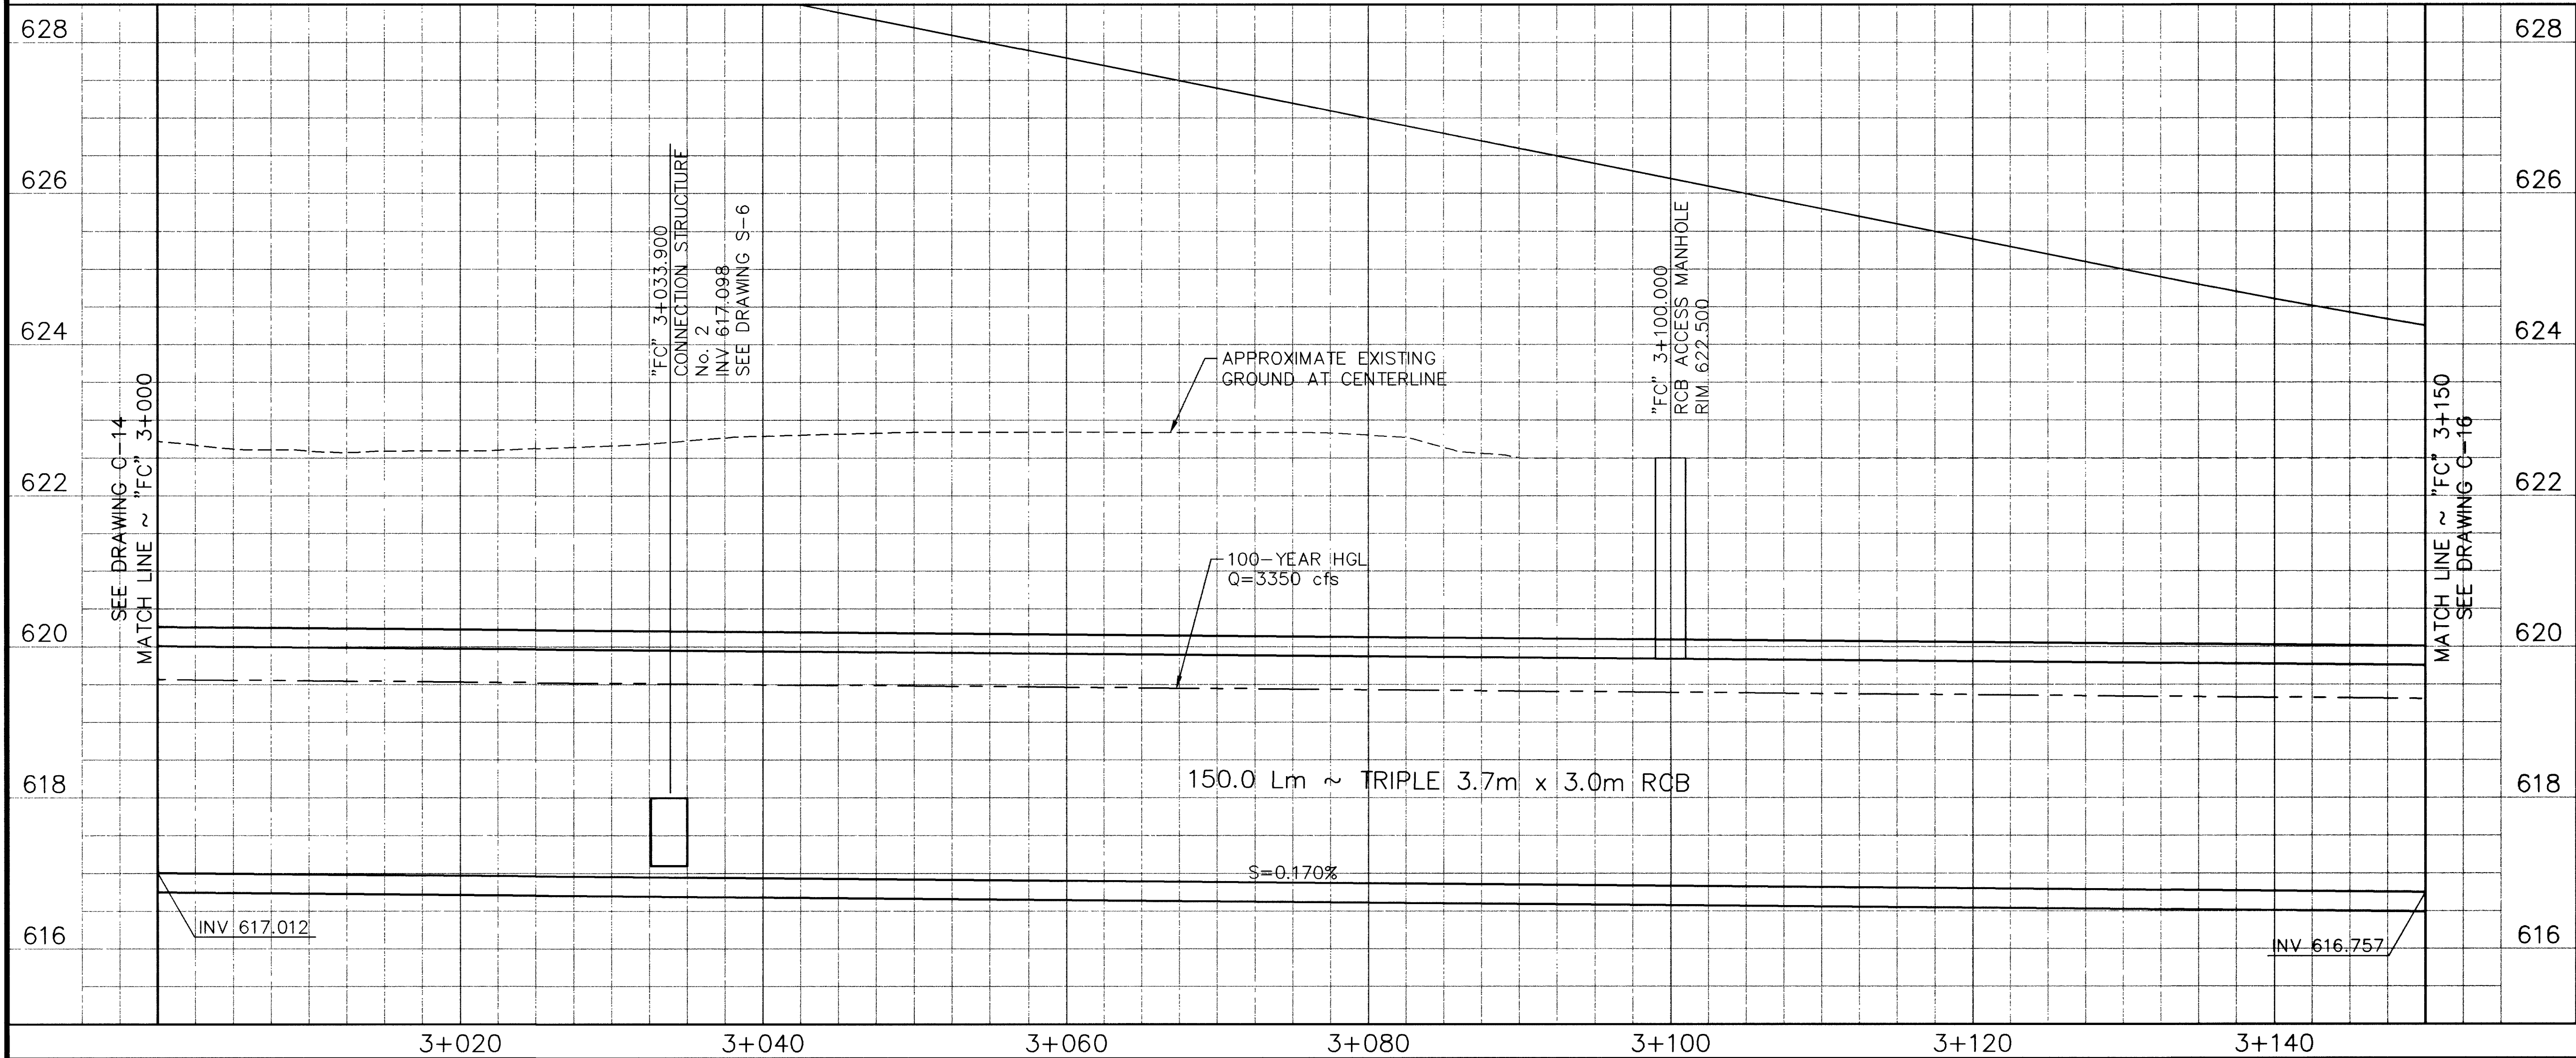

"FC" CURVE DATA

No.	Δ	R	L	T
FC6	07°48'05"	2024.000m	275.586m	138.006m

Call before you Dig.


1-800-277-2600

UNDERGROUND SERVICE (USA)

Call before you Overhead

563-6111

OVERHEAD SERVICE (USA)

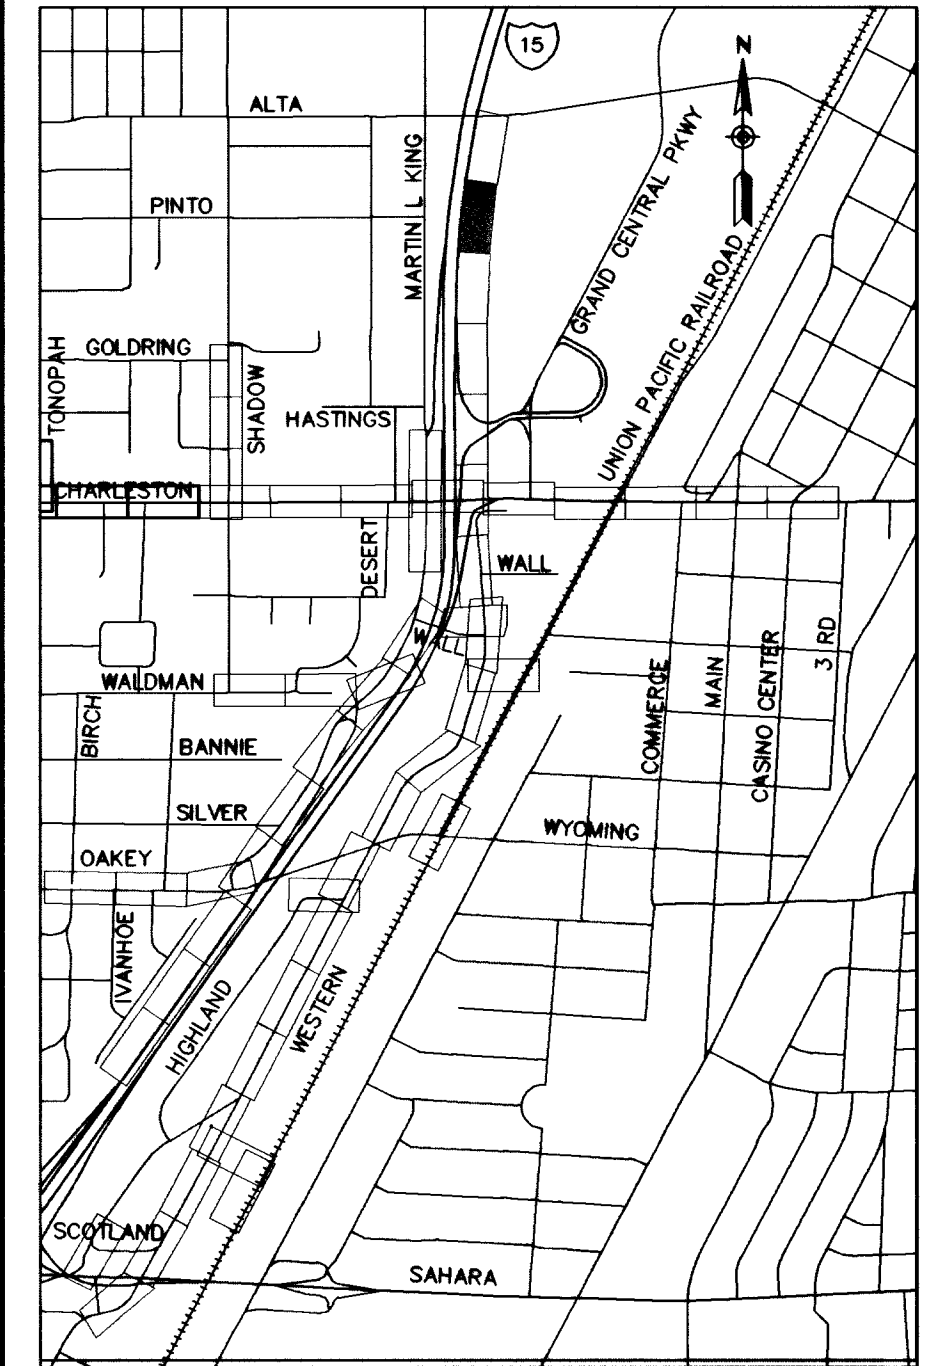

DATE	3/30/00	REVISIONS	ADDITION 2	PROJECT #	31604	DESIGN BY	BPP	PARSONS BRINCKERHOFF Las Vegas, Nevada
DATE	4/30/03	RECORD DRAWING		SCALE (V)	1:50	DATE	DEC 17, 1999	
SCALE (H)	1:250	F.L.D. BK. #	N/A					

DEPARTMENT OF PUBLIC WORKS

I-15 FREEWAY CHANNEL

CONSTRUCTION PLAN AND PROFILE

"FC" 3+000 TO "FC" 3+150

RECORD DRAWING METRIC

C-15

DRAWING No. 38

241