


**A LIGHT BOLLARD LAYOUT**

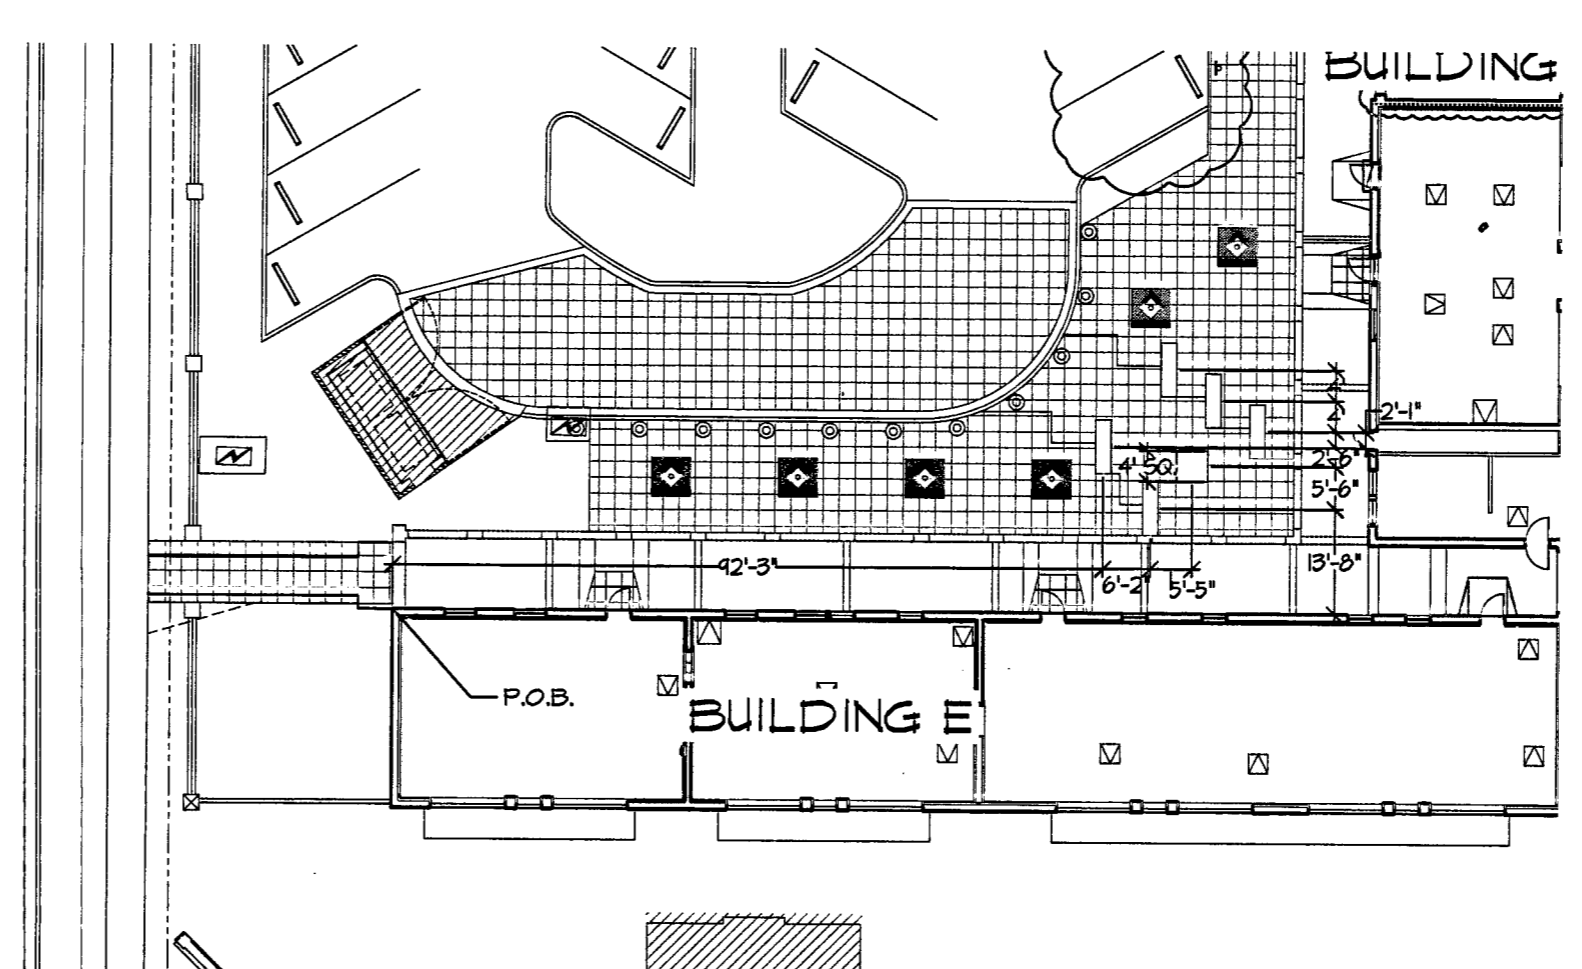

**B BENCH LAYOUT**

**RECORD DRAWINGS**  
DATE: 05-08-08


These record drawings have been reviewed based upon information furnished by others. While this information is believed to be reliable, J.A. Zunino and Associates cannot assure their accuracy, and is therefore, not responsible for the accuracy of these record drawings or for any errors or omissions that may have been incorporated as a result. Those relying on these record drawings are advised to obtain independent verification of their accuracy before applying it for any purpose.

**RECORD DRAWINGS**  
DATE: 12/12/2006  
Shavawn Coleman a/p/lon  
J. Zunino

**Call before you OVERHEAD**  
1-702-593-6111  
1-800-227-2600

**Call before you Dig.**  
1-800-227-2600

**JAZUNINO & ASSOCIATES**  
LANDSCAPE ARCHITECTURE - LAND PLANNING  
3791 South Jones Blvd. - Las Vegas - Nevada 89146  
Phone (702) 553-6900 - Fax (702) 553-6976 - Email jzunino@jazunino.com

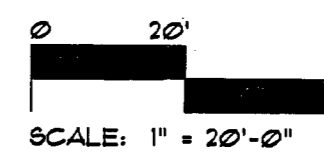

- 01 CLV COMMENTS 1/4/07
- 02 OWNER COMMENTS 2/2/07
- 03 OWNER COMMENTS 3/5/07
- 04 OWNER COMMENTS 11/28/07
- 05 OWNER REVISIONS 02/04/08

**KGA**  
ARCHITECTURAL  
4400 SOUTH POLARIS AVENUE  
LAS VEGAS, NEVADA 89103  
WWW.KGA-ARCHITECTS.COM  
TELEPHONE (702) 737-1600  
FACSIMILE (702) 737-1600

**CONSULTANT**  
HISTORICAL  
**HERITAGE ARCHITECTURE**  
CONSULTING ENGINEERS  
PHONE 68-229-7668

**CONSULTANT**  
CIVIL -  
VEHICLE  
**NEVADA**  
PHONE 702-477-7200

**CONSULTANT**  
STRUCTURAL -  
**BARKER DROTTER ASSOCIATES**  
STRUCTURAL ENGINEERS  
PHONE 702-737-8600


**CONSULTANT**  
MECHANICAL - PLUMBING - ELECTRICAL -  
FIRE SAFETY - ACoustical - GENERAL LIGHTING  
**JSA CONSULTING ENGINEERS**  
PHONE 702-940-8800

**CONSULTANT**  
STAGE LIGHTING & DESIGN -  
SCENE LIGHTING DESIGN GROUP  
PHONE 88-247-3300

**CONSULTANT**  
LANDSCAPE -  
**JWZUNINO & ASSOCIATES**  
PHONE 702-553-6900

**CONSULTANT**  
COST ESTIMATING -  
**RIDER HUNT**  
**LEVETT & BAILEY**  
PHONE 702-737-9888

**CONSULTANT**  
ADA ACCESSIBILITY  
**EDELMAN AND ASSOCIATES**  
PHONE 88-247-3300

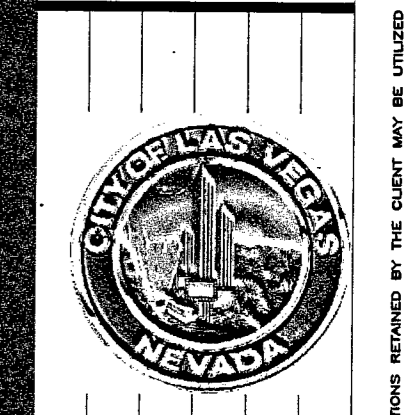

**FIFTH STREET SCHOOL**  
REHABILITATION  
BUILDING DEPARTMENT SUBMITTAL

**CITY OF LAS VEGAS**  
REDEVELOPMENT AGENCY

**OWNER: CITY OF LAS VEGAS**  
DEPARTMENT OF PUBLIC WORKS  
ARCHITECTURAL SERVICES

400 EAST STEWART AVENUE  
LAS VEGAS, NEVADA 89103  
PHONE: (702) 229-8236  
FAX: (702) 229-8236  
TDD: (702) 229-8236

**DRAWING**  
DATE: 12/12/2006  
SCALE: 1" = 20'-0"  
SHEET NO: L2.01

115660