

PLANT SCHEDULE


SYMBOL	BOTANICAL NAME	COMMON NAME	QTY.	SIZE	REMARKS
TREES					
⊗	CERCIDIUM X 'DESERT MUSEUM'	DESERT MUSEUM PALO VERDE	7	24" BOX	MULTI-TRUNK
⊗	GHTALPA TASHKENTENSIS 'PINK DAWN'	GHTALPA	31	24" BOX	
⊗	ELAEOCARPUS DICIPIENS	JAPANESE BLUEBERRY	4	24" BOX	
⊗	FRAXINUS VELUTINA 'RIO GRANDE'	FAN TEX ASH	25	24" BOX	
⊗	FRAXINUS VELUTINA 'RIO GRANDE'	FAN TEX ASH	6	48" BOX	
EXISTING TREES TO REMAIN					
⊗	EXISTING PALM TREE				
⊗	EXISTING TREE				
SHRUBS					
⊗	LEUCOPHYLLUM LANGSHANAE 'RIO BRAVO'	RIO BRAVO SAGE	65	5 GAL	
⊗	SENNA (CASSIA) OLIGOPHYLLA 'OUTBACK'	OUTBACK CASSIA	57	5 GAL	
⊗	XYLOSMA CONGESTUM 'COMPACTA'	COMPACT XYLOSMA	148	5 GAL	
GROUND COVERS					
⊗	DALEA GREGGII	TRAILING INDIGO BUSH	91	5 GAL	
⊗	LANTANA SPECIES 'NEH GOLD'	NEH GOLD LANTANA	187	5 GAL	
⊗	LANTANA MONTEVIDENSIS	PURPLE TRAILING LANTANA	66	5 GAL	
⊗	MALEPHORA LUTEA	ROCKY POINT ICEPLANT	11	5 GAL	
⊗	TRACHELOSPERMUM ASIATICUM	ASIATIC JASMINE	22	5 GAL	
ACCENTS					
⊗	DASYLIRION WHEELERI	DESERT SPOON	32	5 GAL	
⊗	DIETES BICOLOR	EVERGREEN IRIS	75	5 GAL	
⊗	HESPERALOE PARVIFLORA	RED YUCCA	68	5 GAL	
⊗	MULLENBERGIA CAPILLARIS 'REGAL MIST'	REGAL MIST DEER GRASS	58	5 GAL	

GENERAL NOTES:


- CONTRACTOR IS RESPONSIBLE TO VERIFY ALL PLANT QUANTITIES. THE PLANT SCHEDULE IS INTENDED AS A REFERENCE ONLY.
- LANDSCAPE ARCHITECT IS TO APPROVE ALL PLANT MATERIAL PRIOR TO INSTALLATION WITH PRIOR NOTICE OF 48 HOURS.
- PLANT MATERIAL IS TO HAVE IDENTIFICATION TAGS ON 10% OF THE TOTAL QUANTITY OF EACH SPECIES, SHOWING GENUS, SPECIES, VARIETY, ETC.
- CONTRACTOR TO PROVIDE MATCHING SIZES AND FORMS OF LIKE SHRUB SPECIES AS SHOWN ON DRAWINGS.
- CONTRACTOR TO PROVIDE POSITIVE DRAINAGE AWAY FROM ALL STRUCTURES, WALLS, AND ON ALL SIDEWALKS ACCORDING TO ALL CODES, REGULATIONS, AND REQUIREMENTS.
- DECOMPOSED GRANITE, 1/2" MINUS, COLOR, "PALOMINO CORAL", 2" DEPTH TYPICAL IN ALL PLANTING BEDS. DECOMPOSED GRANITE SHALL CONTAIN 60% AGGREGATE AND 40% FINES. CONTRACTOR TO RECEIVE VERIFICATION FROM ROCK SUPPLIER AND PRESENT VERIFICATION TO THE OWNER PRIOR TO ANY CONSTRUCTION.
- ALL PLANTING AREAS IN THE COURTYARD ARE TO BE OVER-EXCAVATED TO A DEPTH OF 24", THEN FILLED WITH ONE PART TOP SOIL TO ONE PART SOILS PLUS BY BIOMER, COMPACT AREA AS NEEDED, ADDING MORE SOIL AND SOILS PLUS AS NEEDED. SEE SPECIFICATIONS.
- CONTRACTOR TO INSTALL ROOT GUARD AT THE PERIMETER/EDGE OF PAVEMENT OF ALL PARKING ISLANDS AND ANY OTHER PLANTING AREAS NOTED ON THE PLANTING PLAN. CONTRACTOR TO INSTALL ROOT GUARD PER MANUFACTURER'S SPECIFICATIONS AND RECOMMENDATIONS.
 MODEL: UB 24-2
 MANUFACTURER: DEEP ROOT PARTNERS, L.P.
 345 LORTON AVENUE
 BURLINGAME, CA 94010
 TELEPHONE: (800) 458-1668
- CONTRACTOR TO PROTECT AND PRESERVE EXISTING LANDSCAPE AS NOTED ON SHEET L1.01. ANY PLANT MATERIAL OR LANDSCAPE MATERIALS DAMAGED BY DEMOLITION OR CONSTRUCTION IS TO BE REPLACED AT THE CONTRACTOR'S EXPENSE. CONTRACTOR IS TO REPLACE DAMAGED PLANT MATERIAL WITH MATERIAL OF THE SAME SIZE, GENUS, SPECIES, FORM, ETC.
- LANDSCAPE BOULDERS ARE TO BE GRANITE AND ROUND IN SHAPE. COLOR TO MATCH ROCK GROUND COVER. CONTRACTOR SHALL SUBMIT A SAMPLE TO OWNER'S REPRESENTATIVE FOR APPROVAL. CONTRACTOR TO SET 1/4 OF ROCK DIAMETER INTO FINISH GRADE. BOULDERS TO BE 2' TO 4' IN DIAMETER, SIZED ACCORDING TO THE FOLLOWING PERCENTAGES:
 20% 4' LARGEST DIAMETER
 40% 3' LARGEST DIAMETER
 40% 2' LARGEST DIAMETER
 TOTAL QUANTITY OF BOULDERS: 34
- SEE SHEET L4.01 FOR IRRIGATION AND SHEET L1.01 FOR MAINTENANCE OF EXISTING PLANT MATERIAL TO REMAIN. REFER TO SHEET L5.01 FOR PLANTING DETAILS.
- ARIZONA RIVER ROCK, 2"-4" SIZE, 4" MIN. DEPTH, SHALL BE LOCATED AT ROOF DRAIN EXITS LOCATED IN LANDSCAPE PLANTERS AS SHOWN ON PLAN.
- LANDSCAPE BENCH: (PER CLV OAS STANDARDS) COLOR TERRACOTTA, SMOOTH TEXTURE, MATTE FINISH. CONCRETE PRODUCTS:
 741 W PARKRIDGE AVE
 PO BOX 639
 NORCO, CA 91760
 (909) 737-6240
 MODEL: Q1-VIC-04B
 WSKATE STOP GROOVE & CENTER DIVIDER QUANTITY: 5
- TREE GRATE:
 KANBASH VALLEY,
 505 E MAIN STREET
 PO BOX 5
 SILVER LAKE, IN 46842
 (800) 253-8619
 MODEL: T6160
 QUANTITY: 18
- BUS STOP BENCH.
 LANDSCAPEFORMS
 431 LANSDALE AVENUE
 KALAMAZOO, MI 49048
 (800) 521-2546
 MODEL: PRESIDIO COLLECTION
 STRAIGHT FIVE UNIT SEAT, BENCH STYLE
 COLOR BY ARCHITECT
 QTY: 1
- TRASH RECEPTACLE WITH ASH URN.
 LANDSCAPEFORMS
 431 LANSDALE AVENUE
 KALAMAZOO, MI 49048
 (800) 521-2546
 MODEL: PRESIDIO COLLECTION
 TOP OPENING RECEPTACLE WITH ASH URN, 30 GAL. CAPACITY
 COLOR BY ARCHITECT
 QTY: 10

RECORD DRAWINGS
DATE: 03-08-08

These record drawings have been reviewed based upon information furnished by others. While this information is believed to be reliable, J.W. Zunino and Associates cannot assure their accuracy, and is therefore, not responsible for the accuracy of these record drawings or for any errors or omissions that may have been incorporated as a result. Those relying on these record drawings are advised to obtain independent verification of their accuracy before applying it for any purpose.

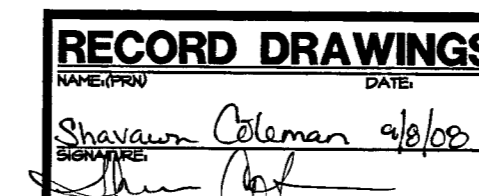

JWZUNINO & ASSOCIATES
LANDSCAPE ARCHITECTURE - LAND PLANNING
3191 South Jones Blvd. - Las Vegas, Nevada 89146
Phone (702) 253-9390 - Fax (702) 253-9376 - Email jwzunino.com

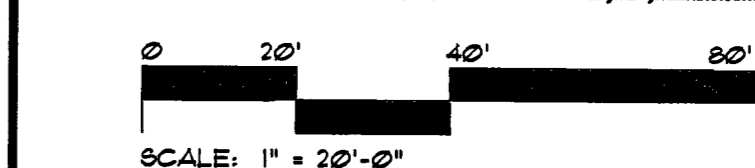

Call before you OVERHEAD Call before you Dig.
1-702-593-6111 1-800-227-2600

REVISED 8/27/03

OWNER: CITY OF LAS VEGAS
DEPARTMENT OF PUBLIC WORKS
ARCHITECTURAL SERVICES

400 EAST STEWART AVENUE
LAS VEGAS, NEVADA 89101
PHONE: (702) 229-8338
FAX: (702) 884-8846
WWW.CITYOFVegas.COM

CONSULTANT:
KGA
KENTON GARDNER ARCHITECTS
1400 SOUTH KLASMEYER AVENUE
LAS VEGAS, NEVADA 89102
PHONE: (702) 735-8800
TELEPHONE: (702) 887-1880
FACSIMILE: (702) 887-1883

CONTRACTOR:
BARKER DROTTER ASSOCIATES
STRUCTURAL ENGINEERS
PHONE: 702-399-9000

MECHANICAL - PLUMBING - ELECTRICAL -
IRE BARRY - ARCHITECTURAL - GENERAL CONTRACTOR
SEA CONSULTING ENGINEERS
PHONE: 702-341-5000

STAGE LIGHTING & DESIGN -
CDM LIGHTING DESIGN GROUP
PHONE: 888-353-3333

LANDSCAPE -
JWZUNINO & ASSOCIATES
PHONE: 702-253-9390

CONTRACTOR:
FRIDER HUNT LEVETT & BAILEY
PHONE: 702-735-8800

ADA ACCESSIBILITY
FRIDER HUNT LEVETT & BAILEY
PHONE: 702-735-8800

CITY OF LAS VEGAS
REDEVELOPMENT AGENCY

**FIFTH STREET SCHOOL
REHABILITATION
BUILDING DEPARTMENT SUBMITTAL**

DATE: 12/12/2006
SCALE: 1" = 20'-0"
CLV NO: L3.01