


PLAN NOTES

P	DESCRIPTION
P1.	DASHED LINE INDICATES STRUCTURE ABOVE
P2.	TELEPHONE
P3.	NEW CONCRETE STAIR AND WALL TO MATCH EXISTING.
P4.	AUDITORIUM WALLS SHALL BE WITH 2" THICK FABRIC ACOUSTICAL WALL PANELS
P5.	SEE INTERIOR ELEVATIONS
P6.	CLERESTORY AUDITORIUM AND PLATFORM WINDOW SHALL HAVE MOTORIZED BLACKOUT SHADES
P7.	NEW ACCESSIBLE RAMP AND RAILING
P8.	FIRE EXTINGUISHER CABINET, SEE 14/A9.01.
P9.	NEW STAIR AND HANDRAIL
P10.	MECHANICAL/MOTORIZED LIFT TO PLATFORM
P11.	RELOCATED ELECTRICAL PANEL SYSTEM. SEE ELECTRICAL DRAWINGS.
P12.	NEW CASEWORK
P13.	NEW TWO-BAY SINK. SEE PLUMBING DWGS.
P14.	NEW REFRIGERATOR - N.I.C.
P15.	NEW CMU WALL ENCLOSURE. SEE 5/AS2.01.
P16.	STEEL BOLLARD. SEE DETAIL SHEET AS2.01.
P17.	CONCRETE PIER. SEE STRUCTURAL DWGS.
P18.	GATE ENCLOSURE-SEE DETAIL 6/AS2.01
P19.	LINE OF EXISTING SKYLIGHT TO BE RESTORED.
P20.	REMOVABLE RAILING FOR TRUCK DELIVERY. SEE DETAIL 11/A1.33.
P21.	PROVIDE HORIZONTAL MANUAL WINDOW BLIND AT THIS WINDOW.
P22.	EXISTING CONCRETE COLUMN TO REMAIN.
P23.	DRINKING FOUNTAIN. SEE PLUMBING DWGS.
P24.	EXISTING FOUNTAIN TO BE RENOVATED.
P25.	EXISTING BREZZEWAY
P26.	EXISTING CONSTRUCTION TO BE REMOVED AND/OR RESTORED WITH DOORS AND/OR WINDOWS TO MATCH HISTORIC ERA. REFER TO WINDOW AND DOOR SCHEDULE FURNITURE SHOWN ON PLAN SHALL BE TENANT FURNISHED AND TENANT INSTALLED
P27.	NEW SINK SEE PLUMBING DWGS.
P28.	EXISTING BASEMENT STAIR TO REMAIN.
P29.	INFILL STAIRWELL & GAP WITH CONC. SLAB.
P30.	EXISTING CONCRETE WALL TO BE REMOVED SAND AND FINISH EXISTING CONCRETE WALL FOR PAINT
P31.	NEW BABY CHANGING STATION.
P32.	ALIGN FACE OF NEW PARTITION WITH FACE OF EXISTING CONCRETE
P33.	NEW COUNTER TRASH DISPOSAL
P34.	NEW COUNTER TRASH DISPOSAL
P35.	ACCESS LADDER AND HATCH SEE 5/A7.31
P36.	NEW CONCRETE. SEE 11/AS2.01.
P37.	1" RECESS INFILL PER 4/A9.05.
P38.	LINE INDICATE DIRECTION OF WOOD PLANK FLOORING. SEE STRUCTURAL DWGS.
P39.	RECONSTRUCT SEGMENT OF PARTIAL HEIGHT WALL TO MATCH ADJACENT EXISTING WALL
P40.	REMOVE DOOR, INFILL OPENING WITH CONCRETE, FLUSH TO EXTERIOR WALL MATCH EXISTING FINISH AND TEXTURE. PATTERNED GLASS WINDOW PER SPEC.
P41.	EXISTING METAL GATE
P42.	ROOF DRAIN SEE DETAIL 3/A7.31
P43.	INSTALL NEW CABINET DOORS ON EXISTING CABINET. SEE DETAIL 5/A8.02
P44.	STAGGLAM HIGH TRAFFIC FLOORING
P45.	EXISTING CONCRETE PAD TO REMAIN
P46.	EXISTING DIVIDED LIGHT TRANSOM/DOOR ASSEMBLY
P47.	ASSEMBLY
P48.	CONCRETE SLUMP PIT W/ STEEL GRATE
P49.	FURR OVER WINDOW.

- ### GENERAL NOTES
- DIMENSIONS ARE TO FACE OF STUD, FACE OF MASONRY OR FACE OF CONCRETE UNLESS NOTED OTHERWISE.
 - INFORM ARCHITECT OF ANY DISCREPANCIES BEFORE BEGINNING OF WORK.
 - PRIOR TO CONSTRUCTION, CONTRACTOR SHALL FIELD VERIFY ALL EXISTING CONDITIONS. IN AREAS REQUIRING REPAIR AND/OR REMOVAL, CONTRACTOR SHALL PATCH AND PREP SURFACES FOR NEW FINISH.
 - PATCH ALL HOLES IN EXTERIOR CONCRETE WALLS INCLUDING LADDER HOLES, CONDUIT, AND PIPE HOLES, ETC. CAUSED BY DEMO. REPAIR AND PAINT ALL GRAM. SPACE VENT GRILLES - TYPICAL.

- ### WALL TYPES
1. WALL TYPE SYMBOL - SEE SHEET A2.32 & A2.33 FOR WALL TYPES
- NOTES
- WALL TYPES WITH AN 'S' SUBSCRIPT INDICATE FIBERGLASS ACOUSTICAL INSULATION FULL HEIGHT AND DEPTH OF PARTITION NOTED AND REQUIRES THE GYP. BOARD TO EXTEND FROM TOP OF FLOOR SLAB TO UNDERSIDE OF STRUCTURE ABOVE ON ONE SIDE OF PARTITION THAT OTHERWISE WOULD NOT EXTEND TO THE STRUCTURE ABOVE.
 - PROVIDE HEAVY GAGE METAL STUDS IN LIEU OF LIGHT GAGE METAL STUDS AT WALLS WITH ANY WALL HUNG TYPE ATTACHMENTS AND/OR SUPPORTING ATTACHMENTS SUCH AS WALL SINKS, GRAB BARS, WALL CABINETS AND OTHER MISC. EQUIPMENT.
 - ALL WALLS IN WET AREAS SHALL HAVE 5/8" TYPE 'X' WATER-RESISTANT GYPSUM BOARD IN LIEU OF 5/8" TYPE 'X' (REGULAR) GYPSUM BOARD.
 - ALL INTERIOR PARTITIONS ARE NON-BEARING.
 - WALLS WITH SUBSCRIPT 'T' INDICATES WALLS WITH THERMAL INSULATION FOR THE FULL HEIGHT OF THE WALL.

- ### WALL LEGEND
- FRAMED INTERIOR PARTITION
 - EXISTING CONCRETE PARTITION
 - NEW CONCRETE PARTITION
 - FURRED CONCRETE PARTITION
 - 1 HOUR RATED FRAMED INTERIOR PARTITION PER U.L. DESIGN WJ2005. SEE DETAIL 11/A9.06.

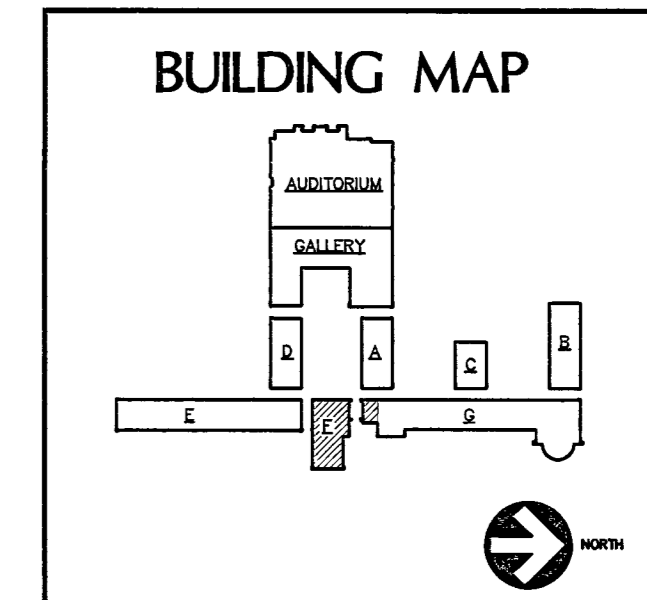

REVISIONS

CLV COMMENTS
2-1-2007

OWNER COMMENTS
2-1-2007

ARCHITECT
HERITAGE ARCHITECTURE & PLANNING
100 SOUTH FRANKLIN AVENUE
LAS VEGAS, NEVADA 89101
PHONE: 702.387.8800
FACSIMILE: 702.387.3840

MECHANICAL - PLUMBING - ELECTRICAL - LIFE SAFETY - ACOUSTICAL - GENERAL LIGHTING
JEA CONSULTING ENGINEERS
PHONE: 702.942.9000

MECHANICAL - PLUMBING - ELECTRICAL - LIFE SAFETY - ACOUSTICAL - GENERAL LIGHTING
JEA CONSULTING ENGINEERS
PHONE: 702.942.9000

STAGE LIGHTING & DESIGN
CDM LIGHTING DESIGN GROUP
PHONE: 888.292.2323

LANDSCAPE
JANZUNO & ASSOCIATES
PHONE: 702.259.2500

SOFT GRAPHICS
RIDER HUNT
LEVETT & BAILEY
PHONE: 702.387.8800

ADA ACCESSIBILITY
ENDEL MANN AND ASSOCIATES
PHONE: 202.331.6442

CITY OF LAS VEGAS REDEVELOPMENT AGENCY

OWNER: CITY OF LAS VEGAS DEPARTMENT OF PUBLIC WORKS ARCHITECTURAL SERVICES

400 EAST STEWART AVENUE
LAS VEGAS, NEVADA 89101
PHONE: (702) 259-8535
FAX: (702) 386-8846
TDD: (702) 386-9108

DESIGNER:
ED C. REDEVELOPMENT AGENCY
12/12/2006
SCALE:
1/4" = 1'-0"
REV. NO.
CLV DWG. NO. 313-65E

RECORD DRAWINGS

A1.16