


PLAN NOTES

P	DESCRIPTION
P1.	DASHED LINE INDICATES STRUCTURE ABOVE TELEPHONE
P2.	NEW CONCRETE STAIR AND WALL TO MATCH EXISTING
P3.	AUDITORIUM WALLS SHALL BE WITH 2" THICK FABRIC ACOUSTICAL WALL PANELS
P4.	SEE INTERIOR ELEVATIONS
P5.	CLERESTORY AUDITORIUM AND PLATFORM WINDOW SHALL HAVE MOTORIZED BLACKOUT SHADES
P6.	NEW ACCESSIBLE RAMP AND RAILING
P7.	FIRE EXTINGUISHER CABINET. SEE 14/A9.01
P8.	NEW STAIR AND HANDRAIL
P9.	MECHANICAL/AUTHORIZED LIFT TO PLATFORM
P10.	RELOCATED ELECTRICAL PANEL SYSTEM. SEE ELECTRICAL DRAWINGS
P11.	NEW CASEWORK
P12.	NEW TWO-BAY SINK. SEE PLUMBING DWGS.
P13.	NEW REFRIGERATOR - N.I.C.
P14.	NEW CMU WALL ENCLOSURE. SEE 5/AS2.01
P15.	STEEL BOLLARD. SEE DETAIL SHEET AS2.01
P16.	CONCRETE PIER. SEE STRUCTURAL DWGS.
P17.	GATE ENCLOSURE - SEE DETAIL 6/AS2.01
P18.	LINE OF EXISTING SKYLIGHT TO BE RESTORED
P19.	REMOVE RAILING FOR TRUCK DELIVERY. SEE DETAIL 1/A1.33
P20.	PROVIDE HORIZONTAL MANUAL WINDOW BLIND AT THIS WINDOW
P21.	EXISTING CONCRETE COLUMN TO REMAIN
P22.	DRINKING FOUNTAIN. SEE PLUMBING DWGS.
P23.	EXISTING FOUNTAIN TO BE RENOVATED
P24.	EXISTING COVERED BREEZEWAY
P25.	EXISTING CONSTRUCTION TO BE REMOVED AND/OR RESTORED WITH DOORS AND/OR WINDOWS TO MATCH HISTORIC ERA
P26.	REFER TO WINDOW AND DOOR SCHEDULE
P27.	FURNITURE SHOWN ON PLAN SHALL BE TENANT FURNISHED AND TENANT INSTALLED
P28.	NEW SINK. SEE PLUMBING DWGS.
P29.	EXISTING BASEMENT STAIR TO REMAIN
P30.	INFILL STAIRWELL & GAP WITH CONC. SLAB
P31.	EXISTING CONCRETE WALL TO BE REMOVED SAND AND FINISH EXISTING CONCRETE WALL FOR PAINT
P32.	NEW BABY CHANGING STATION
P33.	ALIGN FACE OF NEW PARTITION WITH FACE OF EXISTING CONCRETE
P34.	NEW COUNTER TRASH DISPOSAL
P35.	ACCESS LADDER AND HATCH SEE 5/A7.31
P36.	NEW CONCRETE. SEE 11/AS2.01
P37.	1" RECESS INFILL PER 4/A9.05
P38.	LINE INDICATE DIRECTION OF WOOD PLANK FLOORING. SEE STRUCTURAL DWGS.
P39.	RECONSTRUCT SEGMENT OF PARTIAL HEIGHT WALL TO MATCH ADJACENT EXISTING WALL
P40.	REMOVE DOOR, INFILL OPENING WITH CONCRETE FLUSH TO EXTERIOR WALL
P41.	MATCH EXISTING FINISH AND TEXTURE
P42.	PATTERNED GLASS WINDOW PER SPEC.
P43.	EXISTING METAL GATE
P44.	INSTALL NEW CABINET DOORS ON EXISTING CABINET. SEE DETAIL 5/A8.02
P45.	STAGELAN HIGH TRAFFIC FLOORING
P46.	EXISTING CONCRETE PAD TO REMAIN
P47.	ASSEMBLY
P48.	CONCRETE SLUMP PIT W/ STEEL GRATE
P49.	FURR OVER WINDOW

- ### GENERAL NOTES
- DIMENSIONS ARE TO FACE OF STUD, FACE OF MASONRY OR FACE OF CONCRETE UNLESS NOTED OTHERWISE. INFORM ARCHITECT OF ANY DISCREPANCIES BEFORE BEGINNING OF WORK.
 - PRIOR TO CONSTRUCTION, CONTRACTOR SHALL FIELD VERIFY ALL EXISTING CONDITIONS. IN AREAS REQUIRING REPAIR AND/OR REMOVAL, CONTRACTOR SHALL PATCH AND PREP SURFACES FOR NEW FINISH.
 - PATCH ALL HOLES IN EXTERIOR CONCRETE WALLS INCLUDING LADDER HOLES, CONDUIT, AND PIPE HOLES, ETC. CAUSED BY DEMO. REPAIR AND PAINT ALL CRACKS. SPACE VENT GRILLES - TYPICAL.

- ### WALL TYPES
1. WALL TYPE SYMBOL - SEE SHEET A2.32 & A2.33 FOR WALL TYPES
- NOTES
- WALL TYPES WITH AN "S" SUBSCRIPT INDICATE FIBERGLASS ACOUSTICAL INSULATION FULL HEIGHT AND DEPTH OF PARTITION NOTED AND REQUIRES THE GYP. BOARD TO EXTEND FROM TOP OF FLOOR SLAB TO UNDERSIDE OF STRUCTURE ABOVE ON ONE SIDE OF PARTITION THAT OTHERWISE WOULD NOT EXTEND TO THE STRUCTURE ABOVE.
 - PROVIDE HEAVY GAGE METAL STUDS IN LIEU OF LIGHT GAGE METAL STUDS AT WALLS WITH ANY WALL HUNG TYPE ATTACHMENTS AND/OR SUPPORTING ATTACHMENTS SUCH AS WALL SINKS, GRAB BARS, WALL CABINETS AND OTHER MISC. EQUIPMENT.
 - ALL WALLS IN WET AREAS SHALL HAVE 5/8" TYPE "X" WATER-RESISTANT GYPSUM BOARD IN LIEU OF 5/8" TYPE "X" (REGULAR) GYPSUM BOARD.
 - ALL INTERIOR PARTITIONS ARE NON-BEARING.
 - WALLS WITH SUBSCRIPT "T" INDICATES WALLS WITH THERMAL INSULATION FOR THE FULL HEIGHT OF THE WALL.

- ### WALL LEGEND
- FRAMED INTERIOR PARTITION
 - EXISTING CONCRETE PARTITION
 - NEW CONCRETE PARTITION
 - FURRED CONCRETE PARTITION
 - 1 HOUR RATED FRAMED INTERIOR PARTITION PER U.L. DESIGN W2005. SEE DETAIL 11/A9.06.

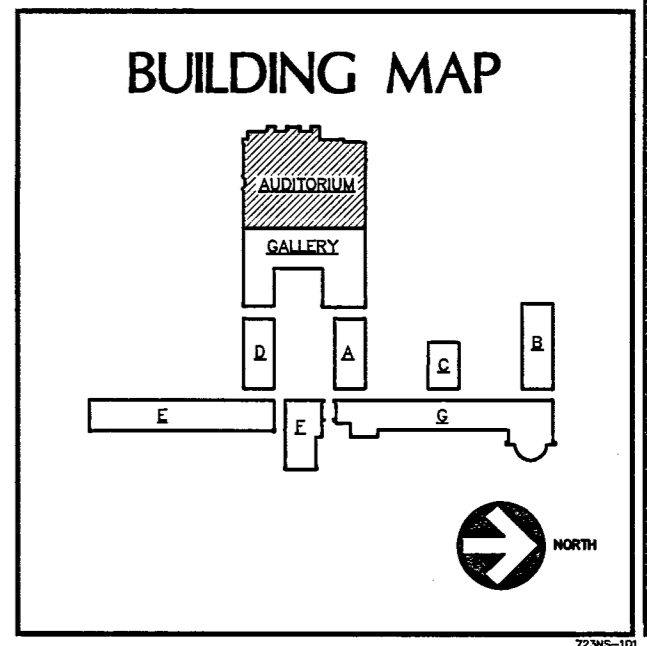

REVISED

CLV COMMENTS 11-9-07
OWNER COMMENTS 2-2-2007
ARCH. COORDINATIONS 12-9-2007

KCA
KITCHEN ARCHITECTS
FITZELL GRIFFITH
AND ASSOCIATES, AIA
100 SOUTH EDWARDS AVENUE
LAS VEGAS, NEVADA 89101
PHONE: (702) 386-8800
FACSIMILE: (702) 386-2549

HERITAGE ARCHITECTURE
PLANNING
PHONE: 492-2978

CONTRACTOR:
5TH NEVADA
PHONE: 702-673-7280

STRUCTURAL ENGINEER:
BARKER DROTTER ASSOCIATES
STRUCTURAL ENGINEERS
PHONE: 702-381-8800

MECHANICAL - PLUMBING - ELECTRICAL - LIFE SAFETY - ACOUSTICAL - GENERAL LIGHTING
ISA CONSULTING ENGINEERS
PHONE: 702-381-9500

STAGE LIGHTING & DESIGN -
CDM LIGHTING DESIGN GROUP
PHONE: 802-228-2222

LANDSCAPE:
JWZUNINO & ASSOCIATES
PHONE: 702-257-5566

COST ESTIMATOR:
RIDER MINT

LEVEITT & BAILEY
PHONE: 702-381-7881

ADA ACCESSIBILITY:
ENKELMANN AND ASSOCIATES
PHONE: 202-331-6442

CITY OF LAS VEGAS
REDEVELOPMENT AGENCY

FIFTH STREET SCHOOL REHABILITATION BUILDING DEPARTMENT SUBMITTAL

RECORD DRAWINGS

OWNER: CITY OF LAS VEGAS
DEPARTMENT OF PUBLIC WORKS ARCHITECTURAL SERVICES

400 EAST STEWART AVENUE
LAS VEGAS, NEVADA 89103
PHONE: (702) 229-6535
FACSIMILE: (702) 386-8800
TDD: (702) 386-9108

PROJECT:
ED C.
AUDITORIUM PLAN
DATE:
12/12/2006
SCALE:
1/4" = 1'-0"
NO.:
CLV/NO. NO.:
513-65E

DATE:
A.11

REVISED 8/27/03

ENLARGED AUDITORIUM PLAN
SCALE: 1/4" = 1'-0"

723-FLR.dwg

115675