

PLAN NOTES

- | NO. | DESCRIPTION |
|------|---|
| P1. | DASHED LINE INDICATES STRUCTURE ABOVE TELEPHONE |
| P2. | NEW CONCRETE STAIR AND WALL TO MATCH EXISTING. |
| P3. | ALIGN WALL BETWEEN WINDOWS. |
| P4. | AUDITORIUM WALLS SHALL BE WITH 2" THICK FABRIC ACOUSTICAL WALL PANELS SEE INTERIOR ELEVATIONS |
| P5. | CLEARESTORY AUDITORIUM AND PLATFORM WINDOW SHALL HAVE MOTORIZED BLACKOUT SHADES |
| P6. | NEW ACCESSIBLE RAMP AND RAILING |
| P7. | FIRE EXTINGUISHER CABINET. SEE 14/A9.01. |
| P8. | NEW STAIR AND HANDRAIL |
| P9. | MECHANICAL/MOTORIZED LIFT TO PLATFORM |
| P10. | RELOCATED ELECTRICAL PANEL SYSTEM. SEE ELECTRICAL DRAWINGS. |
| P11. | NEW CASEWORK |
| P12. | NEW TWO-BAY SINK. SEE PLUMBING DWGS. |
| P13. | NEW REFRIGERATOR - N.I.C. |
| P14. | NEW CMU WALL ENCLOSURE. SEE 5/AS2.01. |
| P15. | STEEL BOLLARD. SEE DETAIL SHEET AS2.01 |
| P16. | CONCRETE PIER. SEE STRUCTURAL DWGS. |
| P17. | GATE ENCLOSURE-SEE DETAIL 6/AS2.01 |
| P18. | LINE OF EXISTING SKYLIGHT TO BE RESTORED. |
| P19. | REMOVEABLE RAILING FOR TRUCK DELIVERY. SEE DETAIL 1/A1.33. |
| P20. | PROVIDE HORIZONTAL MANUAL WINDOW BLIND AT THIS WINDOW. |
| P21. | EXISTING CONCRETE COLUMN TO REMAIN. |
| P22. | DRINKING FOUNTAIN. SEE PLUMBING DWGS. |
| P23. | EXISTING FOUNTAIN TO BE RENOVATED. |
| P24. | EXISTING COVERED BREZZEWAY |
| P25. | EXISTING CONCRETE TO BE REMOVED AND/OR RESTORED WITH DOORS AND/OR WINDOWS TO MATCH HISTORIC ERA- REFER TO WINDOW AND DOOR SCHEDULE |
| P26. | FURNITURE SHOWN ON PLAN SHALL BE TENANT FURNISHED AND TENANT INSTALLED |
| P27. | NEW SINK. SEE PLUMBING DWGS. |
| P28. | EXISTING BASEMENT STAIR TO REMAIN. |
| P29. | INFILL STAIRWELL & CAP WITH CONC. SLAB. |
| P30. | EXISTING CONCRETE WALL TO BE REMOVED SAND AND FINISH EXISTING CONCRETE WALL FOR PAINT |
| P31. | NEW BABY CHANGING STATION. |
| P32. | ALIGN FACE OF NEW PARTITION WITH FACE OF EXISTING CONCRETE |
| P33. | NEW COUNTER TRASH DISPOSAL. |
| P34. | ACCESS LADDER AND HATCH SEE 5/A7.31 |
| P35. | NEW CONCRETE. SEE 11/AS2.01. |
| P36. | RECESS INFILL PER 4/A9.05 |
| P37. | RECESS INFILL PER 4/A9.05 |
| P38. | RECESS INFILL PER 4/A9.05 |
| P39. | RECONSTRUCT SEGMENT OF PARTIAL HEIGHT WALL TO MATCH ADJACENT EXISTING WALL REMOVE DOOR, INFILL OPENING WITH CONCRETE, FLUSH TO EXTERIOR WALL. |
| P40. | MATCH EXISTING FINISH AND TEXTURE. PATTERNED GLASS WINDOW PER SPEC. |
| P41. | EXISTING METAL GATE |
| P42. | ROOF DRAIN SEE DETAIL 3/A7.31 |
| P43. | INSTALL NEW CABINET DOORS ON EXISTING CABINET. SEE DETAIL 5/A8.02 |
| P44. | STAGELAM HIGH TRAFFIC FLOORING |
| P45. | EXISTING CONCRETE PAD TO REMAIN |
| P46. | EXISTING DIVIDED LIGHT TRANSOM/DOOR ASSEMBLY |
| P47. | CONCRETE SUMP PIT W/ STEEL GRATE |
| P48. | FURR OVER WINDOW. |
| P49. | FURR OVER WINDOW. |

GENERAL NOTES

- DIMENSIONS ARE TO FACE OF STUD, FACE OF MASONRY OR FACE OF CONCRETE UNLESS NOTED OTHERWISE
- INFORM ARCHITECT OF ANY DISCREPANCIES BEFORE BEGINNING WORK.
- PRIOR TO CONSTRUCTION, CONTRACTOR SHALL FIELD VERIFY ALL EXISTING CONDITIONS. IN AREAS REQUIRING REPAIR AND/OR REMOVAL, CONTRACTOR SHALL PATCH AND PREP SURFACES FOR NEW FINISH.
- PATCH ALL HOLES IN EXTERIOR CONCRETE WALLS INCLUDING LADDER HOLES, CONDUIT, AND PIPE HOLES, ETC. CAUSED BY DEMO. REPAIR AND PAINT ALL CRAWL SPACE VENT GRILLES - TYPICAL.



WALL TYPES

- NOTES**
- WALL TYPES WITH AN 'S' SUBSCRIPT INDICATE FIBERGLASS ACOUSTICAL INSULATION FULL HEIGHT AND DEPTH OF PARTITION NOTED AND REQUIRES THE GYP. BOARD TO EXTEND FROM TOP OF FLOOR SLAB TO UNDERSIDE OF STRUCTURE ABOVE ON ONE SIDE OF PARTITION THAT OTHERWISE WOULD NOT EXTEND TO THE STRUCTURE ABOVE.
 - PROVIDE HEAVY GAGE METAL STUDS IN LIEU OF LIGHT GAGE METAL STUDS AT WALLS WITH ANY WALL HUNG TYPE ATTACHMENTS AND/OR SUPPORTING ATTACHMENTS SUCH AS WALL SINKS, GRAB BARS, WALL CABINETS AND OTHER MISC. EQUIPMENT.
 - ALL WALLS IN MET AREAS SHALL HAVE 5/8" TYPE 'X' WATER-RESISTANT GYPSUM BOARD IN LIEU OF 5/8" TYPE 'X' (REGULAR) GYPSUM BOARD.
 - ALL INTERIOR PARTITIONS ARE NON-BEARING
 - WALLS WITH SUBSCRIPT 'T' INDICATES WALLS WITH THERMAL INSULATION FOR THE FULL HEIGHT OF THE WALL.

WALL LEGEND

- FRAMED INTERIOR PARTITION
- EXISTING CONCRETE PARTITION
- NEW CONCRETE PARTITION
- FURRED CONCRETE PARTITION
- 1 HOUR RATED FRAMED INTERIOR PARTITION PER U.L. DESIGN WJ2005. SEE DETAIL 11/A9.06.

BUILDING MAP

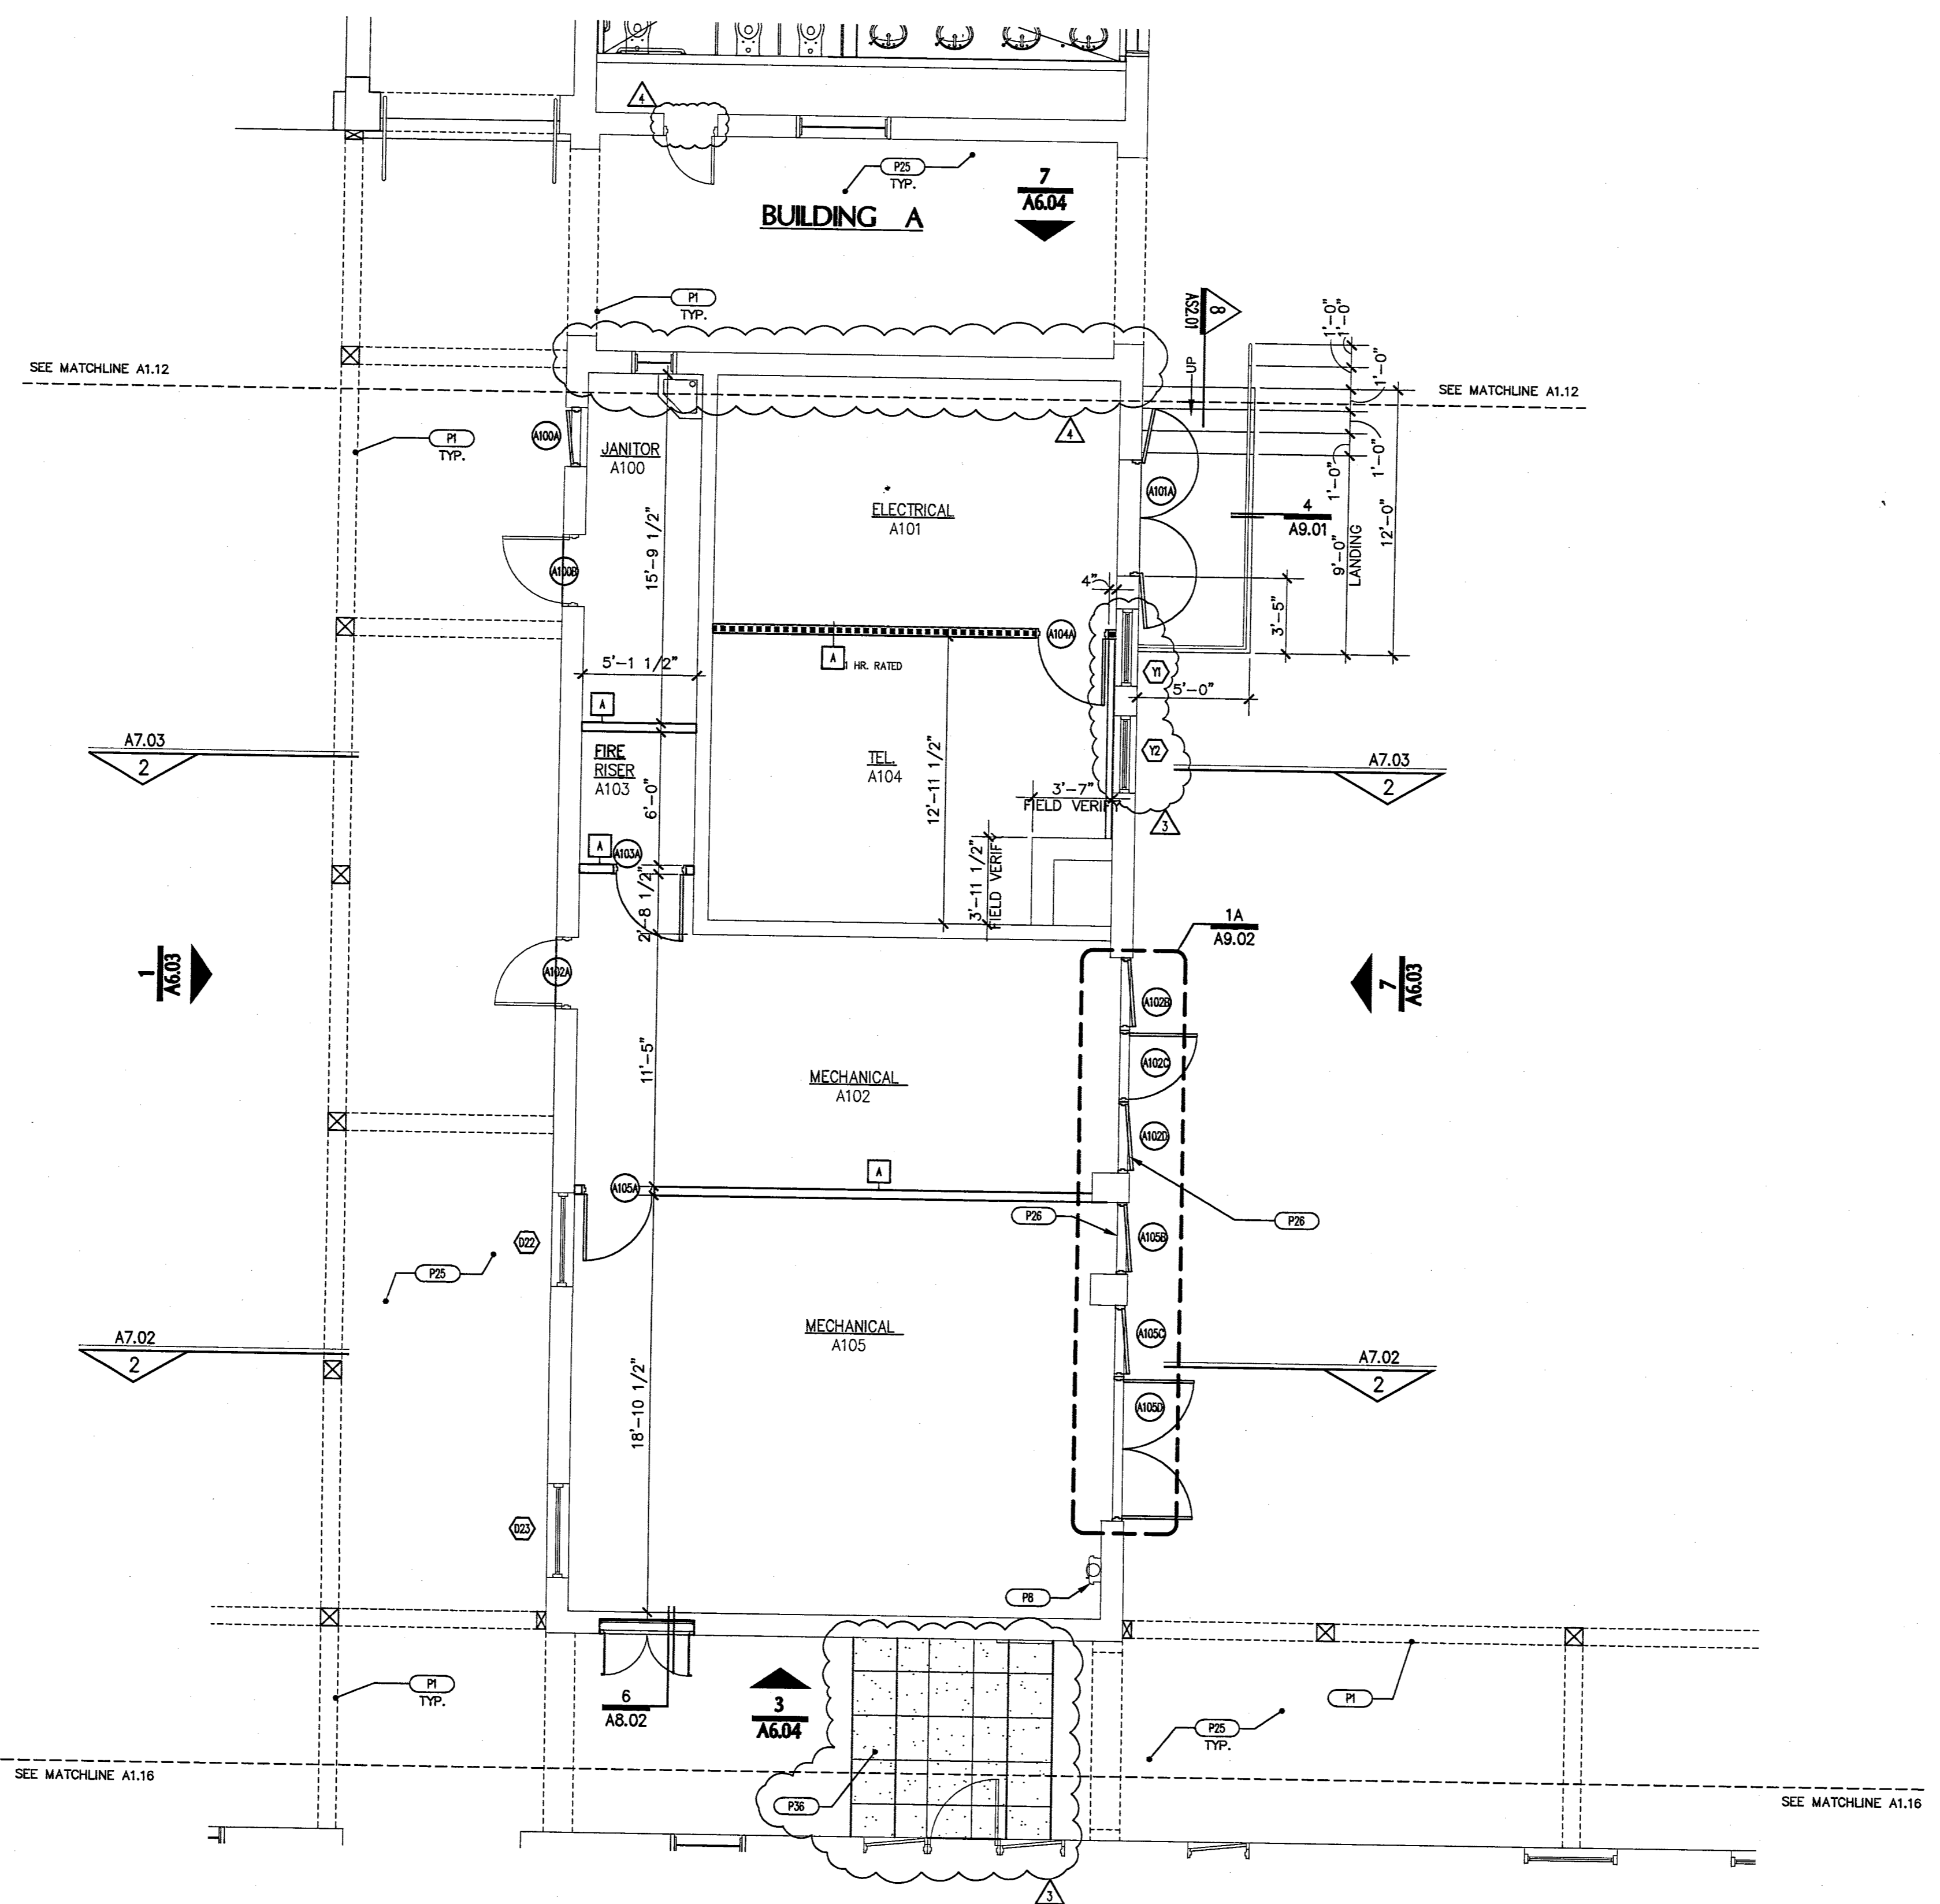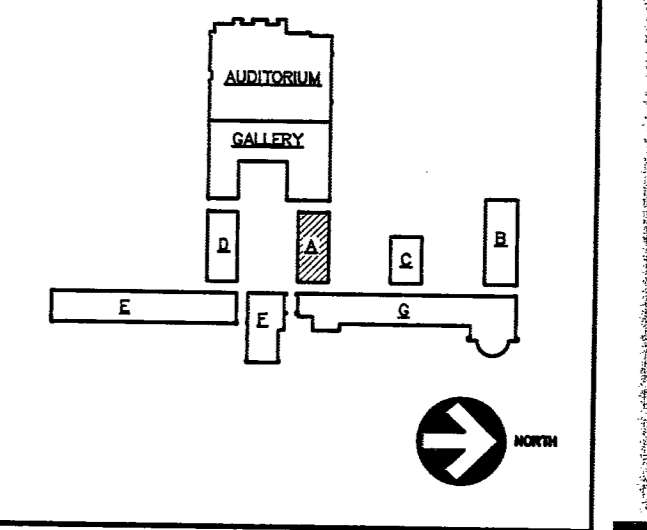

RECEIVED
FEB 08 2007
CITY OF LAS VEGAS
BUILDING DEPT.

PLANS APPROVED
ARCHITECTURAL
Building & Safety Dept.
City of Las Vegas, Nevada
JCF FEB 09 2007
Do not include Electrical, Plumbing, Mechanical, Structural or Off-Site Improvements Made No Change Without Approval Plan Is Not a Permit to Violate Any Ordinance

PLAN CHECK
REVISED 12.27.07

CLV COMMENTS
12-2007

OWNER COMMENTS
12-2007

CONSULTANT
KGA
ARCHITECTURAL
1000 SOUTH POLARIS AVENUE
LAS VEGAS, NEVADA 89101
PHONE: (702) 259-6324
FAX: (702) 386-6846
MOBILE: (702) 386-9108

HERITAGE ARCHITECTURE & PLANNING
1000 SOUTH POLARIS AVENUE
LAS VEGAS, NEVADA 89101
PHONE: (702) 259-6324
FAX: (702) 386-6846
MOBILE: (702) 386-9108

VTN
NEVADA
PHONE: 702-677-7700

STRUCTURAL
BARKER DROTTER ASSOCIATES
STRUCTURAL ENGINEERS
PHONE: 702-259-8800

MECHANICAL - PLUMBING - ELECTRICAL - FIRE SAFETY - ACOUSTICAL - GENERAL LIGHTING
JSA CONSULTING ENGINEERS
PHONE: 702-380-7000

STAIR LIGHTING & DESIGN
CHAM LIGHTING DESIGN GROUP
PHONE: 88-239-2322

LANDSCAPE
JWZIANO & ASSOCIATES
PHONE: 702-259-8800

COFFER CEILING
RIDER HUNT
LEVETT & BAILEY
PHONE: 702-259-8800


ADA ACCESSIBILITY
EDELMAN AND ASSOCIATES
PHONE: 202-239-6441



FIFTH STREET SCHOOL
REHABILITATION
BUILDING DEPARTMENT SUBMITTAL

REVISED
12.27.07

CITY OF LAS VEGAS
REDEVELOPMENT AGENCY

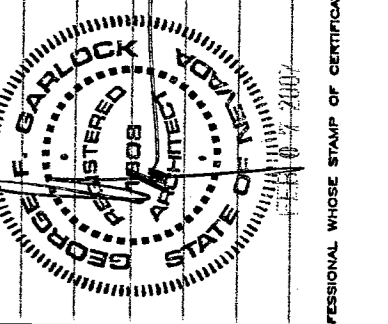

OWNER: CITY OF LAS VEGAS
DEPARTMENT OF PUBLIC WORKS
ARCHITECTURAL SERVICES

400 EAST STEWART AVENUE
LAS VEGAS, NEVADA 89101
PHONE: (702) 259-6324
FAX: (702) 386-6846
TDD: (702) 386-9108

DATE: 12/12/2006
SCALE: 1/4" = 1'-0"
SHEET NO: 513-65E

A1.15

ENLARGED MECHANICAL AND ELECTRICAL ROOM PLANS

SCALE: 1/4" = 1'-0"