


VICINITY MAP

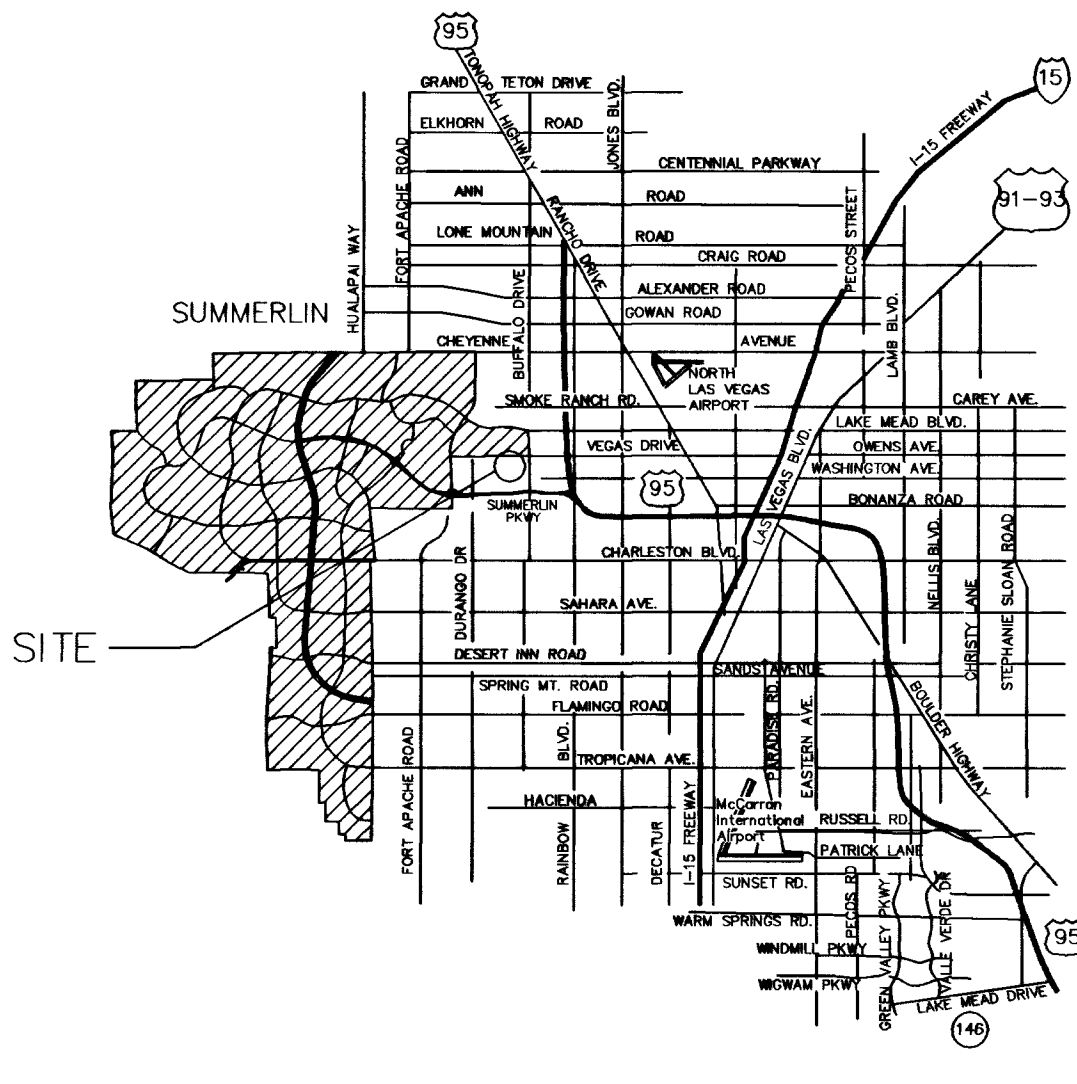

PLANS
LIBRARY *

INDEX OF DRAWINGS

4	G1	COVER SHEET, INDEX OF DRAWINGS
	G2	GENERAL NOTES, CODE STUDY, EXITING PLAN, SYMBOLS
	G3	INDEX OF DRAWINGS & VICINITY MAP
	C-1	CIVIL COVER SHEET
	C-2	GENERAL NOTES & QUANTITIES
	C-3	SURVEY CONTROL PLAN
	C-4	SITE PLAN - ON-SITE DRAINAGE & STRIPING
	C-5	HORIZONTAL CONTROL PLAN
	C-6	MASTER UTILITY PLAN
	C-7	GRADING PLAN
	C-8	PLAN & PROFILE - (WASHINGTON AVE.)
	C-9	TRAFFIC SIGNAGE, STRIPING & STREET LIGHTING - (WASHINGTON AVE.)
	C-10	EMERGENCY SIGNAL FLASHER
	C-11	CONSTRUCTION DETAILS I
	C-12	CONSTRUCTION DETAILS II
	C-13	CONSTRUCTION DETAILS III
	C-14	CONSTRUCTION DETAILS IV
	C-15	CONSTRUCTION DETAILS V
	C-16	CONSTRUCTION DETAILS VI
	C-17	CONSTRUCTION DETAILS VII
	C-18	JOINTING PLAN
	C-19	SITE SECTIONS
	C-ES.1	ON-SITE ELECTRICAL PLAN
	SP-1	SPRINT DRAWING
	NP-1	NEVADA POWER DRAWING
	L1	IRRIGATION PLAN
	L2	LANDSCAPE PLAN
	L3	IRRIGATION DETAILS
	L4	PLANTING DETAILS
	A11	NOTED FLOOR PLAN
	A12	DIMENSION FLOOR PLAN
	A13	FLOORING PLAN
	A2	BUILDING SECTIONS
	A3	ROOF PLAN
	A4.1	EXTERIOR BUILDING ELEVATIONS
	A4.2	EXTERIOR BUILDING ELEVATIONS
	A5	REFLECTED CEILING PLAN
	A6	DOOR & WINDOW SCHEDULES / ROOM FINISH SCHEDULE
	A7	DOOR & WINDOW DETAILS
	A8.1	INTERIOR ELEVATIONS & TOILET ACCESSORY SCHEDULE
	A8.2	INTERIOR ELEVATIONS
	A9.1	ENLARGED WALL SECTIONS
	A9.2	ENLARGED WALL SECTIONS
	A10.1	DETAILS
	A10.2	DETAILS
	A10.3	DETAILS
	A10.4	DETAILS
	A10.5	DETAILS
	A10.6	DETAILS
	A10.7	DETAILS
	A10.8.1	1 HR. RATED GREASE SHAFT UL LISTINGS, SPEC'S. & DETAILS PAGE 1
	A10.8.2	1 HR. RATED GREASE SHAFT UL LISTINGS, SPEC'S. & DETAILS PAGE 2
	A10.8.3	1 HR. RATED GREASE SHAFT UL LISTINGS, SPEC'S. & DETAILS PAGE 3
	A10.9	DETAILS
	S1.0	GENERAL STRUCTURAL NOTES
	S1.1	GENERAL STRUCTURAL NOTES
	S2.0	FOUNDATION PLAN
	S3.0	ROOF FRAMING PLAN
	S4.0	CMU WALL ELEVATION, KEY PLAN
	S4.1	CMU WALL ELEVATION
	S4.2	CMU WALL ELEVATION
	S4.3	CMU WALL ELEVATION
	S4.4	CMU WALL ELEVATION
	S4.5	CMU WALL ELEVATION
	S4.6	CMU WALL ELEVATION
	S4.7	CMU WALL ELEVATION
	SD1	FOUNDATION DETAILS
	SD1.1	FOUNDATION DETAILS
	SD2	TYPICAL DETAILS
	SD2.1	TYPICAL DETAILS
	SD3	FRAMING DETAILS
	SD3.1	FRAMING DETAILS
	SD3.2	FRAMING DETAILS
	SD3.3	FRAMING DETAILS
	M-01	MECHANICAL NOTES
	M-02	ATTIC HVAC PLAN
	M-03	ROOF HVAC PLAN
	M-04	REFLECTED CEILING HVAC PLAN
	M-05	VEHICLE EXHAUST PLAN
	M-06	MECHANICAL DETAILS
	M-07	MECHANICAL DETAILS
	F-01	PLUMBING NOTES
	F-02	ROOF PLUMBING PLAN
	F-03	PLUMBING PLAN
	F-04	PLUMBING DETAILS
	F-05	PLUMBING DRAIN, WASTE AND VENTILATION
	F-06	PLUMBING SECTIONS
	F-07	MECHANICAL SITE PLAN
	F-08	PLUMBING DETAILS
	F-09	PLUMBING DETAILS
	FP-01	FIRE PROTECTION PLAN

INDEX OF DRAWINGS

EN1	LIGHTING FIXTURE SCHEDULE, SYMBOLS, GENERAL NOTES
EN2	SINGLE LINE DIAGRAM, PANEL SCHEDULES
EN3	PANEL SCHEDULES
E-1.1	ELECTRICAL LIGHTING PLAN
E-1.2	ELECTRICAL C.A.D. LIGHTING PLAN
E-2.1	ELECTRICAL POWER PLAN
E-3.1	ELECTRICAL HVAC PLAN
E-4.1	ELECTRICAL COMMUNICATION PLAN
E-5.1	ELECTRICAL FIRE ALARM PLAN
E-6.1	DETAILS
E-6.2	DETAILS
E-6.3	DETAILS
E-6.4	CAD DRAWING



REVISIONS
4 Per Architect 10/24/01

CONSULTANT

CITY OF LAS VEGAS, NEVADA
FIRE STATION #44

Index of Drawings & Vicinity Map

RECORD DRAWING

STAMP

OWNER: CITY OF LAS VEGAS
DEPARTMENT OF PUBLIC WORKS
ARCHITECTURAL SERVICES

400 EAST STEWART AVENUE
LAS VEGAS, NEVADA 89101
PHONE: (702) 229-6535
FAX: (702) 382-3232
TDD: (702) 386-9108

DRAWN EP8

FILE 1644-G3

DATE 10/29/01

SCALE N/A

GRID NO 02.1534102

CLV DWG NO 630.97

3 OF 106

SHT NO

G3