


# DEPARTMENT OF PUBLIC WORKS

## OFFICE OF ARCHITECTURAL SERVICES

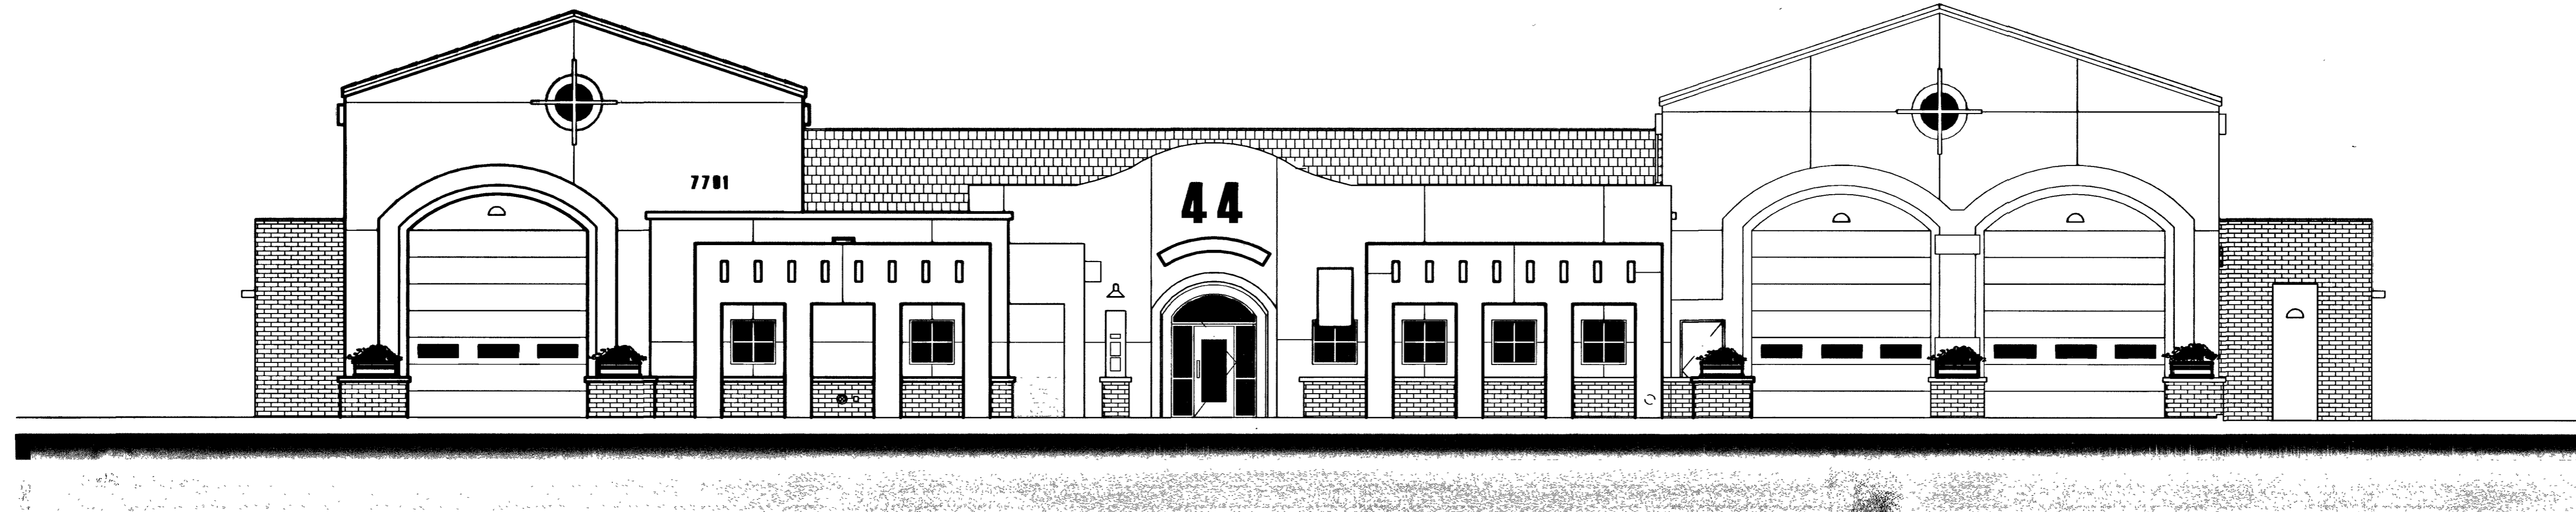

Mayor:  
OSCAR B. GOODMAN

CITY OF LAS VEGAS FIRE DEPARTMENT

City Council:  
GARY REESE  
(Mayor Pro-Tem)  
MICHAEL J. McDONALD  
LARRY BROWN  
LYNETTE B. McDONALD  
LAWRENCE WEEKLY  
MICHAEL MACK

# Fire Station #44

BID NO. 02.15341.02

City Manager:  
VIRGINIA VALENTINE

APPROVED BY: \_\_\_\_\_ DATE: \_\_\_\_\_

Director of Public Works:  
RICHARD D. GOECKE

David Washington, Fire Chief  
City of Las Vegas Fire Department

Deputy Director of Public Works:  
K. JOHN MCNELLIS, P.E.



**RECORD DRAWING**

REVISIONS


CONSULTANT


CITY OF LAS VEGAS, NEVADA  
FIRE STATION #44  
Cover Sheet

OWNER: CITY OF LAS VEGAS  
DEPARTMENT OF PUBLIC WORKS  
ARCHITECTURAL SERVICES

400 EAST STEWART AVENUE LAS VEGAS, NEVADA 89101
PHONE: (702) 229-6535
FAX: (702) 382-3232
TDD: (702) 386-9108

DRAWN	EP6
FILE	fs44-G1
DATE	10/25/01
SCALE	N/A
BID NO	02.15341.02
CITY DWG NO	630.97
1 OF 106	
SHEET NO	G1