


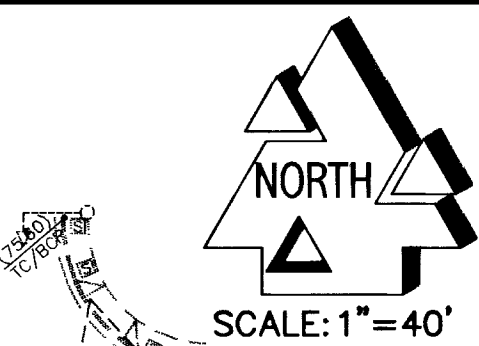

RECORD DRAWINGS
AS-BUILT INFORMATION WAS
PROVIDED BY THE
CONTRACTOR. AZTEC
ASSUMES NO LIABILITY FOR
ACCURACY OF IT'S
CONTENTS.


SIGNED ON 9-27-2001

LAS VEGAS VALLEY WATER DISTRICT DATE

HORIZ. 1" = 40'
VERT. 1" = 4'



PROJ NO:	AZ01002
DESIGN:	RAC/LG
DATE:	04/22/03
SCALE:	AS SHOWN
FILE:	FS44_08

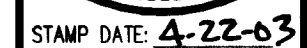

SHEET
C-8
OF 20 SHEETS
DRAWING NO.
630.97