




1 Shower Detail  
Scale: 1/2"=1'-0"  
A10-9-1

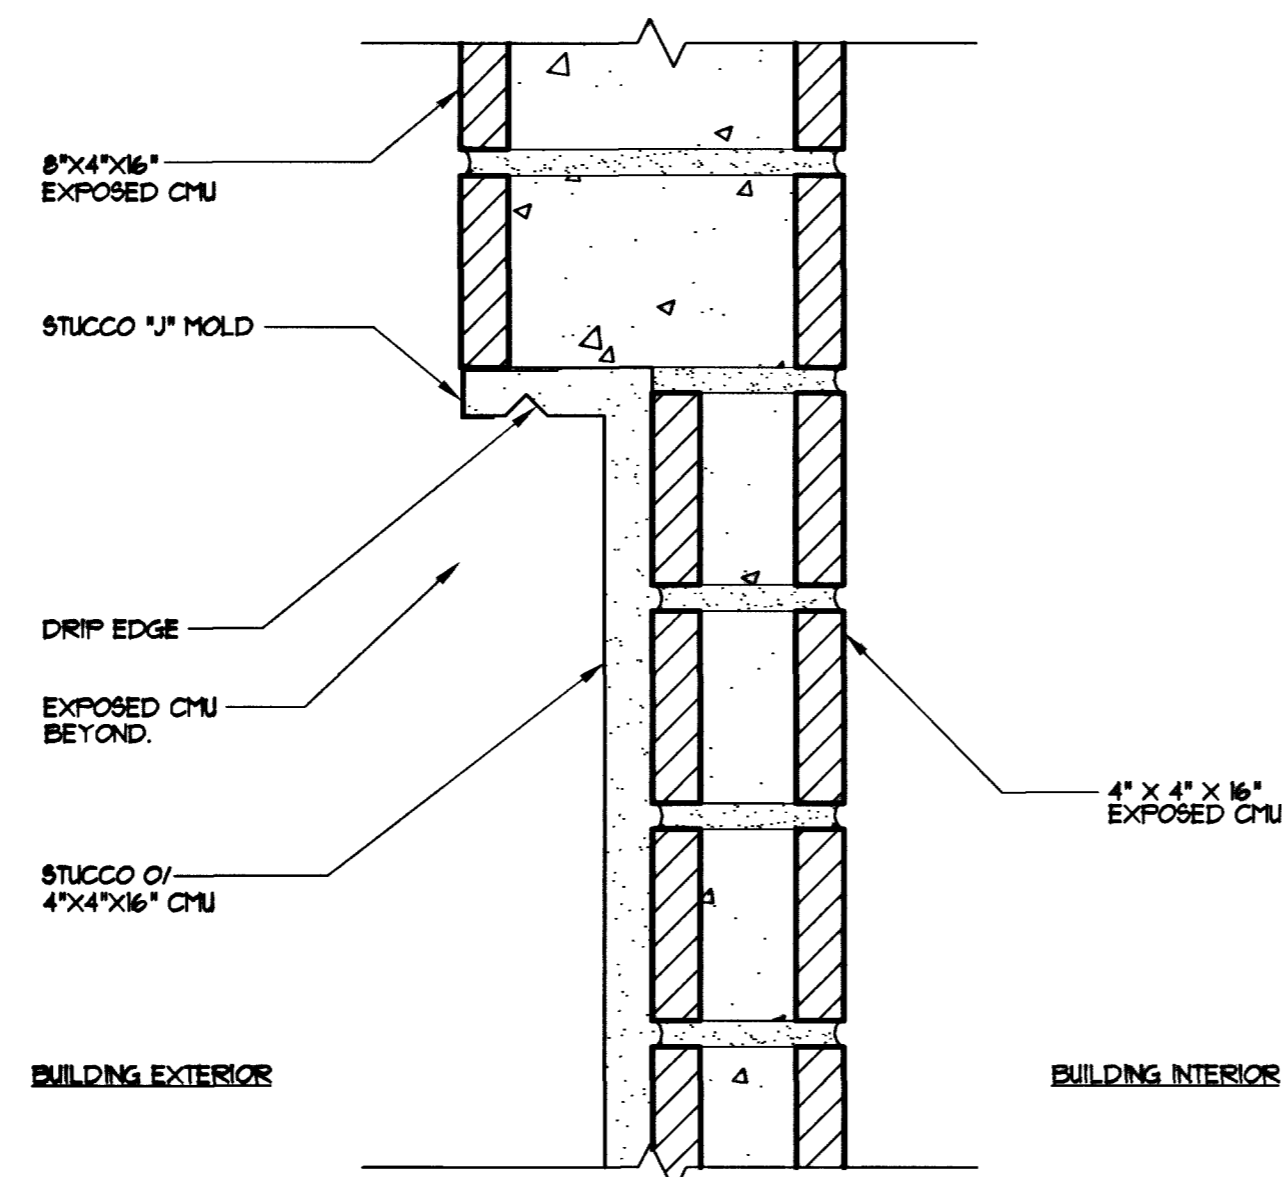


2 Head Dtl @ CMU Niche  
Scale: 3/4"=1'-0"  
A10-9-2

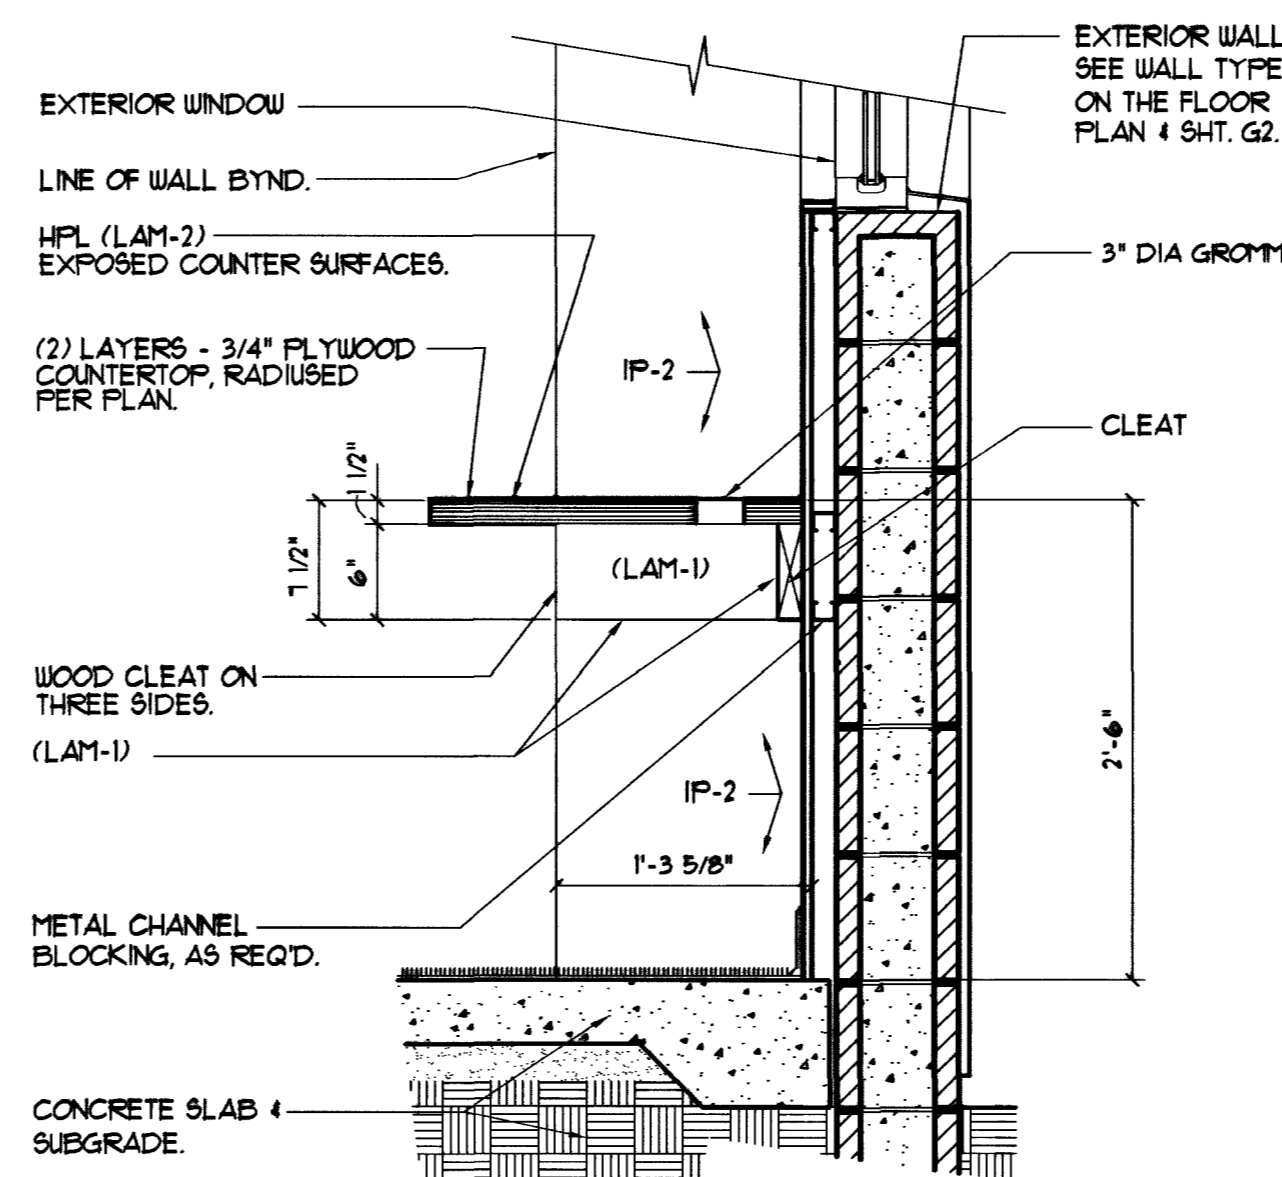


3 Study Desk Dtl.  
Scale: 1/2"=1'-0"  
A10-9-3

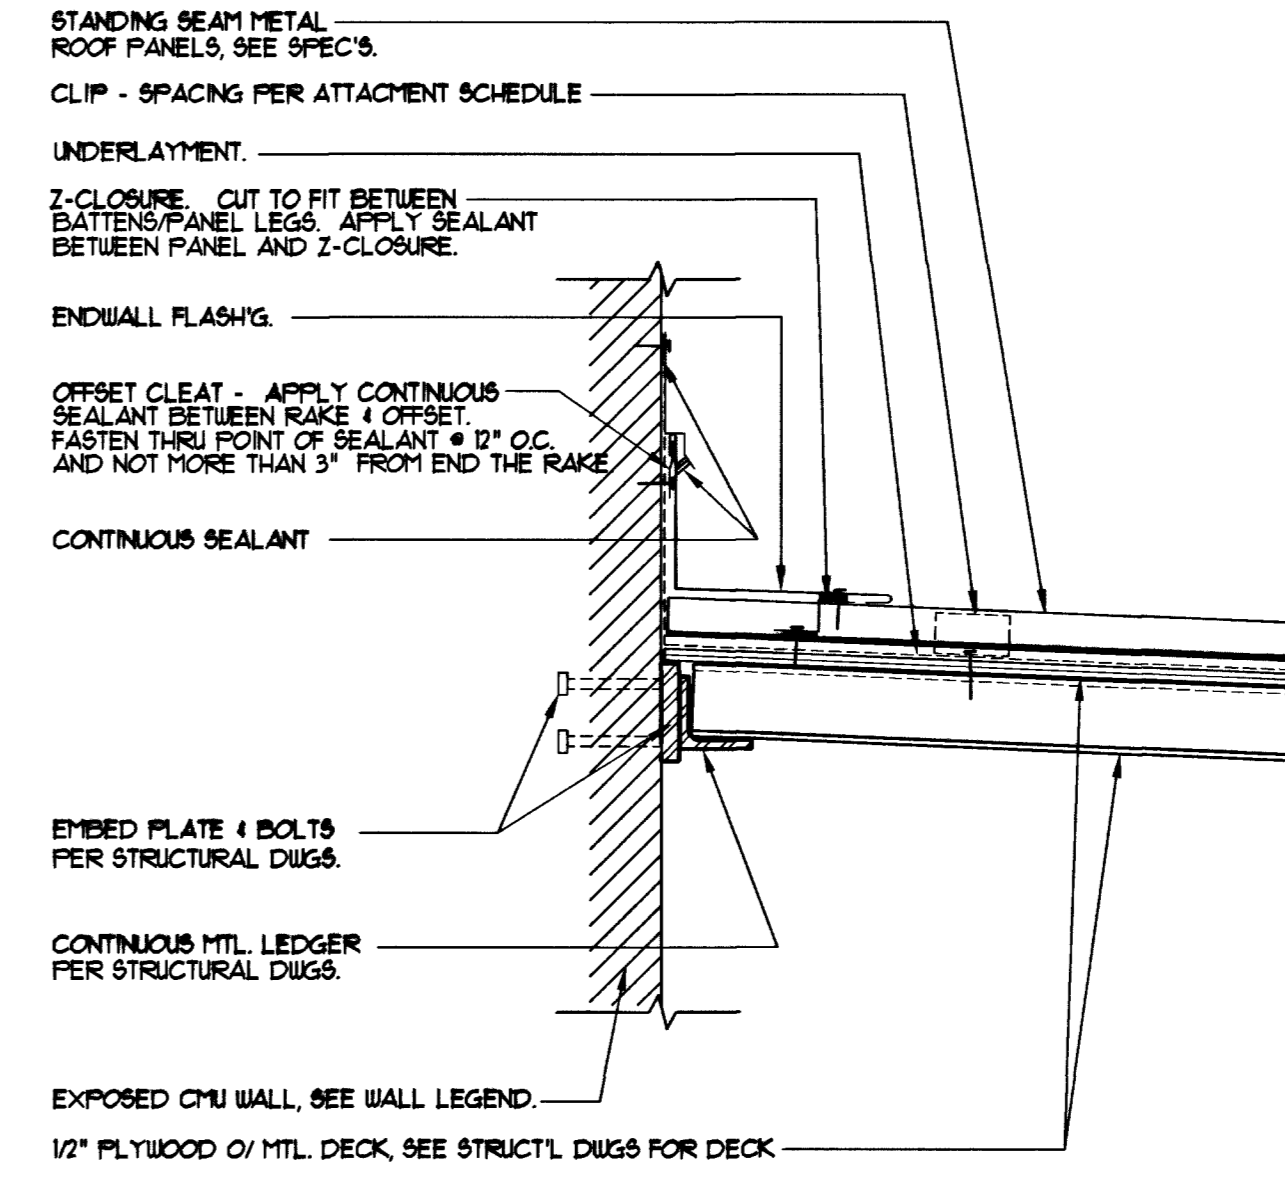


4 Endwall Detail @ S.S. Roof  
Scale: 1/2"=1'-0"  
A10-9-4R

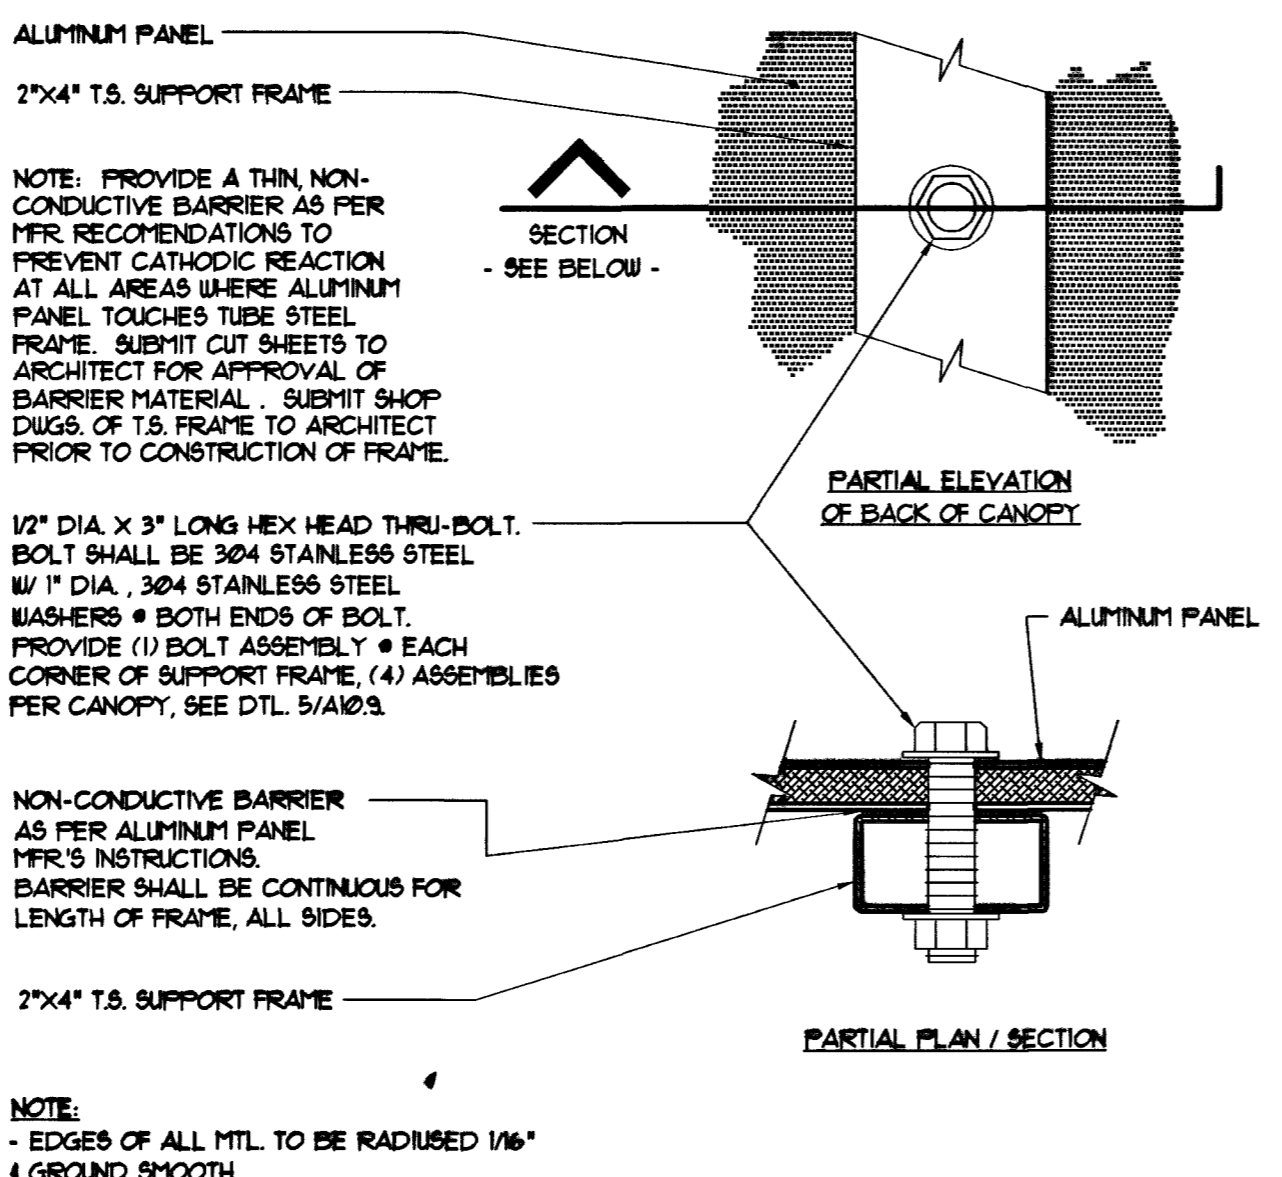


5 Canopy Support Connection  
Scale: 3/4"=1'-0"  
A10-9-5

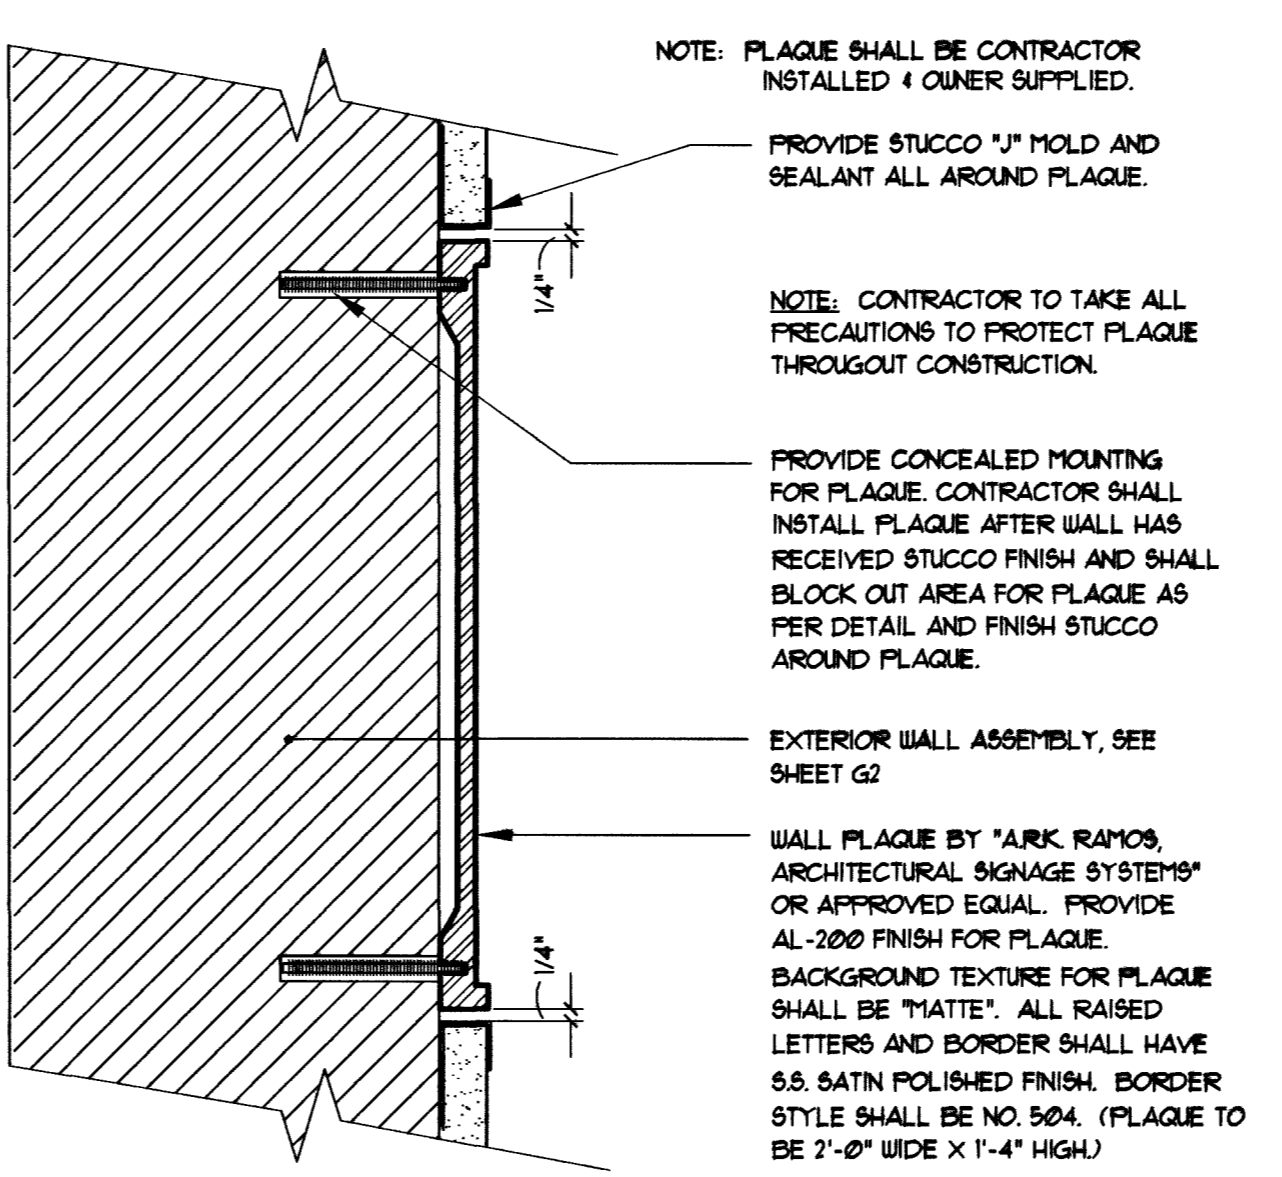


6 Plaque Mounting Dtl.  
Scale: 3/4"=1'-0"  
A10-9-6

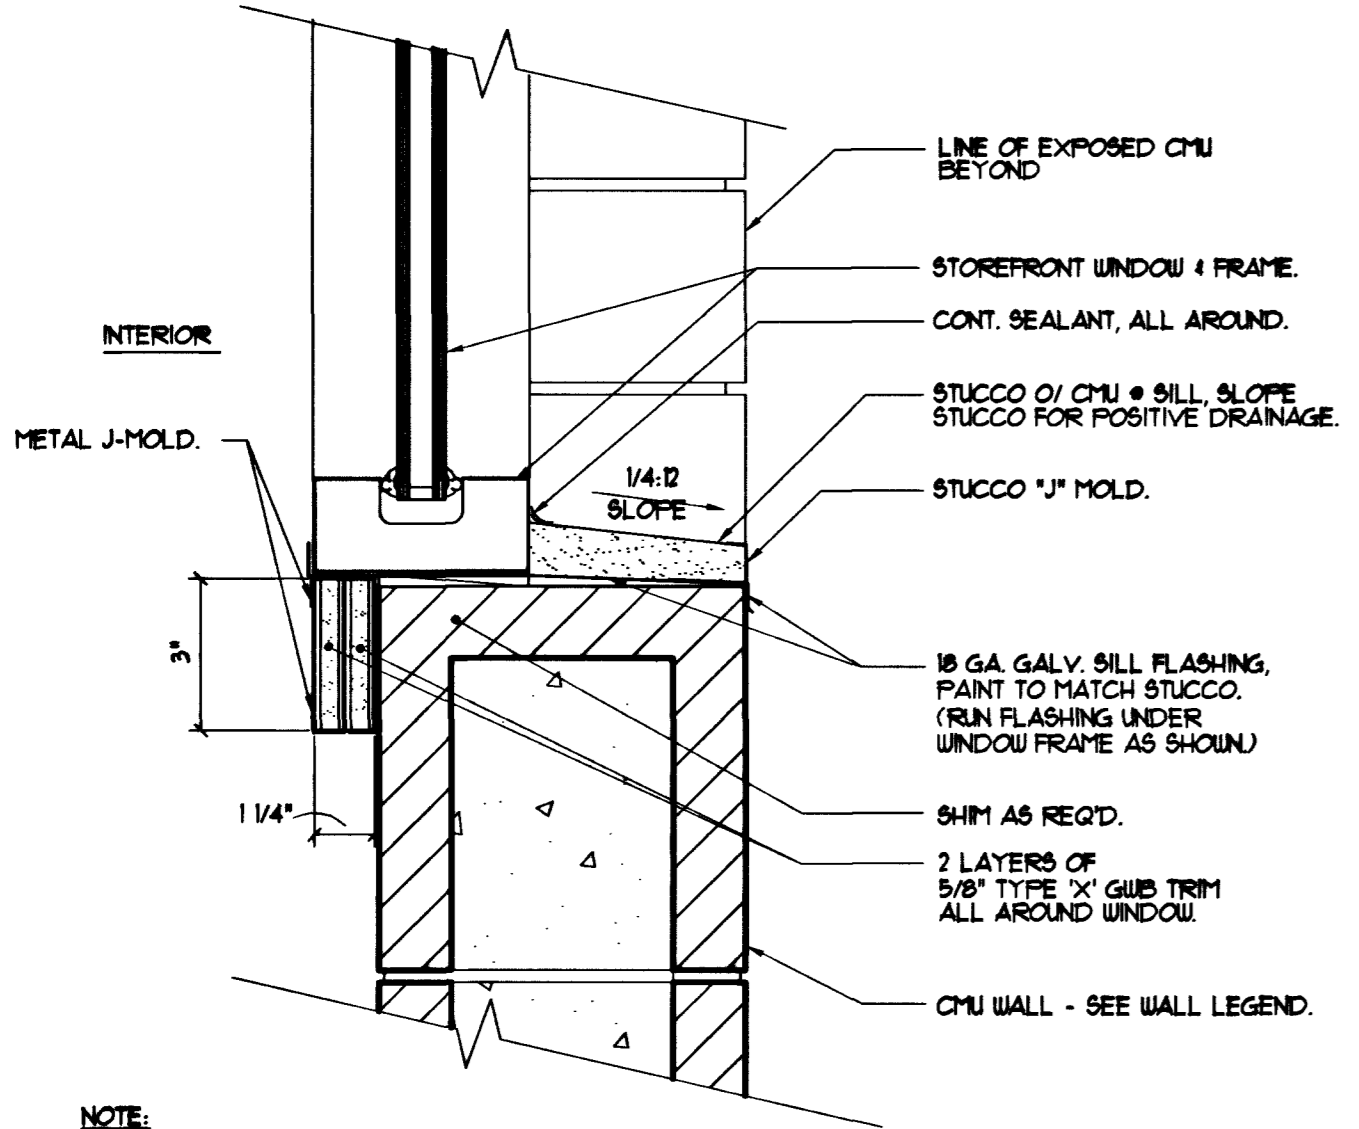


8 Exterior Window Sill Detail  
Scale: 3/4"=1'-0"  
A10-9-8  
57276

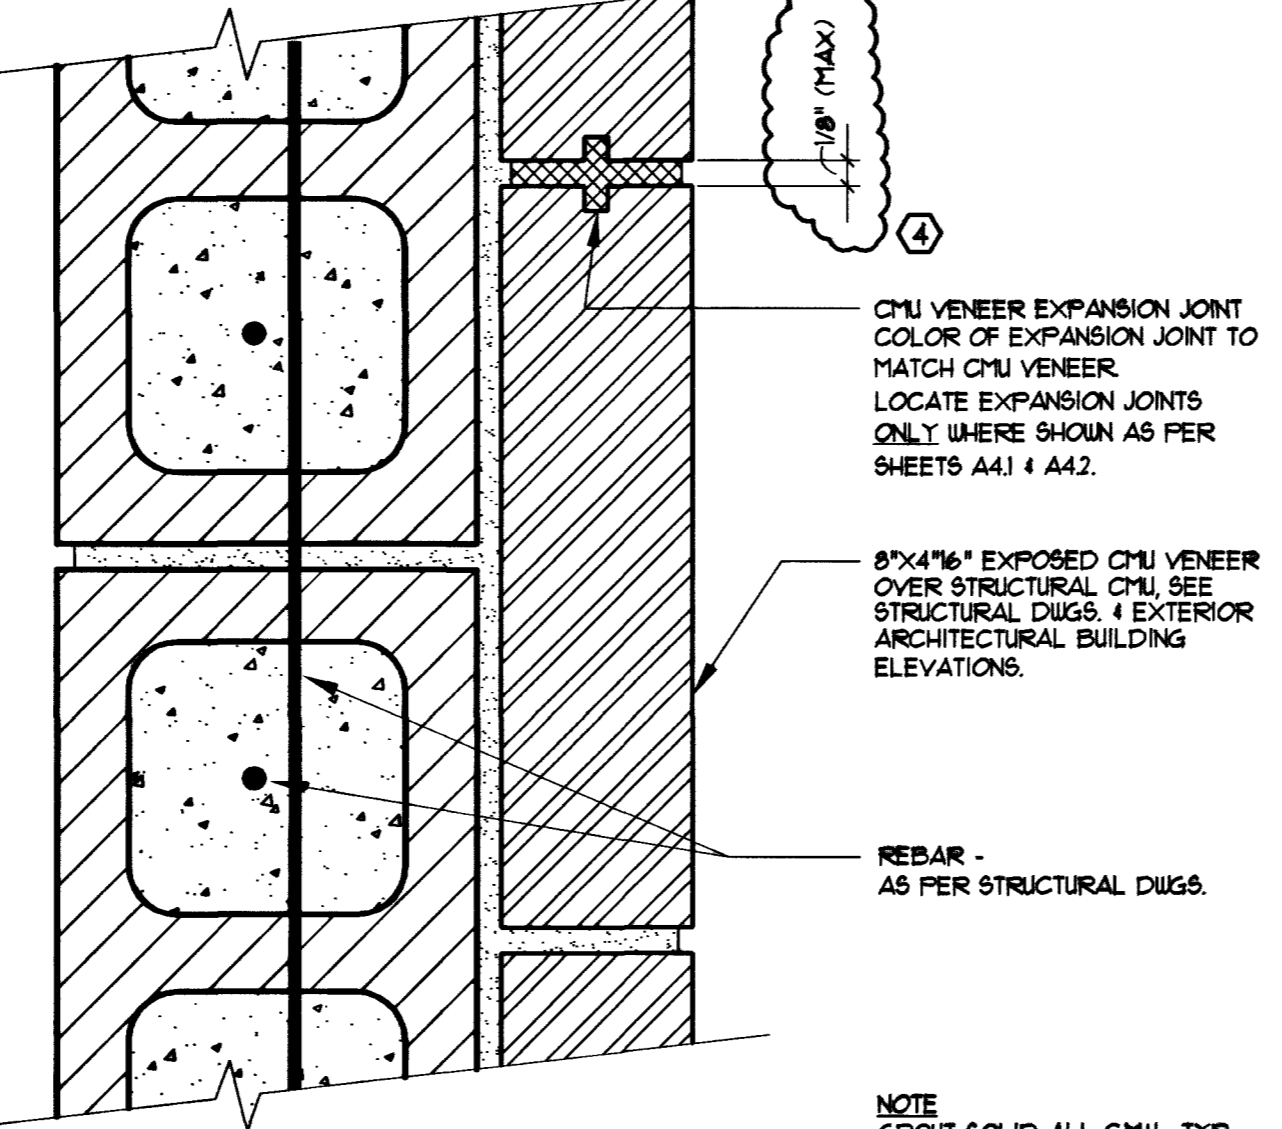

9 Exposed Masonry Veneer Joint  
Scale: 3/4"=1'-0"  
A10-9-9

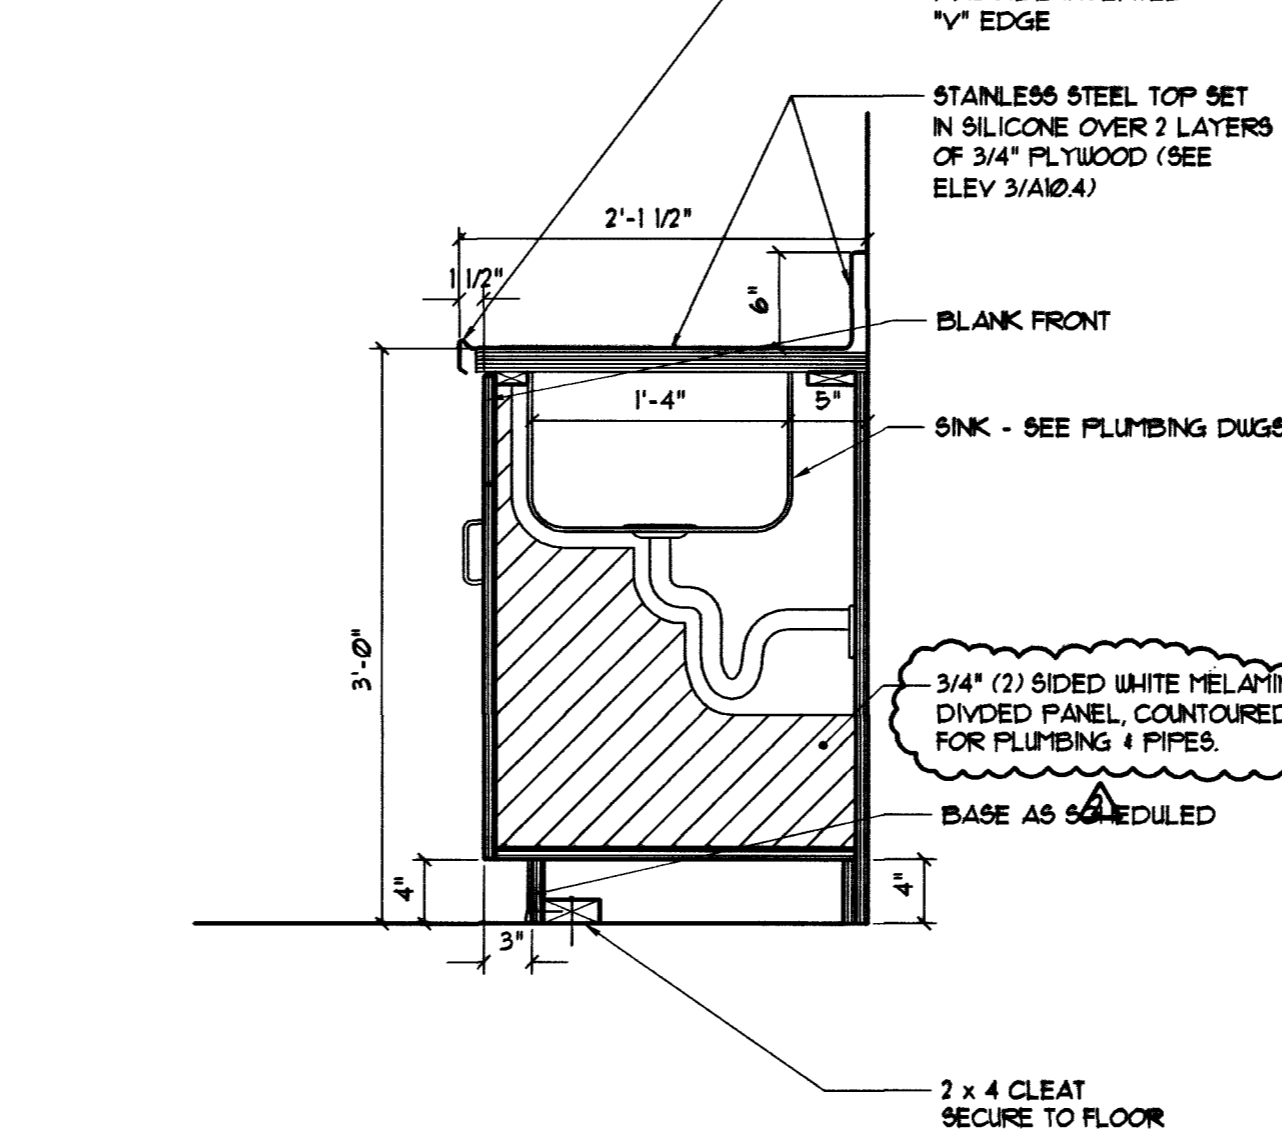

10 Cabinet @ Kitchen Sink Detail  
Scale: 1/2"=1'-0"  
A10-9-10R

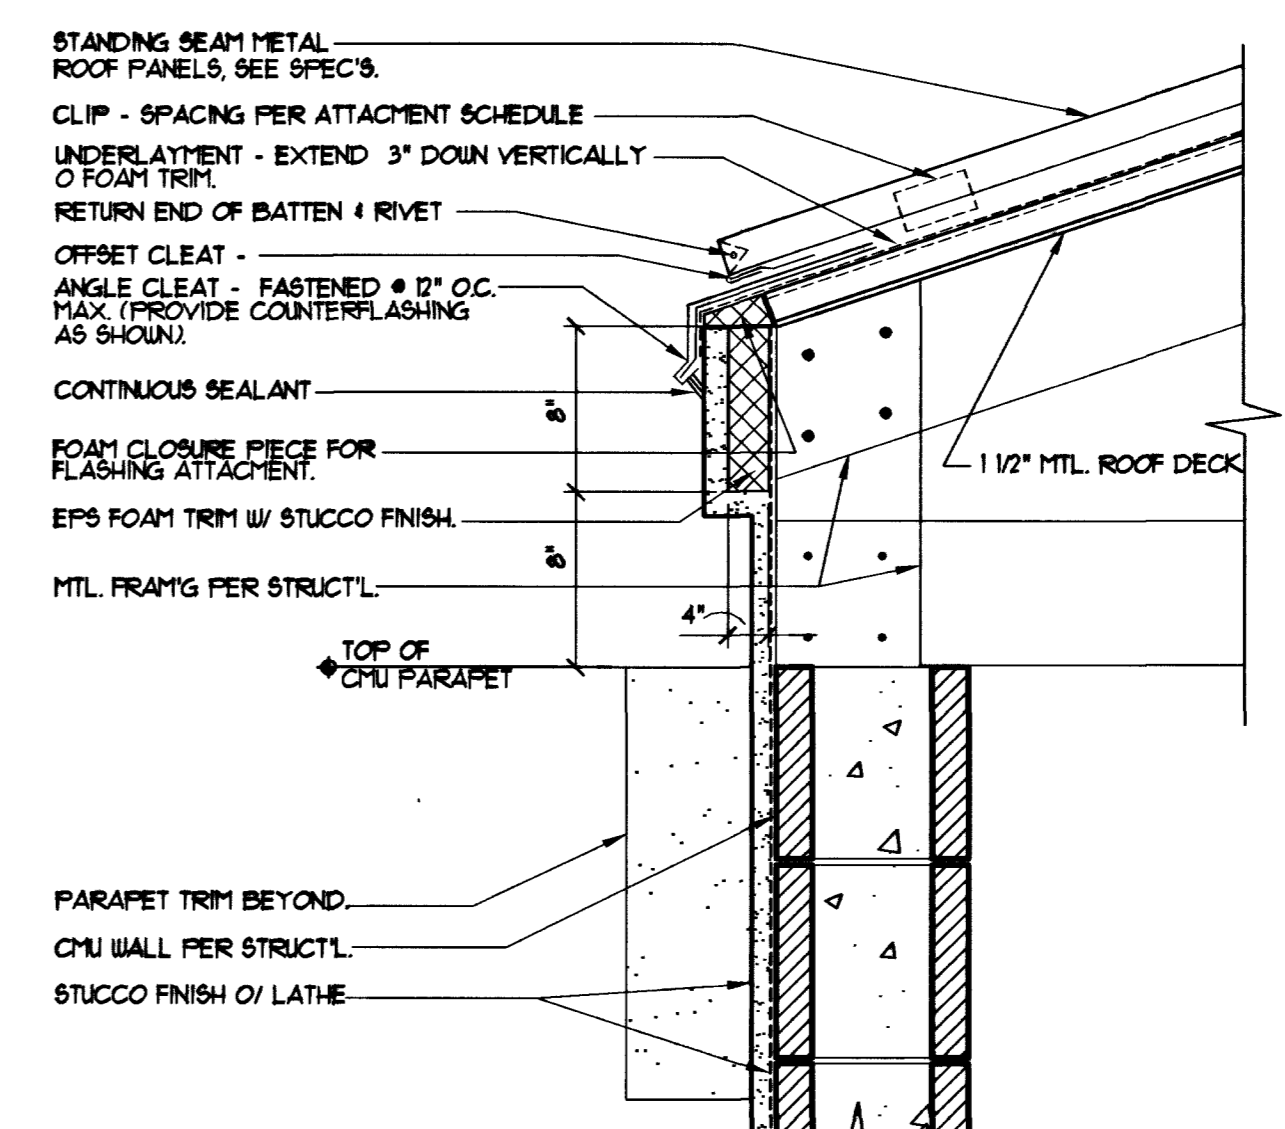

11 Eave Flash'g @ Standing Seam Roof  
Scale: 1/2"=1'-0"  
A10-9-11



REVISIONS  
 Per Architect - 10/24/01  
 Per Owner - 10/16/01

CONSULTANT

CITY OF LAS VEGAS, NEVADA  
 FIRE STATION #44

DEPARTMENT OF PUBLIC WORKS

OWNER: CITY OF LAS VEGAS  
 DEPARTMENT OF PUBLIC WORKS  
 ARCHITECTURAL SERVICES

400 EAST STEWART AVENUE  
 LAS VEGAS, NEVADA 89103  
 PHONE: (702) 229-6535  
 FAX: (702) 382-3332  
 TDD: (702) 386-9108

54 OF 106

A10.9

RECORD DRAWING

Details