



REVISIONS  
Per Planning Dept. - 1/2/02

CONSULTANT

RECORD DRAWING DEPARTMENT OF PUBLIC WORKS

CITY OF LAS VEGAS, NEVADA  
FIRE STATION #44


Planting Details

OWNER: CITY OF LAS VEGAS  
DEPARTMENT OF PUBLIC WORKS  
ARCHITECTURAL SERVICES


400 EAST STEWART AVENUE  
LAS VEGAS, NEVADA 89101  
PHONE: (702) 229-6535  
FAX: (702) 382-3232  
TDD: (702) 386-9108

DRWN	CLEURB
FILE	1644/1644-L4
DATE	10/01
SCALE	As noted
BID NO	02.15341.02
CLV DWG NO	630.91
	29 OF 106
SHT NO	


L4

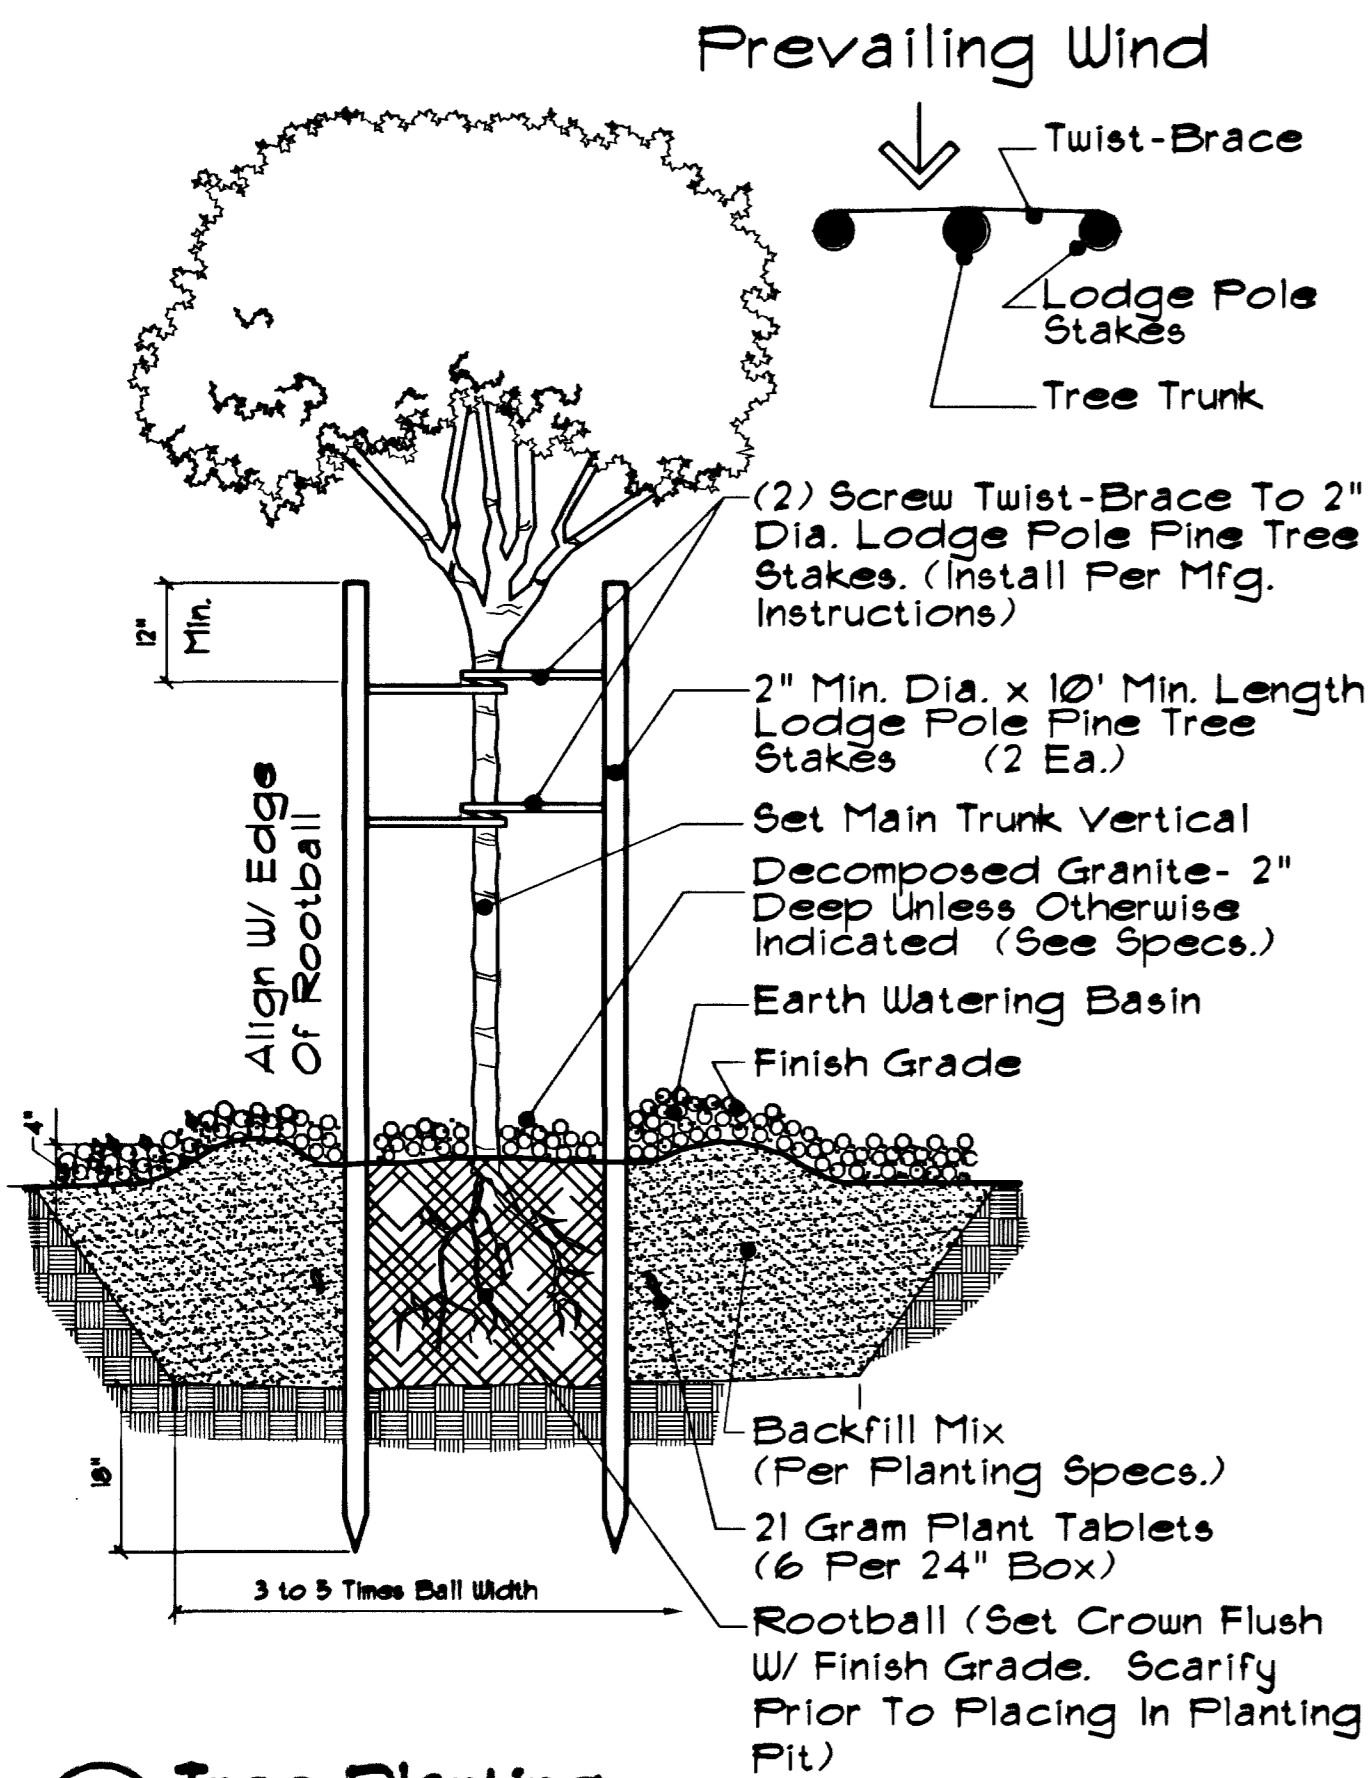


**1 Tree Planting**  
Scale: N.T.S. 02300-02 L4-01

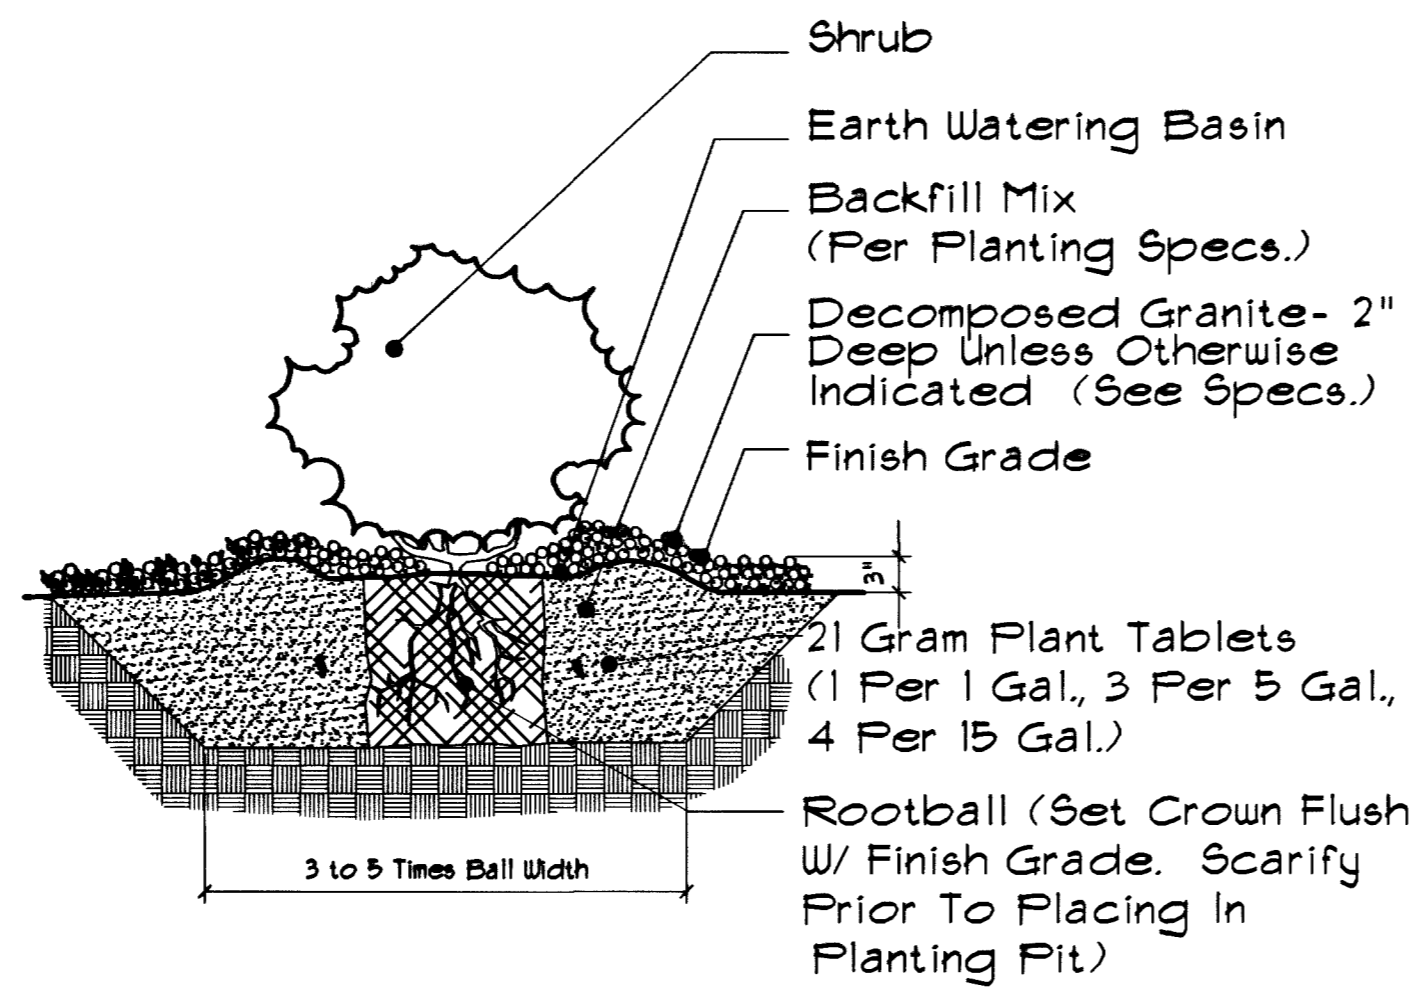

**2 Shrub Planting**  
Scale: N.T.S. 02300-03 L4-02

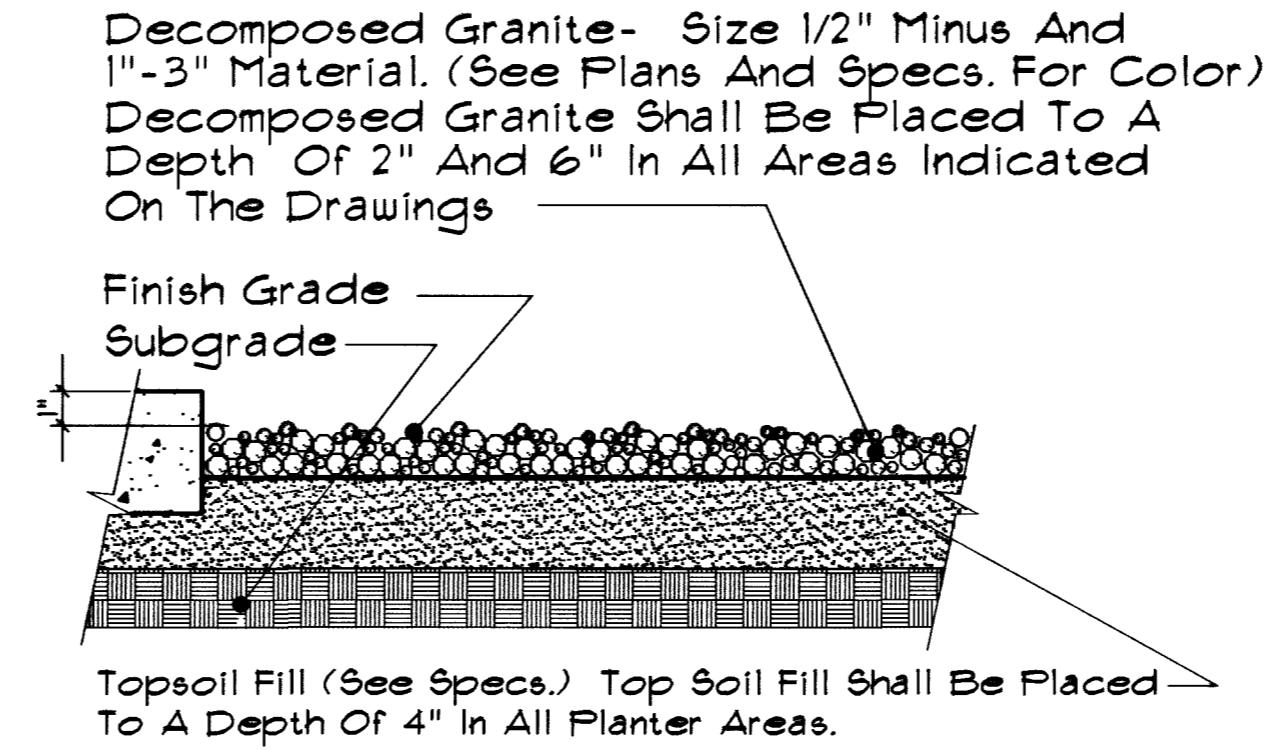


**3 Topsoil / Decomposed Granite**  
Scale: N.T.S. 02300-04 L4-03

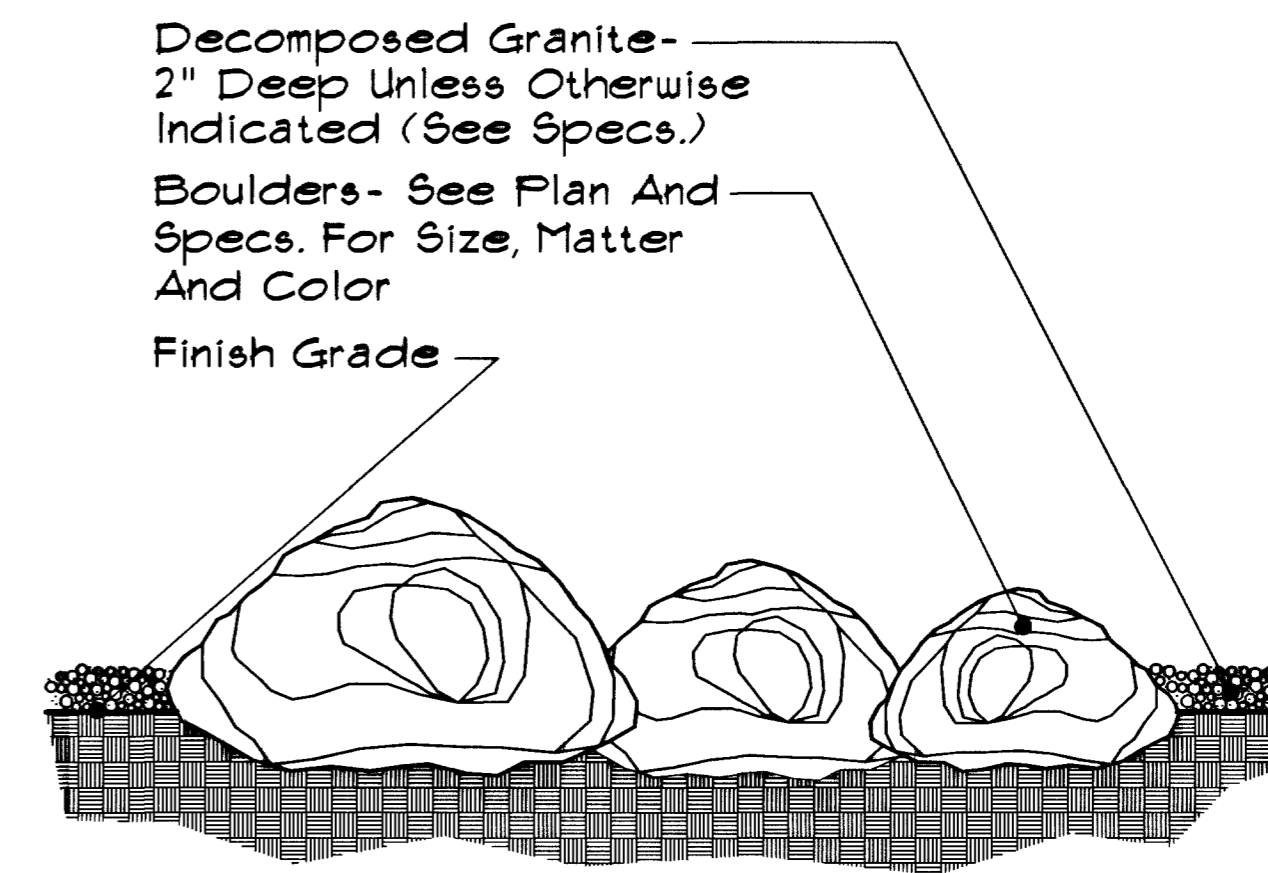

**4 Boulder**  
Scale: N.T.S. 02300-01 L4-04

NOTE: Compact Subgrade To 80% And Apply A Preemergent Herbicide To The Soil Before Placing Granite At Required Depth. Rake Smooth, Wet To Entire Depth, Roll With A 150lb Roller, Then Lightly Scarify Surface With A Leaf Rake. Keep Top Of Granite 1" Below Adjacent Walks, Curbs Or Other Hard Surfaces.

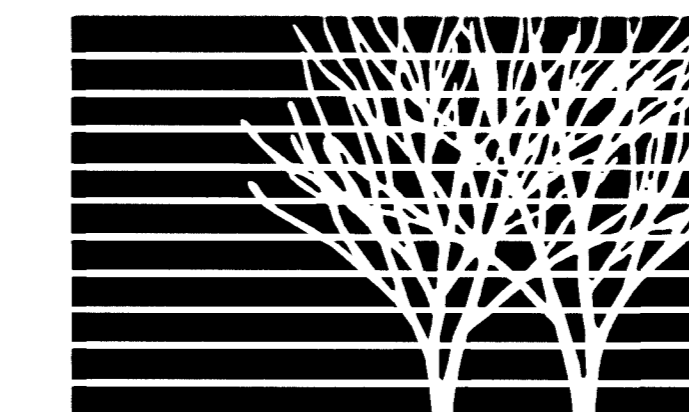

Avoid cutting underground utility lines. It's costly.  
Call before you Dig.  
1-800-227-2600

57251