

**Landscape Plan**

Scale: 1"=20'-0"



**PLANT SCHEDULE**

SYMBOL	QTY.	SIZE	BOTANICAL NAME	COMMON NAME	COMMENTS
<b>TREES</b>					
	25	24" BOX	CERCIDUM FLORIDUM	BLUE PALO VERDE	2" MIN. CAL.
	16	24" BOX	CHITALPA TRASHKENTENAS	CHITALPA	1-3/4" MIN. CAL.
	21	24" BOX	QUERCUS ILEX 'HERITAGE'	HERITAGE OAK	2" MIN. CAL.
	18	24" BOX	VITEX AGNUS-CASTUS	CHASTE TREE	1-3/4" MIN. CAL.
<b>SHRUBS &amp; GROUNDCOVER</b>					
	52	5 GAL.	BACCHARIS 'CENTENNIAL'	CENTENNIAL BROOM	FULL & BUSHY
	26	15 GAL.	CAESALPINIA FULCHERRIMA	RED BIRD OF PARADISE	
	42	5 GAL.	CASSIA PHYLLODENIA	SILVER CASSIA	FULL & BUSHY
	15	5 GAL.	DASYLIRION ACROTRICHE	GREEN DESERT SPOON	
	15	6'-8' CANES	FOUQUIERIA SPLENDENS	OCOTILLO	
	36	5 GAL.	HESPERALOE PARVIFLORA 'YEL.'	YELLOW YUCCA	
	100	1 GAL.	LANTANA CAMARA 'RADIATION'	RED/ORANGE LANTANA	FULL & BUSHY
	72	1 GAL.	LANTANA CAM. 'YELLOW TRAILING'	YELLOW TRAILING LANTANA	FULL & BUSHY
	80	1 GAL.	LANTANA MONTEVIDENSIS	TRAILING LANTANA	FULL & BUSHY
	33	5 GAL.	LEUCOPHYLLUM FRUT. 'GRN. CLOUD'	GREEN CLOUD TEX. RANGER	FULL & BUSHY
	60	5 GAL.	MUHLENBERGIA CAP. 'REGAL MIST'	REGAL MIST DEER GRASS	FULL & BUSHY
	10	5 GAL.	MYRTUS COMMUNIS 'COMPACTA'	DWARF MYRTLE	FULL & BUSHY

PLANTING AREAS: DECOMPOSED GRANITE SHALL BE INSTALLED IN ALL PLANTING AREAS. INSTALL 1/2" MINUS 2" DEEP.

BOULDERS: PINK CORAL GRANITE BOULDERS, SIZE 3' AND 4'. ORIENT FOR BEST APPEARANCE.


**MISCELLANEOUS**

DECOMPOSED GRANITE SOURCE:  
KALAMAZOO MATERIALS INC.  
50 NORTH ALVERON WAY  
TUCSON, ARIZONA 85711  
(602) 795-5910  
(702) 278-8880

PLANT MATERIAL SOURCE:  
MOUNTAIN STATES NURSERY  
10020 WEST GLENDALE AVE.  
P.O. BOX 2500  
LITCHFIELD PARK, ARIZONA 85307  
(800) 840-8503

**PLANTING NOTES:**

- 1) Contractor shall be responsible for all permits, coordination, scheduling, utility verification and damage to other trades and/or utilities, as per contract general conditions.
- 2) Contractor shall verify all site conditions and report any and all discrepancy to the Landscape Architect and Construction Project Representative prior to starting construction.
- 3) Contractor shall verify locations of existing underground utilities prior to start of construction. Call before you Dig 1-800-227-2600.
- 4) Contractor shall limit work areas to that shown on the drawings.
- 5) Contractor shall perform finish grading modifications to areas requiring grading, or as directed by the Construction Project Representative. Grade areas smooth to minimize irregularities and low spots.
- 6) Layout of all plant material in planting areas shall be approved by the Construction Project Representative prior to installation. Coordinate these areas with irrigation layout.
- 7) Plant quantities are for convience only. CONTRACTOR IS RESPONSIBLE TO VERIFY.
- 8) See details and specifications for planting procedures.
- 9) See details and specifications for decomposed granite procedures.
- 10) Contractor shall excavate and remove all caliche encountered during planting operations. Excavate to the required depth as indicated on the drawings. Remove and properly dispose of excavated caliche from site.

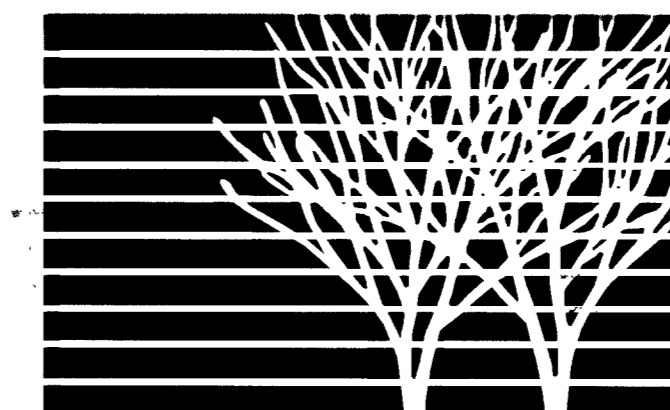

Avoid cutting underground utility lines. It's costly.  
Call before you Dig.  
1-800-227-2600

**RECORD DRAWING**

REVISIONS

1	Per Planning Dept. - 1/2/02

CONSULTANT

CITY OF LAS VEGAS, NEVADA  
 FIRE STATION #44  
 Landscape Plan

OWNER: CITY OF LAS VEGAS  
DEPARTMENT OF PUBLIC WORKS  
ARCHITECTURAL SERVICES

400 EAST STEWART AVENUE LAS VEGAS, NEVADA 89101 PHONE: (702) 229-6335 FAX: (702) 383-3232 TDD: (702) 386-9108
NAME: CLEWS
FILE: F447044-L2
DATE: 10/01
SCALE: 1"=20'-0"
BID NO: 03.15341.02
CLDWG NO: 63097
27 OF 106
SHT NO: L2